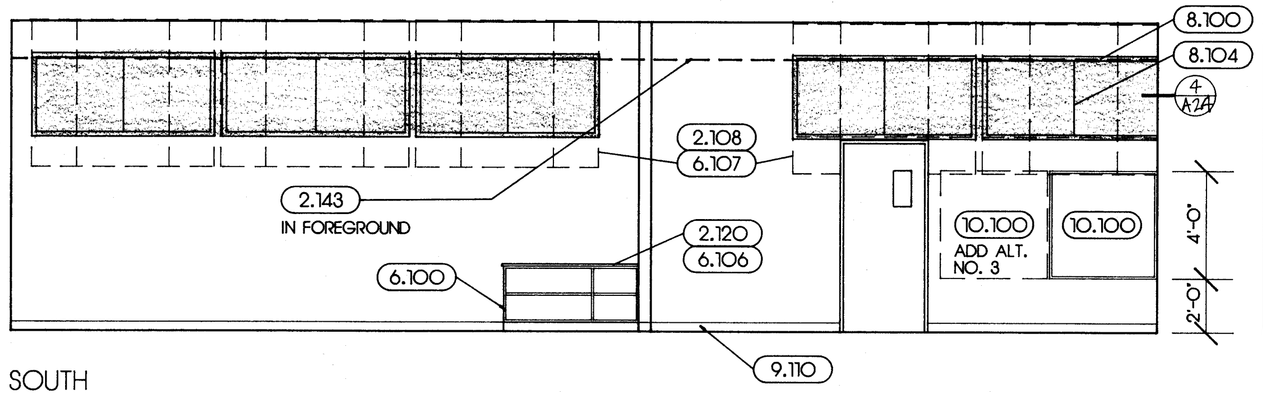

SOUTH

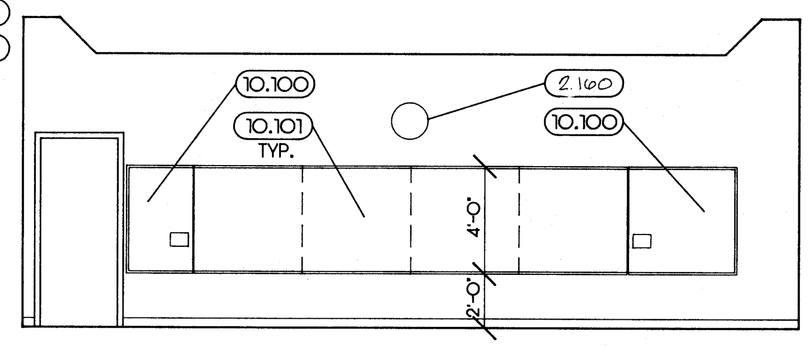

WEST

209 CLASSROOM

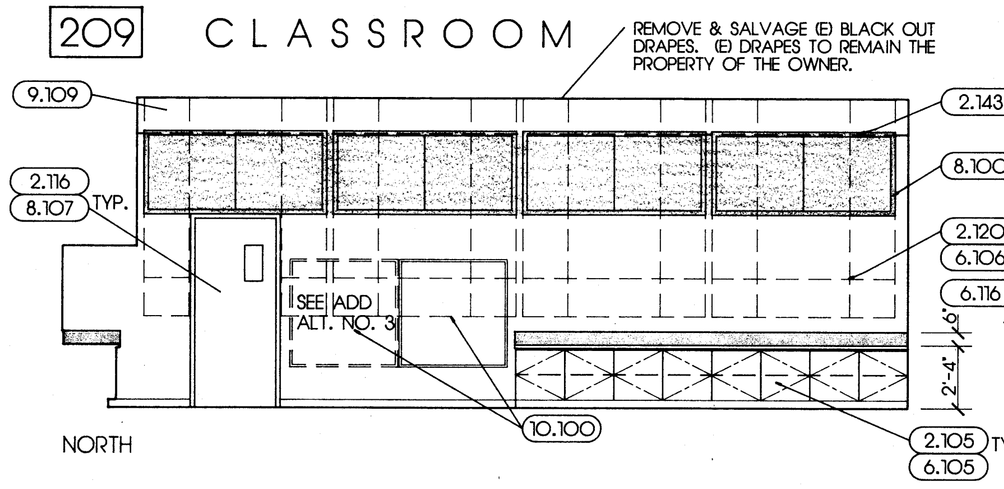

NORTH

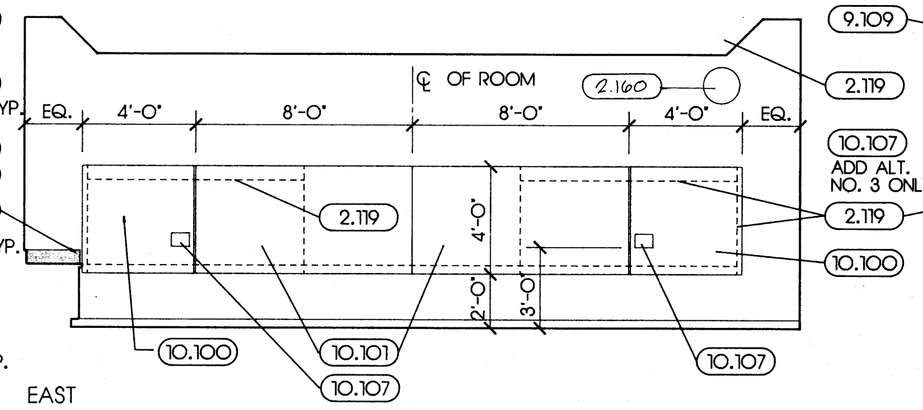

EAST

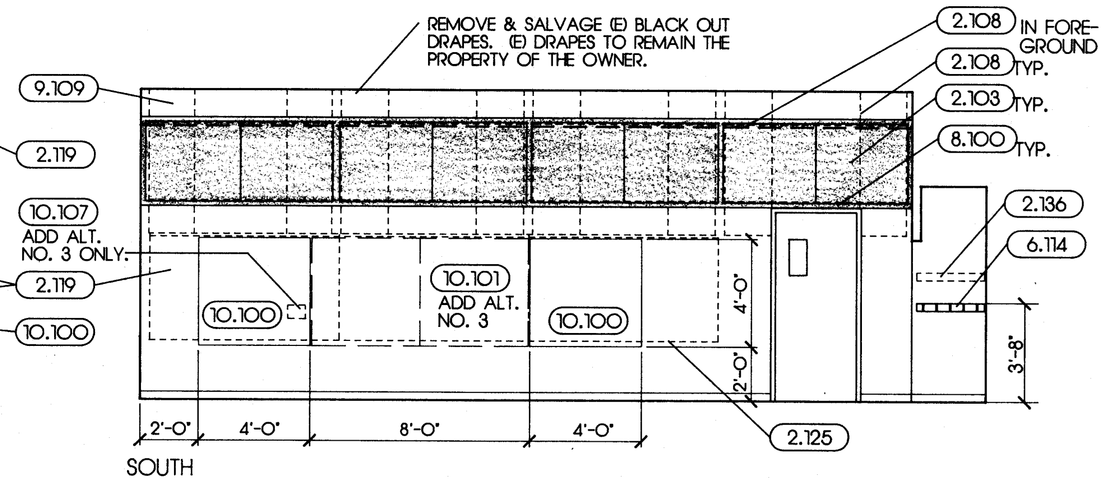

SOUTH

CLASSROOM (TYPICAL FOR BUILDINGS C - G, EXCEPT AS NOTED OTHERWISE)

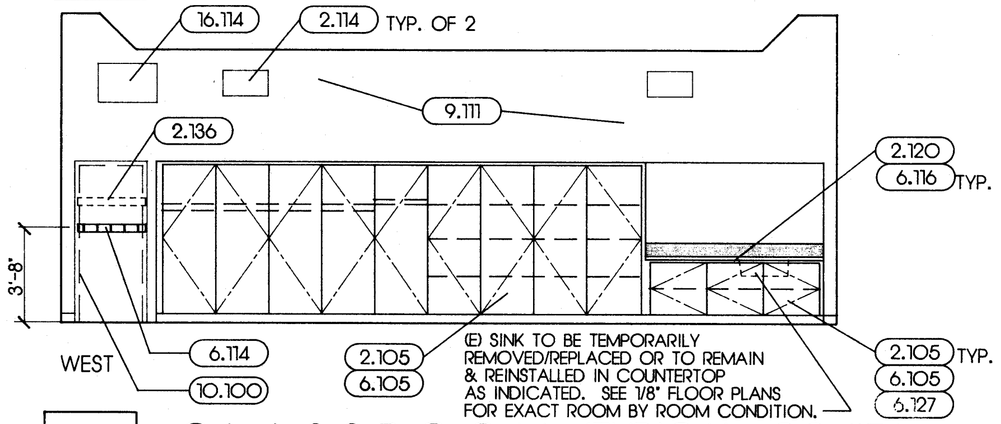

WEST

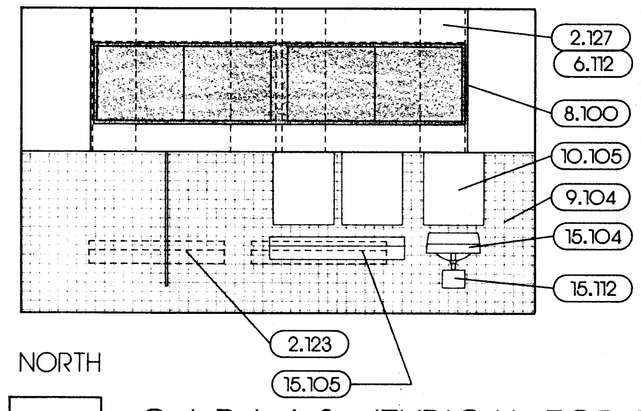

NORTH

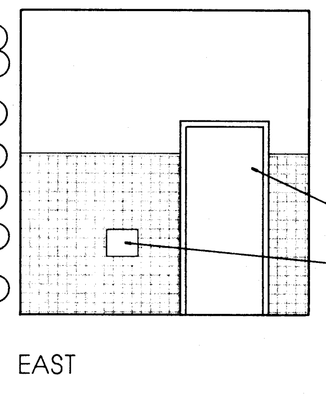

EAST

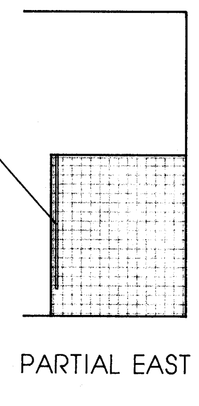

PARTIAL EAST

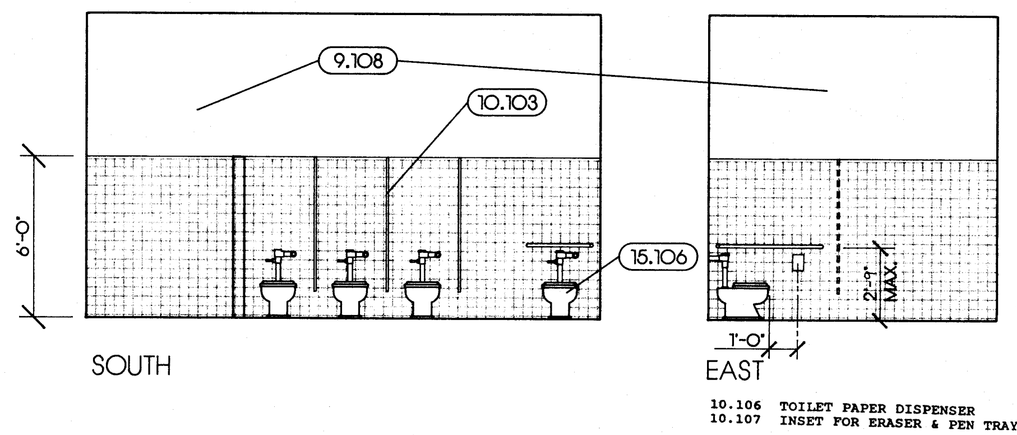

SOUTH EAST

CLASSROOM (TYPICAL, CON'T.)

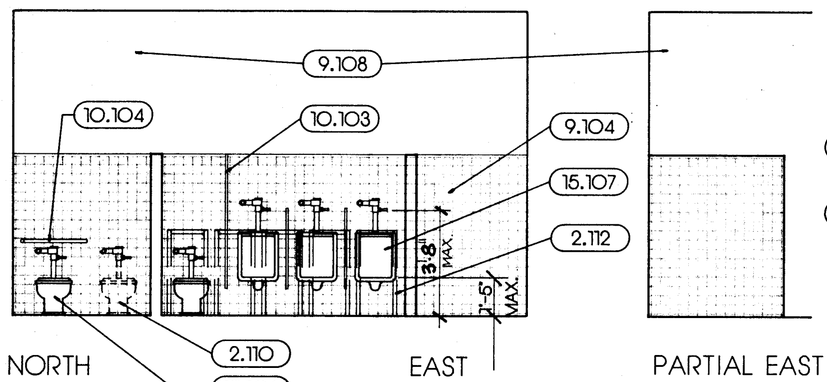

NORTH EAST

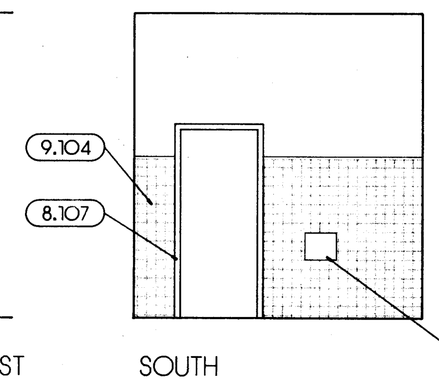

PARTIAL EAST

GIRL'S (TYPICAL FOR BUILDINGS E, F, G)

SOUTH

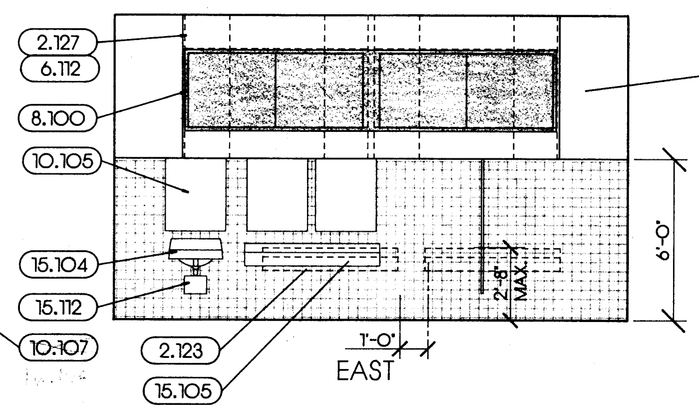

EAST

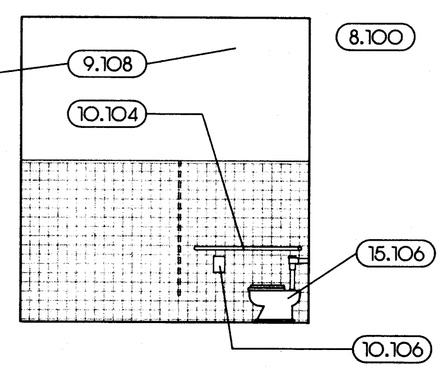

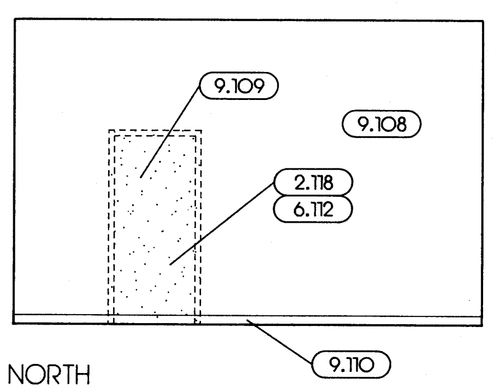

NORTH

BOY'S (TYPICAL FOR BUILDINGS E, F & G)

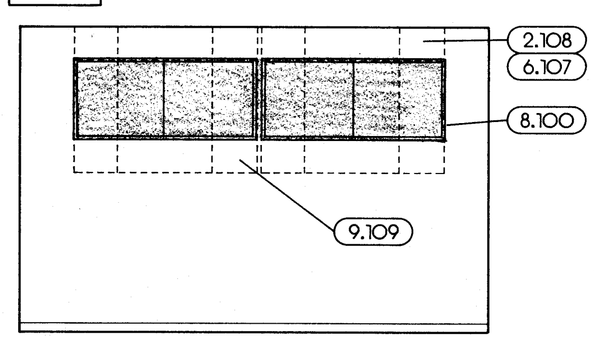

SOUTH

801 STAFF LOUNGE (CON'T.)

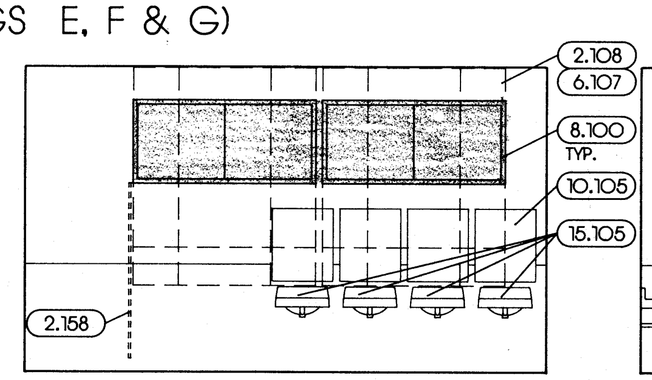

NORTH

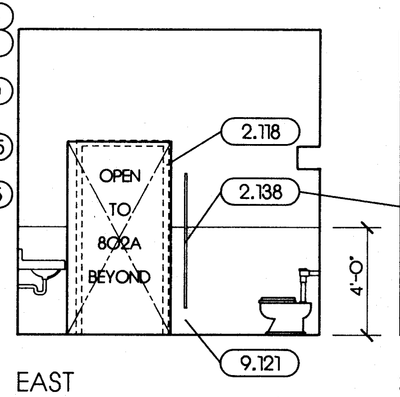

EAST

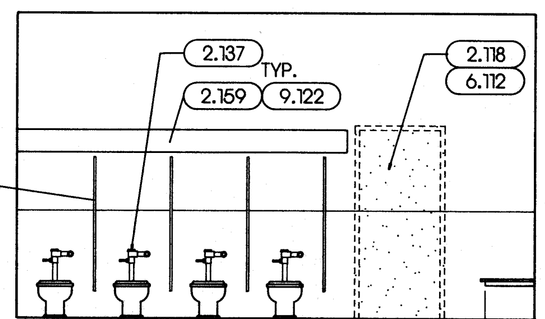

SOUTH

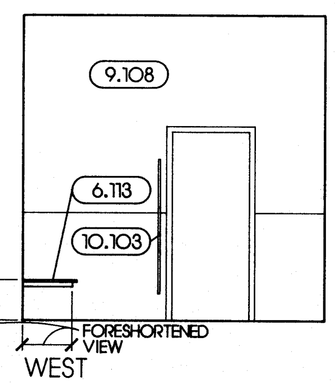

WEST

801 STAFF LOUNGE

802 STAFF TOILET (CON'T ON SHEET A20)

INTERIOR ELEVATIONS

1/4" = 1'- 0"

KEYNOTES

2.103	REMOVE (E) PLYWOOD	02072
2.105	REMOVE (E) CABINET DOOR	02072
2.108	REMOVE (E) WINDOW SASH	02072
2.110	REMOVE (E) TOILET FIXTURE; CAP OFF BEHIND FINISHES	02072
2.112	REMOVE (E) FLOOR-MOUNTED URINAL	02072
2.114	REMOVE (E) RETURN AIR GRILLES; SEE MECHANICAL PLANS	02072
2.116	REMOVE (E) FLOOR REGISTER; SEE MECHANICAL PLANS	02072
2.118	REMOVE (E) DOOR & FRAME	02072
2.119	REMOVE (E) LIGHT FIXTURES; SEE ELECTRICAL PLANS	02072
2.125	REMOVE (E) BULLETIN BOARD	02072
2.127	REMOVE (E) CABINET &/OR COUNTERTOPS	02072
2.136	REMOVE (E) COAT HOOKS & SUPPORTS	02072
2.137	(E) TOILET TO REMAIN	-
2.138	(E) METAL PARTITIONS TO REMAIN	-
2.143	(E) CEILING	-
2.158	REMOVE (E) WOOD PARTITION	-
2.159	(E) SHELVES TO REMAIN	-
2.160	(E) CLOCK	-
6.100	(E) CABINET TO REMAIN	-
6.105	PLASTIC LAMINATED CABINET DOOR	06410
6.106	WOOD COUNTERTOPS TO BE STAINED	06410
6.107	INFILL (E) OPEN'G W/2x6 STUDS @16" O.C.	06001
6.112	INFILL (E) OPEN'G W/MAT'LS TO MATCH ADJACENT SURFACES	06200
6.113	WOOD SEAT MOUNTED @ +1'-6" ABV. FINISH FLOOR	06200
6.114	1x4 W/ COAT HOOKS @ 8" O.C.	06200
6.116	PLASTIC LAMINATED COUNTERTOP W/ SPLASH	06410
6.127	(E) SHELVES & INTERIOR TO BE PAINTED	-
8.100	ALUMINUM STOREFRONT	08410
8.104	GLASS, BUTT JOINT	-
9.104	CERAMIC TILE FLOORING & WAINSCOT	09311
9.108	PATCH & MATCH (E) CEMENT PLASTER	09220
9.109	GYP. BD. W/ VENEER PLASTER TO MATCH (E)	09260
9.110	TYPICAL BASE	09650
9.111	(E) SOFFIT TO BE PAINTED	09900
9.121	SHEET VINYL FLOOR & WAINSCOT	-
9.122	PAINTED TO MATCH (E)	-
10.100	VINYL-COVERED TACKBOARD	10100
10.101	MARKERBOARD	10100
10.103	TOILET PARTITION	10160
10.104	GRAB-BARS	10800
10.105	MIRROR	10800
10.106	TOILET PAPER DISPENSER	10800
10.107	INSET FOR ERASER & PEN TRAY	-
15.104	H.C. LAV.; SEE PLUMBING PLANS	15400
15.105	SINK; SEE PLUMBING PLANS	15400
15.106	FLOOR-MOUNTED TOILETS; SEE PLUMBING PLANS	15400
15.107	WALL-MOUNTED URINALS; SEE PLUMBING PLANS	15400
15.112	METAL SHROUD OVER P-TRAP; SEE PLUMBING PLANS	15400
16.104	WALL-MOUNTED ELECTRIC HAND DRYERS TO MATCH (E)	16200
16.114	MOTION SENSOR; SEE ELECTRICAL PLANS	-

THESE DRAWINGS, RELATED SPECIFICATIONS, IDEAS, DESIGNS, AND ARRANGEMENTS INDICATED OR REPRESENTED THEREBY ARE AND SHALL REMAIN THE PROPERTY OF THE ARCHITECT; AND NO PART THEREOF SHALL BE COPIED, DISCLOSED TO OTHERS OR USED IN CONNECTION WITH ANY WORK OR PROJECT OTHER THAN THE SPECIFIC PROJECT FOR WHICH THEY HAVE BEEN PREPARED AND DEVELOPED WITHOUT THE WRITTEN CONSENT OF THE ARCHITECT. VISUAL CONTACT WITH THESE DRAWINGS OR SPECIFICATIONS SHALL CONSTITUTE CONCLUSIVE EVIDENCE OF ACCEPTANCE OF THESE RESTRICTIONS.

WRITTEN DIMENSIONS ON THESE DRAWINGS SHALL HAVE PRECEDENCE OVER SCALED DIMENSIONS. CONTRACTORS SHALL CHECK AND VERIFY ALL DIMENSIONS AND CONDITIONS ON THE JOB AND THIS OFFICE MUST BE NOTIFIED OF ANY VARIATIONS FROM THE DIMENSIONS AND CONDITIONS SHOWN BY THESE DRAWINGS IN THIS PROJECT.

DETAILED SHOP DRAWINGS MUST BE SUBMITTED TO THIS OFFICE FOR REVIEW BEFORE PROCEEDING WITH THE FABRICATION OF ANY PRODUCT TO BE ENCLOSED OR HIDDEN.

ISSUE FOR	DATE

REVISION	DATE

Bessie E. Owens Elementary
School Modernization
Bakersfield City School District

pa Steven C. Pechin
pechin associates architects aia
1400 easton drive suite 138
bakersfield, ca 93309 (805)322-2021
C-8366

SHEET A19

Project Number: 413-0788
Revision Date: 01/26/89