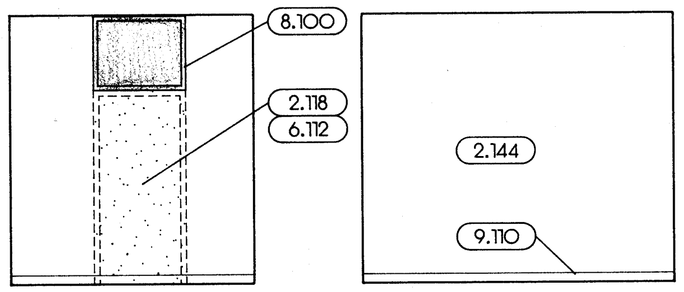

NORTH EAST

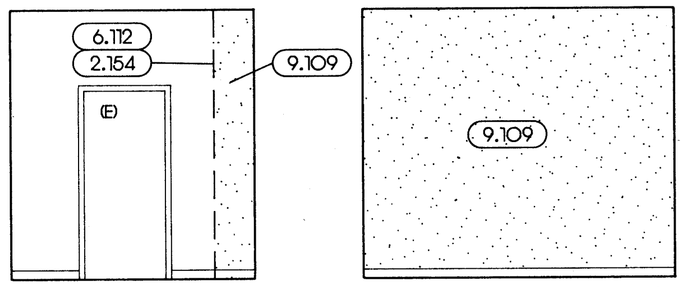

SOUTH WEST

814 OFFICE

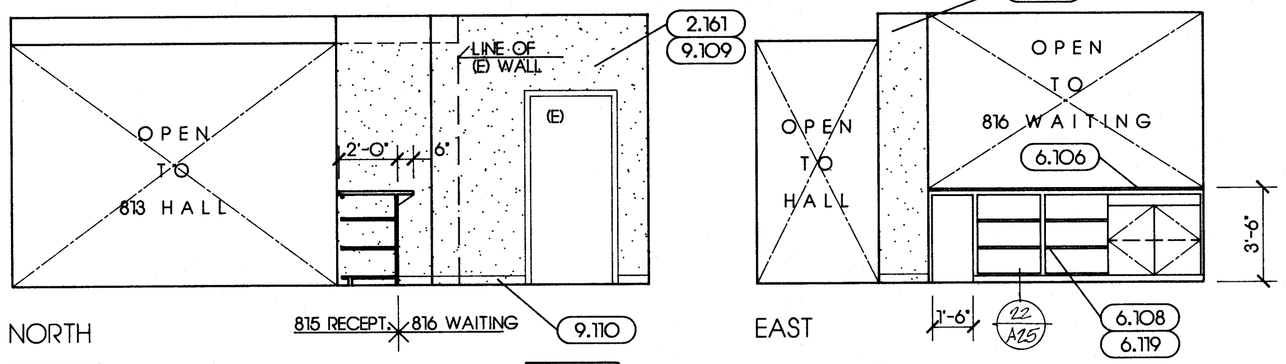

NORTH EAST

815 RECEPTION / 816 WAITING

KEYNOTES

2.108	REMOVE (E) WINDOW SASH	02072
2.116	REMOVE (E) FLOOR REGISTER; SEE MECHANICAL PLANS	02072
2.118	REMOVE (E) DOOR & FRAME	02072
2.144	(E) WALL	"
2.154	REMOVE (E) CASING	"
2.155	SALVAGE (E) TACK BOARD	"
2.161	REMOVE (E) WALL FINISH	"
6.104	WOOD VENEER CABINETS TO BE STAINED	06410
6.106	WOOD COUNTERTOPS TO BE STAINED	06410
6.107	INFILL (E) OPEN'G W/2x6 STUDS @16" O.C.	06001
6.108	PLASTIC LAMINATED BASE CABINET	06410
6.112	INFILL (E) OPEN'G W/MAT'LS TO MATCH ADJACENT SURFACES	06200
6.117	KNEE SPACE	06410
6.118	FILE DRAWERS 16" MIN. WIDTH	06410
6.119	ADJUSTABLE SHELVES	06410
6.125	PENCIL DRAWER	-
8.100	ALUMINUM STOREFRONT	08410
8.102	METAL DOOR & FRAME	08111
8.103	ALUMINUM STOREFRONT DOOR W/ FRAME	-
9.104	CERAMIC TILE FLOORING & WAINSCOT	09311
9.109	GYP. BD. W/ VENEER PLASTER TO MATCH (E)	09260
9.110	TYPICAL BASE	09650
10.100	VINYL-COVERED TACKBOARD	10100
10.104	GRAB-BARS	10800
10.105	MIRROR	10800
10.106	TOILET PAPER DISPENSER	10800
15.104	H.C. LAV.; SEE PLUMBING PLANS	15400
15.106	FLOOR-MOUNTED TOILETS; SEE PLUMBING PLANS	15400
15.109	(E) MECHANICAL REGISTERS, GRILLES, ETC.	-
15.112	METAL SHROUD OVER P-TRAP; SEE PLUMBING PLANS	15400

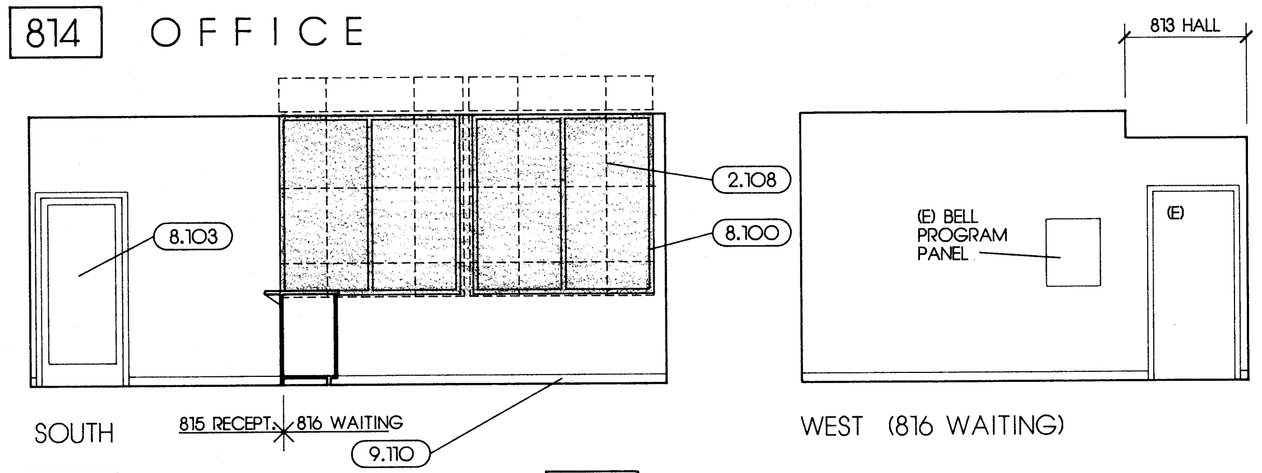

815 RECEPTION / 816 WAITING

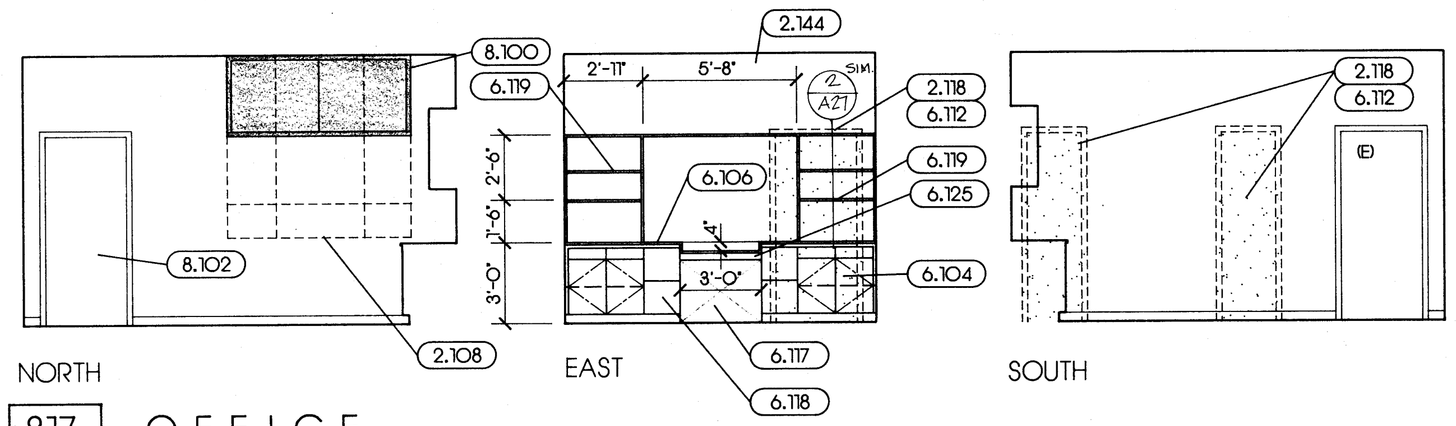

817 OFFICE

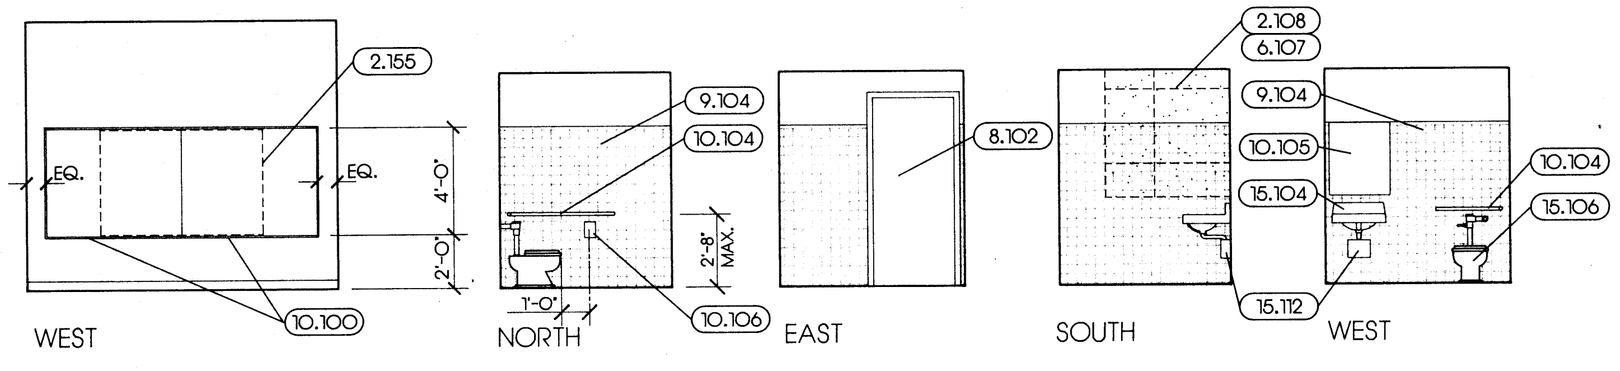

817 OFFICE (CON'T.) 818 TOILET

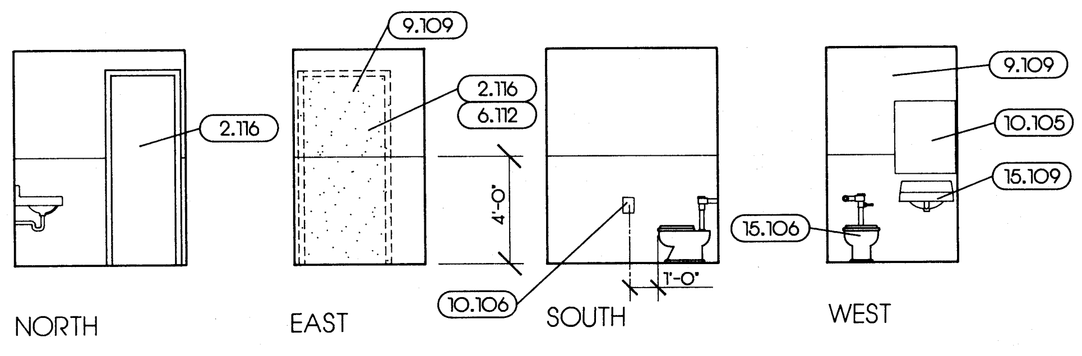

819 TOILET

INTERIOR ELEVATIONS

SEE 1/8" & 1/4" SCALE FLOOR PLANS FOR ADDITIONAL INFORMATION.

1/4" = 1'- 0"

THESE DRAWINGS, RELATED SPECIFICATIONS, IDEAS, DESIGNS, AND ARRANGEMENTS REPRESENTED THEREIN ARE THE PROPERTY OF THE ARCHITECT AND ARE NOT TO BE USED IN WHOLE OR IN PART BY OTHERS OR USED AT CONNECTION WITH ANY WORK OR PROJECT OTHER THAN THE SPECIFIC PROJECT FOR WHICH THEY HAVE BEEN PREPARED WITHOUT THE PRIOR WRITTEN CONSENT OF THE ARCHITECT. VISUAL CONTACT WITH THESE DRAWINGS OR SPECIFICATIONS SHALL CONSTITUTE CONCLUSIVE EVIDENCE OF ACCEPTANCE OF THESE RESTRICTIONS.

WRITTEN DIMENSIONS ON THESE DRAWINGS SHALL HAVE PRECEDENCE OVER SCALED DIMENSIONS. CONTRACTORS AND SUBCONTRACTORS SHALL VERIFY AND BE RESPONSIBLE FOR ALL DIMENSIONS AND CONDITIONS ON THE JOB AND THIS OFFICE MUST BE NOTIFIED OF ANY VARIATIONS FROM THE DIMENSIONS AND CONDITIONS SHOWN BY THOSE DRAWINGS.

DETAILED SHOP DRAWINGS MUST BE SUBMITTED TO THIS OFFICE FOR REVIEW BEFORE PROCEEDING WITH THE FABRICATION OF ANY PRODUCT TO BE INCLUDED IN THIS PROJECT.

ISSUE FOR | DATE

REVISION | DATE

Bessie E. Owens Elementary
School Modernization
Bakersfield City School District

pechin associates
architects aia
C-8366
James C. Pechin
1400 easton drive suite 138
bakersfield, ca 93309
(805)322-2021

SHEET A21

Project Number: 413-0788

Plot Date: 01/26/89