JOIST OR RAFTERS TO SIDES OF STUDS (B)	
INCH JOIST OR LESS	3-16d
FOR EA. ADDITIONAL FOUR (4) INCHES IN DEPTH OF JOISTS	1-16d
JOIST OR RAFTERS AT ALL BEARINGS TOE NAILS EA. SIDE	2-10d
STUDS TO BEARINGS, TOE NAILS EA. SIDE	2-10d
BLOCKING BETWEEN JOISTS OR RAFTERS.	
TO JOIST OR RAFTERS TOE NAILS EA. SIDE EA. END	2-10d
TO JOIST OR RAFTERS BEARINGS, TOE NAILS, EA. SIDE	2-10d
BLOCKING BETWEEN STUDS EA. END	2-10d TOE OR END NAIL
CROSS BRIDGING BTWN. JOISTS OR RAFTERS TOE NAIL EA END.	2-8d
RIBBONS TO STUDS.	
1 x RIBBONS	2-8d
2 x RIBBONS	2-16d
DOUBLE TOP PLATES (TOP 8'-0" MIN)	
LOWER PLATE TO TOP OF STUD	2-16d
UPPER PLATE TO LOWER PLATE - STAGGERED	16" O/C
UPPER PLATE TO LOWER PLATE OF INTERSECTION.	3-16d
MULTIPLE STUDS - STAGGER FOR WIDTH MORE THAN 4"	16" O/C
WOOD FURRING STRIPS PER 2-4704(D)	12" O/C

ALL NAILS SHALL BE COMMON WIRE NAILS
SUB-DRILL WHERE NECESSARY TO PREVENT SPLITTING WHERE POSSIBLE NAILS DRIVEN PERPENDICULAR TO GRAIN, SHALL BE USED INSTEAD OF TOE NAILS.

SEE SPECIFICATIONS FOR GRADES OF WOOD, TIMBER, & PLYWOOD.

(7) MINIMUM NAILING SCHEDULE

(1) WALL FRAMING

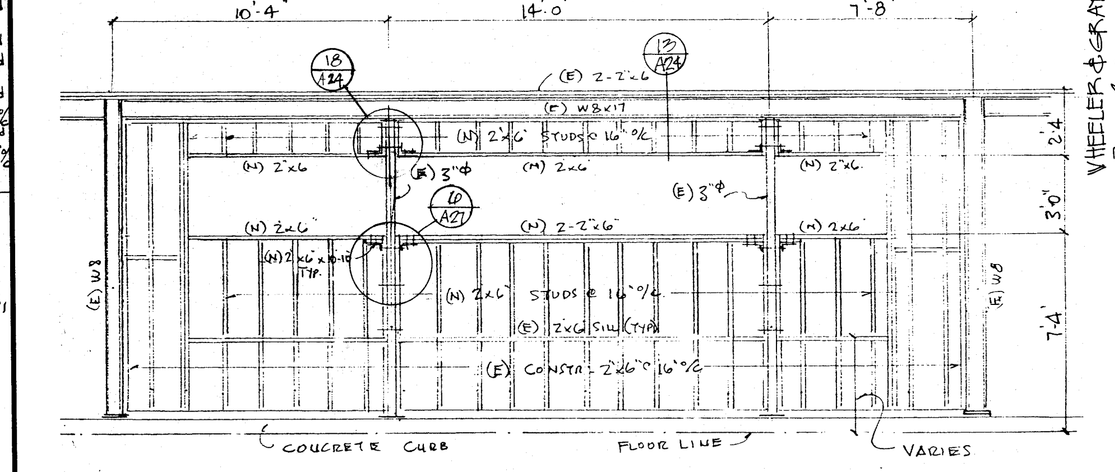

WHEELER & GRAY, STRUCTURAL ENGINEERS
By Glenn S.E. 8398

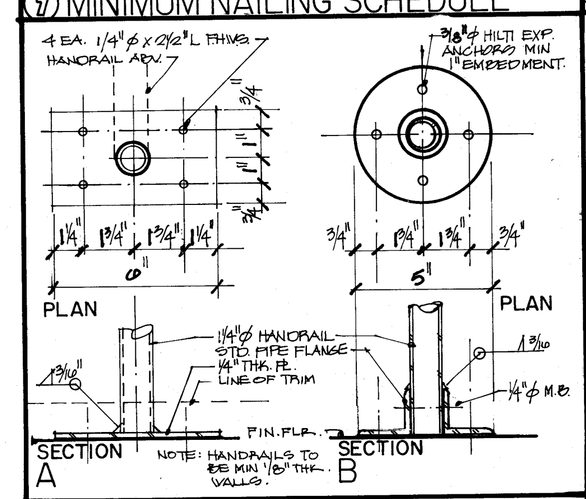

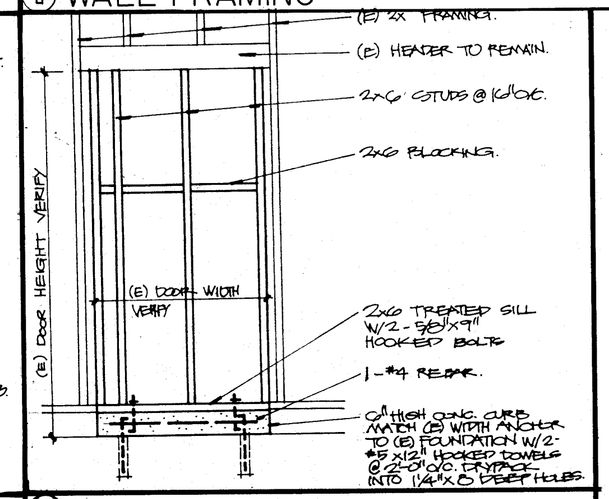

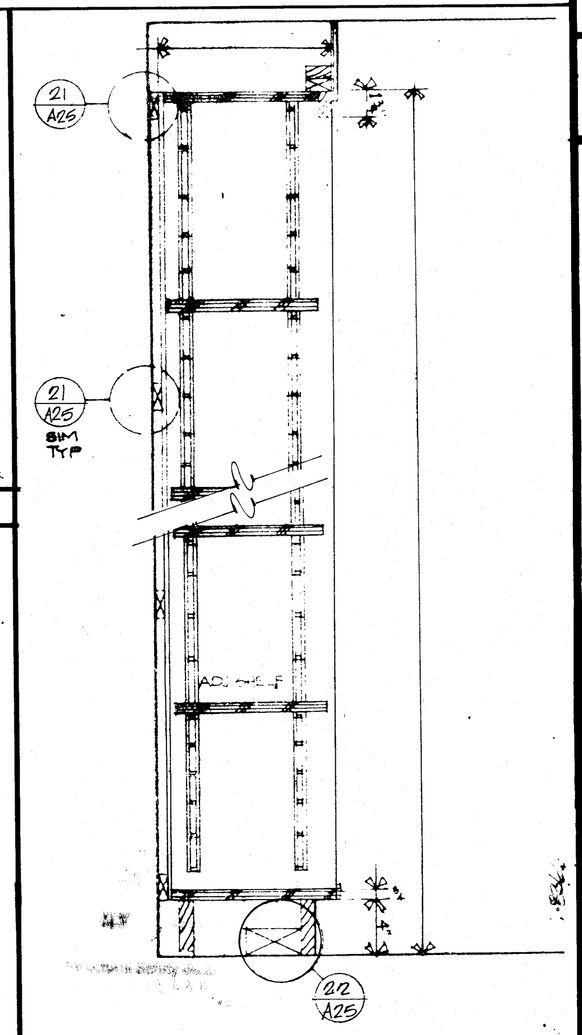

(8) HANDRAIL ATTACHMENT

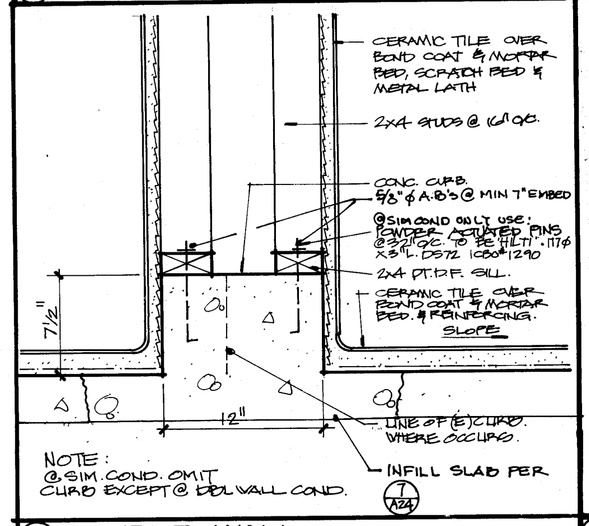

(4) DOOR INFILL

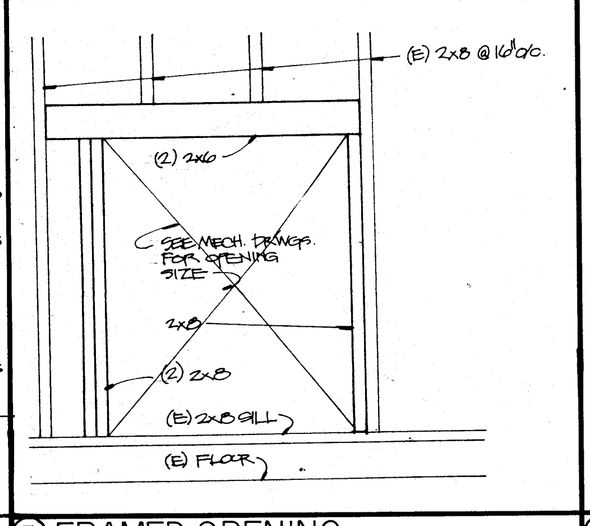

(9) DOUBLE WALL

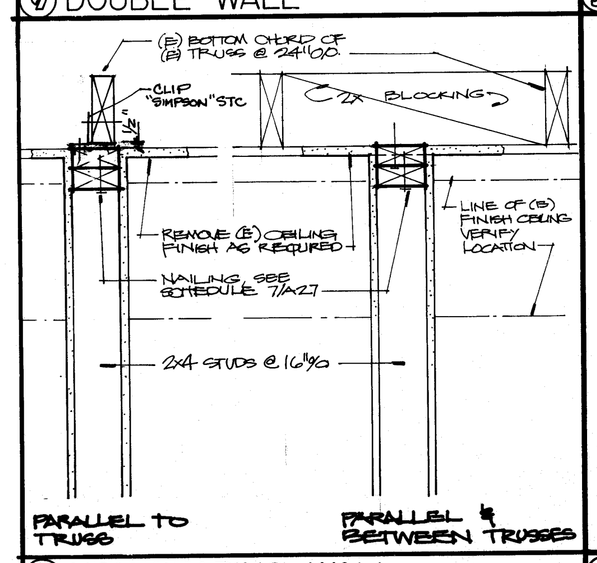

(5) FRAMED OPENING

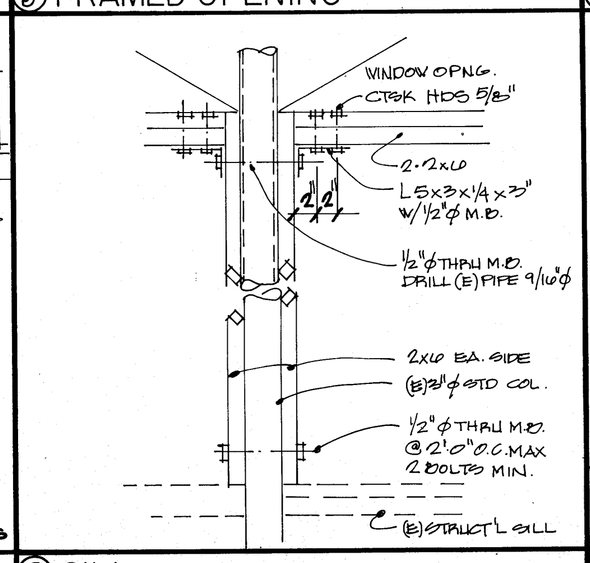

(2) STORAGE SHELVES

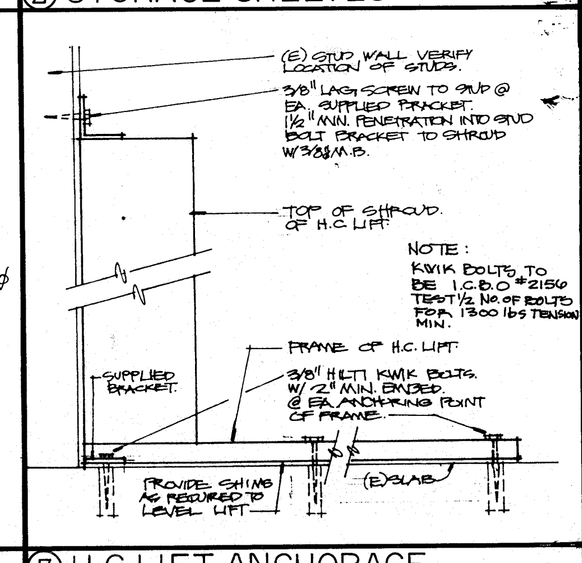

(10) NON-BEARING WALL

(6) SILL

(3) H.C. LIFT ANCHORAGE

THESE DRAWINGS, RELATED SPECIFICATIONS, IDEAS, DESIGNS, AND ARRANGEMENTS INDICATED OR REPRESENTED THEREBY ARE AND SHALL REMAIN THE PROPERTY OF THE ARCHITECT AND NO PART THEREOF SHALL BE COPIED, DISCLOSED TO OTHERS OR USED IN CONNECTION WITH ANY WORK OR PROJECT OTHER THAN THE SPECIFIC PROJECT FOR WHICH THEY HAVE BEEN PREPARED AND DEVELOPED WITHOUT THE WRITTEN CONSENT OF THE ARCHITECT. VISUAL CONTACT WITH THESE DRAWINGS OR SPECIFICATIONS SHALL CONSTITUTE CONCLUSIVE EVIDENCE OF ACCEPTANCE OF THESE RESTRICTIONS.

WRITTEN DIMENSIONS ON THESE DRAWINGS SHALL HAVE PRECEDENCE OVER SCALED DIMENSIONS. CONTRACTORS SHALL VERIFY AND BE RESPONSIBLE FOR ALL DIMENSIONS AND CONDITIONS ON THE JOB AND THIS OFFICE MUST BE NOTIFIED OF ANY VARIATIONS FROM THE DIMENSIONS AND CONDITIONS SHOWN BY THIS DRAWING.

DETAILS AND SHOP DRAWINGS MUST BE SUBMITTED TO THIS OFFICE FOR REVIEW BEFORE PROCEEDING WITH THE FABRICATION OF ANY PRODUCT TO BE INCLUDED IN THIS PROJECT.

DATE	ISSUED FOR

DATE	REVISION

BESSIE E. OWENS SCHOOL
MODERNIZATION
BAKERSFIELD CITY SCHOOL DISTRICT

pa pechin associates architects aia
1400 easton drive suite 138
bakersfield, california. 93309 (805) 322-2021
James S. Pechin c 8366

SHEET
A27

PROJECT 413-0788