MARK	SOIL	VENT	TRAP	DCW	DHW	MFG. & MODEL NO.	DESCRIPTION
WC/1	4"	2"	INT	1 1/4"	–	KOHLER #K–4250–ET "WELLCOMME"	VITREOUS CHINA SIPHON JET ELONGATED TOILET – 1 1/2" TOP SPUD – K–4670–C LUSTRA SEAT – SLOAN ROYAL #110 FLUSH VALVE (FIELD VERIFY EXIST. ROUGH–IN CONDITIONS)
WC/2	4"	2"	INT.	1 1/4"	–	KOHLER #K–4268–ET "HIGHCLIFF"	VITREOUS CHINA SIPHON JET ELONGATED TOILET 18" HIGH – 1 1/2" TOP SPUD – K–4670–C LUSTRA SEAT – SLOAN ROYAL #110 FLUSH VALVE (FIELD VERIFY EXIST. ROUGH–IN)
WC/3	–	–	–	–	–	EXIST TOILET TO REMAIN	RE–SECURE TO FLOOR OR REPLACE SEAL AS REQUIRED
WC/4	4"	2"	INT	1 1/4"	–	EXIST TOILET RE–USED	EXIST. TOILET TO BE REMOVED & STOCKPILED FOR RE–USE IN REMODELED AREAS – CONTRACTOR TO SELECT FIXTURE BASED ON CONDITIONS & MATCHING OF OTHER FIXTURES.
UR/1	2"	1 1/2"	1 1/2"	–	–	KOHLER #K–5024–T "DARC LID"	VITREOUS CHINA WASHOUT ACTION URINAL – 3/4" TOP SPUD 1/8"ø STRAINER– REMOVEABLE STRAINER – SLOAN ROYAL #186 FLUSH VALVE – #K–9000 CP. CAST BRASS "P" TRAP
L/1	2"	1 1/2"	1 1/4" 1 1/2"	3/4"	–	KOHLER #K–2867 "HUDSON" 19"X17"	ENAMELED CAST IRON LAVATORY – CENTERED SINGLE HOLE PUNCHING – #K–7715PERFORATED DRAIN & TAILPIECE – CHICAGO #335 TIP–TAP SLOW CLOSING FAUCET – ANGLE WALL STOP W/ FLEX RISER – C.B. LA PATTERN "P" TRAP
L/2	2"	1 1/2"	1 1/4"	3/4"	3/4"	KOHLER #K–2868 "HUDSON" 19"X17"	ENAMELED CAST IRON LAVATORY – #K–7715 PERFORATED DRAIN & TAILPIECE – CHICAGO #409–E12 TIP–TAP SLOW CLOSING FAUCET – (2) ANGLE WALL STOPS W/ FLEX RISERS – C.B. LA PATTERN "P" TRAP
WS/1	2"	1 1/2"	1 1/2"	3/4"	–	EXISTING WASH SINK RE–USED	EXIST. WASH SINK TO BE REMOVED & STOCKPILED FOR RE–USE IN REMODELED AREAS – CONTRACTOR TO SELECT FIXTURE BASED ON CONDITION & MATCHING OF OTHER FIXTURES
S/1	2"	1 1/2"	1 1/2"	3/4"	–	KOHLER #K–6550 "ADDISON" 24"X18"	ENAMELED CAST IRON SINK – #K–6699 METAL FRAME C.B. LA PATTERN "P" TRAP
	NOTE: SINK TO ROUGH–IN @ EXIST SINK LOCATION – FIELD VERIFY						
S/2	–	–	–	–	–	EXISTING SINK TO REMAIN	REMOVE SINK & RE–INSTALL IN NEW COUNTER TOP – TRIM AS PER SCHEDULE – MOUNTING FRAME – C.B. LA PATTERN "P" TRAP
EDF/1	2"	1 1/2"	1 1/2"	3/4"	–	HAWS #HCBF7	ELECTRIC BARRIER–FREE WATER COOLER – 6.7 GPH – 350 WATTS 4.5 FLA – 120 VOLTS – S.S. FINISH
B/1	NOTE: REMOVE EXIST. BUBBLER – NEW BUBBLER TO ROUGH–IN SAME LOCATION					CHICAGO #748–335	TIP–TAP SELF CLOSING ANGLE STOP BUBBLER WITH .75 GPM STEDI–FLO & EXT. VOLUME CONTROL – ANGLE W/ STOP & FLEX RISER
F/1	NOTE: REMOVE EXIST. FAUCET – NEW FAUCET TO ROUGH–IN SAME LOCATION					CHICAGO #332	SINGLE WALL FAUCET W/ #369 HANDLE – L8 SWING SPOUT & E3 SOFTFLO
ST/1	NOTE: REMOVE EXIST. STRAINER					KOHLER #K–8807	3 1/2" OUTLET STRAINER W/ 4" TAILPIECE – PROVIDE NEW C.B. LA PATTERN "P" TRAP IF EXIST NOT USABLE
DF/1	NOTE: REMOVE EXIST DRINKING FOUNTAIN AND REPLACE					HAWS DRINKING FOUNTAIN RECEPTOR	NEW 54" 4 BUBBLER ENAMELED CAST IRON DRINKING FOUNTAIN RECEPTOR – HAWS #5055 DRINKING FAUCET W/ 5055 LEVER HANDLE

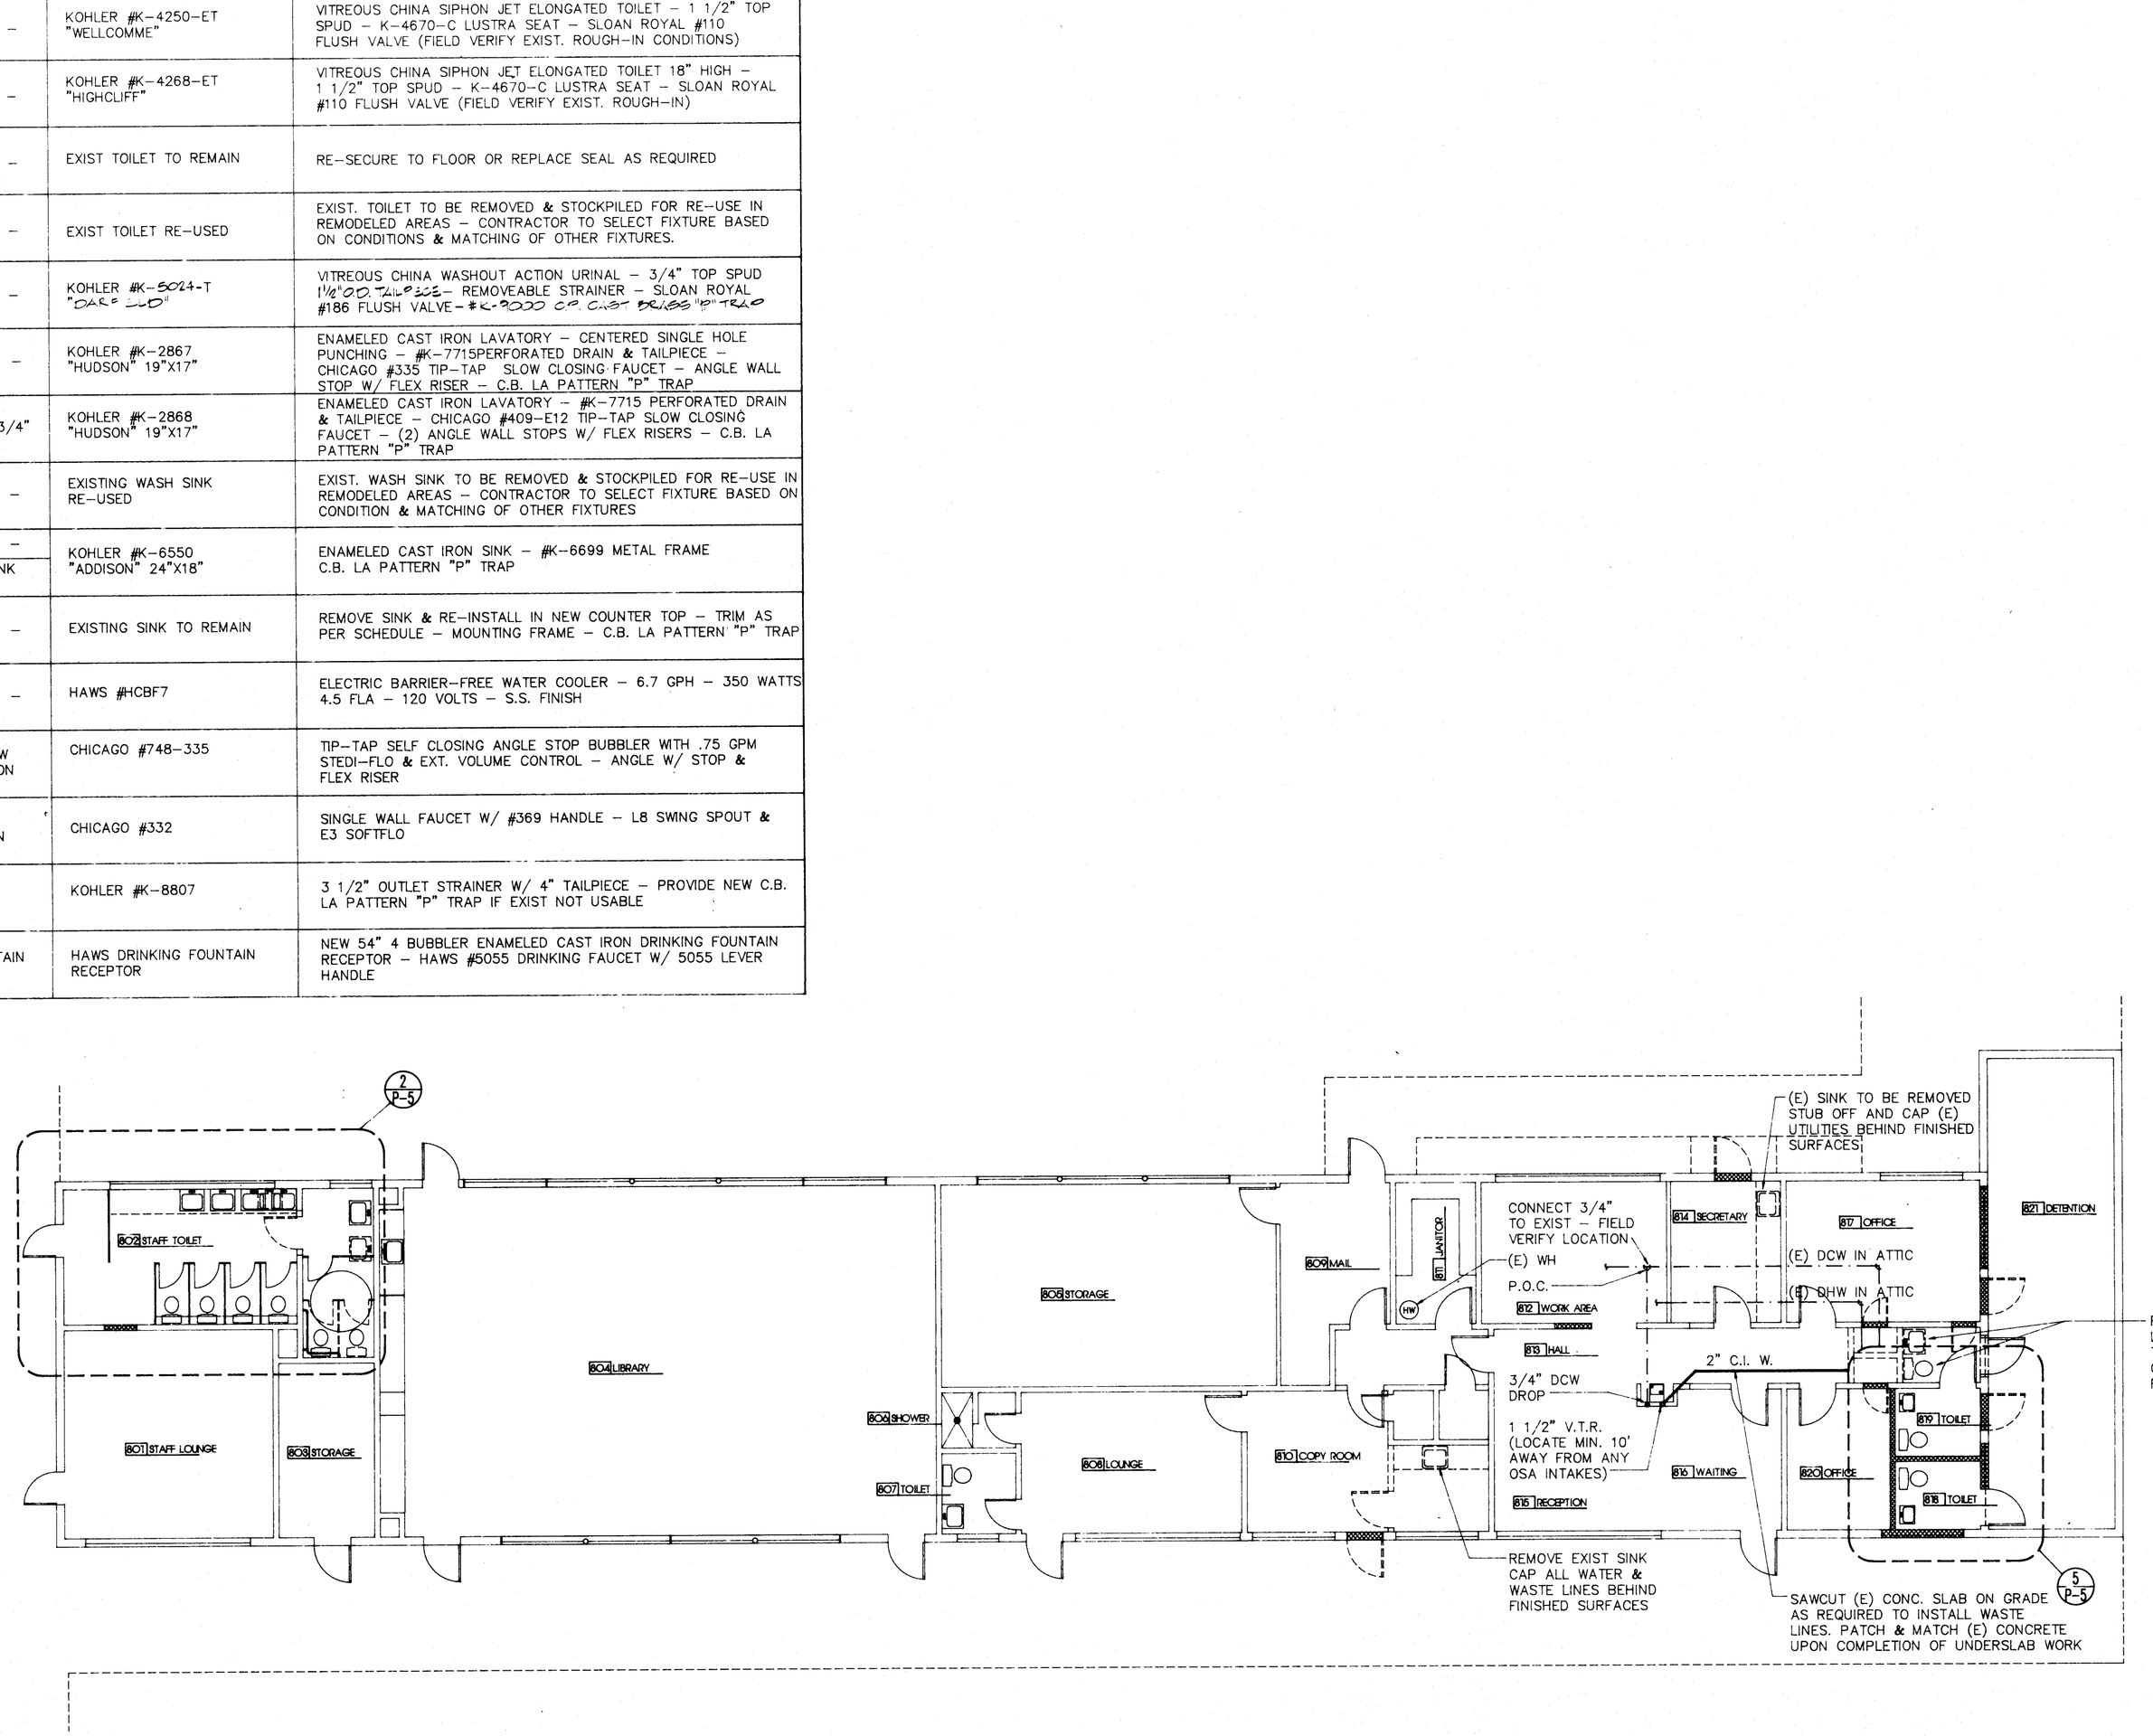

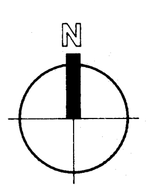

BUILDING H

PLUMBING FLOOR PLAN – ADMINISTRATION BUILDING H

1/8"=1'-0"

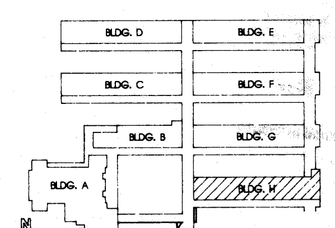

KEY PLAN

THESE DRAWINGS, RELATED SPECIFICATIONS, IDEAS, DESIGNS, AND ARRANGEMENTS REPRESENTED THEREIN ARE AND SHALL REMAIN THE PROPERTY OF THE ARCHITECT; AND NO PART THEREOF SHALL BE COPIED, DISCLOSED TO OTHERS OR USED IN CONNECTION WITH ANY WORK OR PROJECT OTHER THAN THE SPECIFIC PROJECT FOR WHICH THEY HAVE BEEN PREPARED AND DEVELOPED WITHOUT THE WRITTEN CONSENT OF THE ARCHITECT. VISUAL CONTACT WITH THESE DRAWINGS OR SPECIFICATIONS SHALL CONSTITUTE CONCLUSIVE EVIDENCE OF ACCEPTANCE OF THESE RESTRICTIONS.

WRITTEN DIMENSIONS ON THESE DRAWINGS SHALL HAVE PRECEDENCE OVER SCALED DIMENSIONS. CONTRACTORS SHALL VERIFY AND BE RESPONSIBLE FOR ALL DIMENSIONS AND CONDITIONS ON THE JOB AND THIS OFFICE MUST BE NOTIFIED OF ANY VARIATIONS FROM THE DIMENSIONS AND CONDITIONS SHOWN BY THESE DRAWINGS.

DETAILED SHOP DRAWINGS MUST BE SUBMITTED TO THIS OFFICE FOR REVIEW BEFORE PROCEEDING WITH THE FABRICATION OF ANY PRODUCT TO BE INCLUDED IN THIS PROJECT.

ISSUED FOR

DATE

REVISION

DATE

BESSIE E. OWENS SCHOOL
MODERNIZATION
BAKERSFIELD CITY SCHOOL DISTRICT

pechin associates aia
architects
1400 easton drive suite 138
bakersfield, california, 93309
(805) 322-2021
James E. Pechin C-8366

SHEET
P4

PROJECT 413-0788