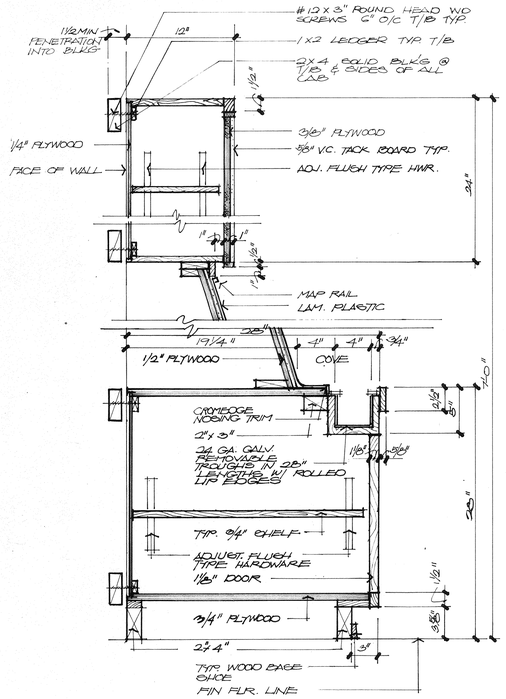

A EASEL CABINET 0 1/2"

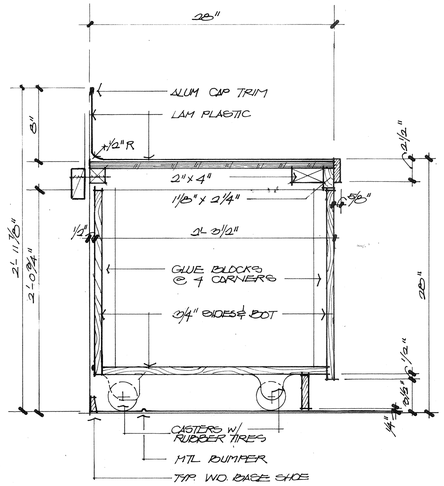

C CABINET DETAIL @ CART 0 1/2"

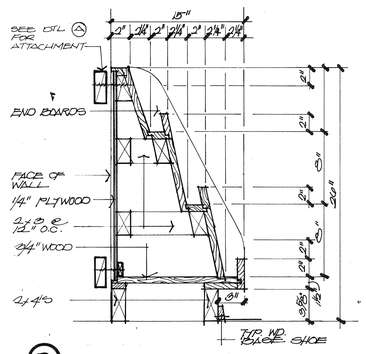

D MAGAZINE RACK 0 1/2"

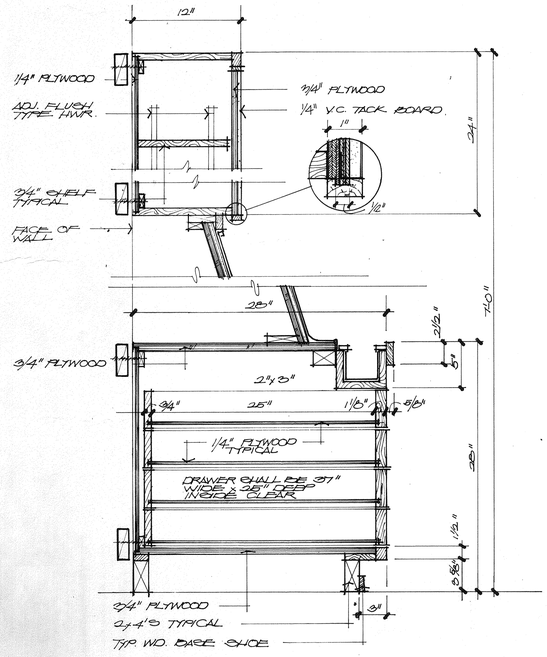

B EASEL CABINET 0 1/2"

NOTE: TROUGHS & EASEL TYP. DTLS. W/ A

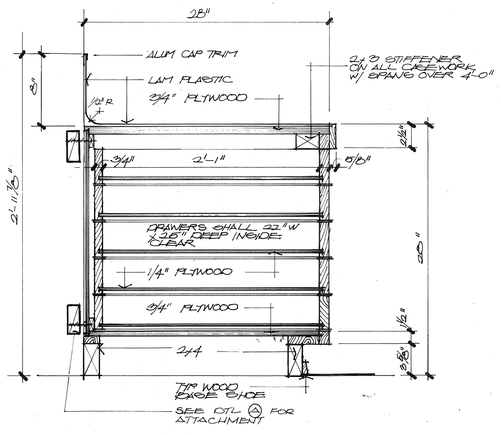

E CABINET DETAIL @ DRAWERS 0 1/2"

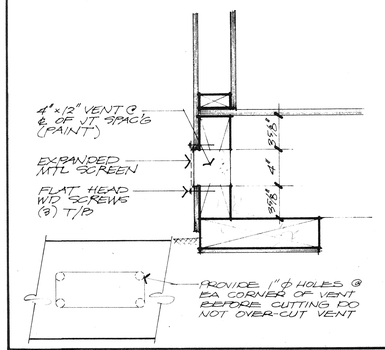

5 VENT DETAIL 0 1/2"

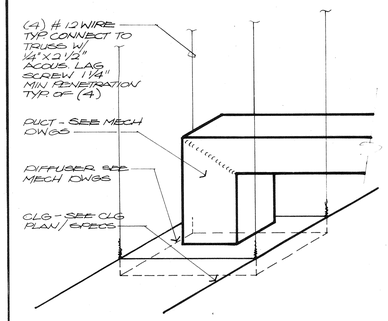

6 CLG. DIFFUSER DTL.

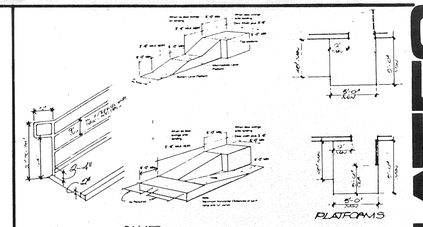

1 HANDICAPPED RAMP N.T.S.

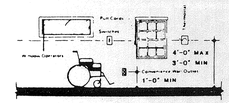

CONTROLS, SWITCHES, AND OUTLETS

NOTES:
MANUALLY OPERATED SWITCHES AND CONTROLS ARE LIGHTS, POWER, HEAT, VENTILATION, WINDOWS, DRAPERIES, DOORS AND SIMILAR CONTROLS OF FREQUENT AND ESSENTIAL USE ARE TO BE CENTERED BETWEEN 30" AND 48" FROM FLOOR.
2 ELECTRICAL CONVENIENCE WALL OUTLETS ARE TO BE CENTERED A MINIMUM 10" FROM THE FLOOR. ELECTRICAL CONVENIENCE FLOOR OUTLETS AND BASEBOARD ELECTRICAL OUTLETS USED IN RELOCATABLE PARTITIONS OR WINDOW SILLS ARE NOT SUBJECT TO THE MIN. HEIGHT REQUIREMENTS
3 EXISTING BUILDINGS MUST MEET SAME REQUIREMENTS AS NEW CONSTRUCTION UNLESS AN UNREASONABLE HARDSHIP IS GRANTED BY THE ENFORCING AGENCY.

2 FIXTURE HEIGHTS N.T.S.

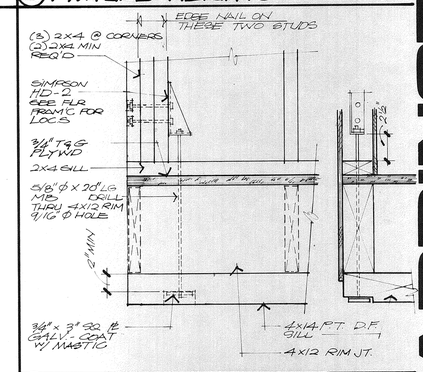

3 HOLD DOWN @ SHEAR PANEL 0 1/2"

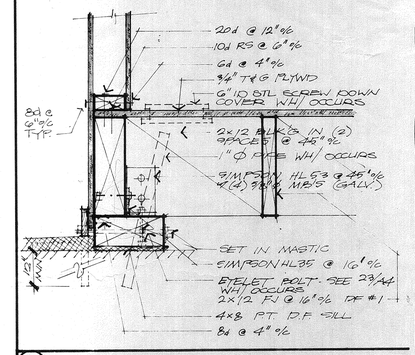

4 SILL @ ENDWALL DTL 0 1/2"

CHRIS A. ADDINGTON & ASSOCIATES
A.I.A. ARCHITECTS • 3434 TRUXTUN AVE. SUITE #240 • BAKERSFIELD • CALIF. 93301/805•327-1699

THE ABOVE DRAWINGS AND SPECIFICATIONS AND IDEAS DESIGNS AND ARRANGEMENTS REPRESENTED THEREIN ARE AND SHALL REMAIN THE PROPERTY OF THE ARCHITECT AND NO PART THEREOF SHALL BE COPIED, SHALL ALSO BE GIVEN TO OTHERS OR USED IN CONNECTION W/ ANY WORK OR PROJECT OTHER THAN THE SPECIFIC PROJECT FOR WHICH THEY HAVE BEEN PREPARED AND DEVELOPED WITHOUT THE WRITTEN CONSENT OF THE ARCHITECT. VISUAL CONTACT W/ THESE DRAWINGS OR SPECIFICATIONS SHALL CONSTITUTE CONCLUSIVE EVIDENCE OF ACCEPTANCE BY ALL PARTIES.
WRITTEN DIMENSIONS ON THESE DRAWINGS SHALL HAVE PRECEDENCE OVER SCALED DIMENSIONS. CONTRACTORS SHALL VERIFY AND BE RESPONSIBLE FOR ALL DIMENSIONS AND CONDITIONS ON THE JOB AND THE ARCHITECT SHALL BE NOTIFIED OF ANY VARIATIONS FROM THE DIMENSIONS AND CONDITIONS SHOWN BY THESE DRAWINGS AND SPECIFICATIONS PRIOR TO BEGINNING WORK. SUBMISSION OF SHOP DRAWINGS TO THE ARCHITECT'S OFFICE FOR APPROVAL BEFORE PROCEEDING WITH FABRICATION.

OFFICE OF THE STATE ARCHITECT
STRUCTURAL SAFETY SECTION
A46446 JUL 3 1985

DATE:	PRINTS ISSUED FOR	MARK	DATE	REVISIONS
5.10.85	BOARD APPROVAL	1	6.13.85	OSA CHANGES/REVIS
5.20.85	OSA	2		
5.29.85	BIDDING	3		
		4		
		5		

DRAWN EFREN
DATE 5.10.85
JOB NO 85-242.1
CHECK'D MMS

CAA CHRIS A. ADDINGTON C 18093

MISCELLANEOUS DETAILS

NEW PORTABLE CLASSROOM
FOR BAKERSFIELD CITY SCHOOL DISTRICT.
BAKERSFIELD - KERN COUNTY - CALIFORNIA

A 5
OF 9 SHEETS