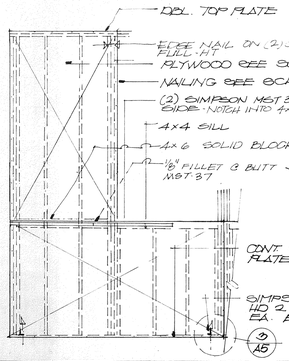


1 SHEAR WALL 0 3/8"

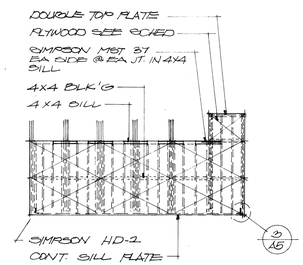


2 SHEAR WALL 0 1/8"

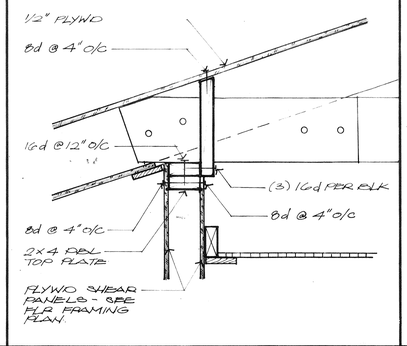


3 SHEAR-WALL @ PLATE 0 1 1/2"

1. It is the intent of the Contract Documents to place the responsibility for the water-tightness of the entire roof under the Roofing Contractor. In submitting a bid, the Roofing Contractor and manufacturer whose material he proposes to use, agree to the conditions as set forth in all the Contract Documents.

   They further agree that all conditions as set forth in said documents are complete and meet their specific requirements for a bonded roof of the period specified.

   In the event the Documents do not completely or correctly cover their specific requirements, the Roofing Contractor shall provide for same in his bid. Under no circumstances will an extra be allowed for failure to comply with these requirements.

## ROOF NOTES

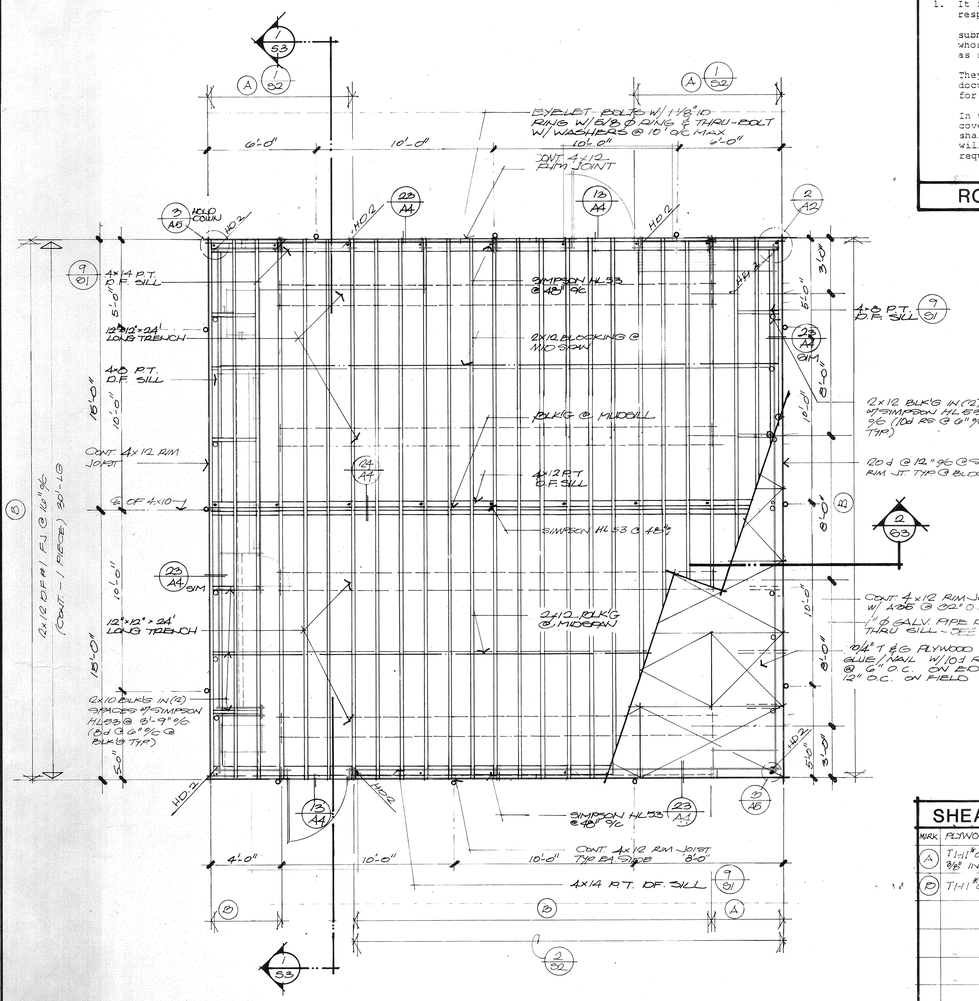


## SHEAR WALL SCHEDULE

| MARK | PLYWOOD | NAILS | NAILING | BLOCKING |
|---|---|---|---|---|
| A | T1-11* OUTSIDE 3/8 INSIDE | COMMON 8d GALV. | 4" O.C. EDGE 12" O.C. FIELD | 4x4 HORIZ. (3) 2x4 VERT. |
| B | T1-11* OUTSIDE | COMMON 8d GALV. | 6" O.C. EDGE 12" O.C. FIELD | 4x4 HORIZ. (4) 2x4 VERT. |
| | | | | |
| | | | | |
| | | | | |
| | | | | |

* 3/8" RATED PLYWOOD

FLOOR FRAMING PLAN 0 1/4"

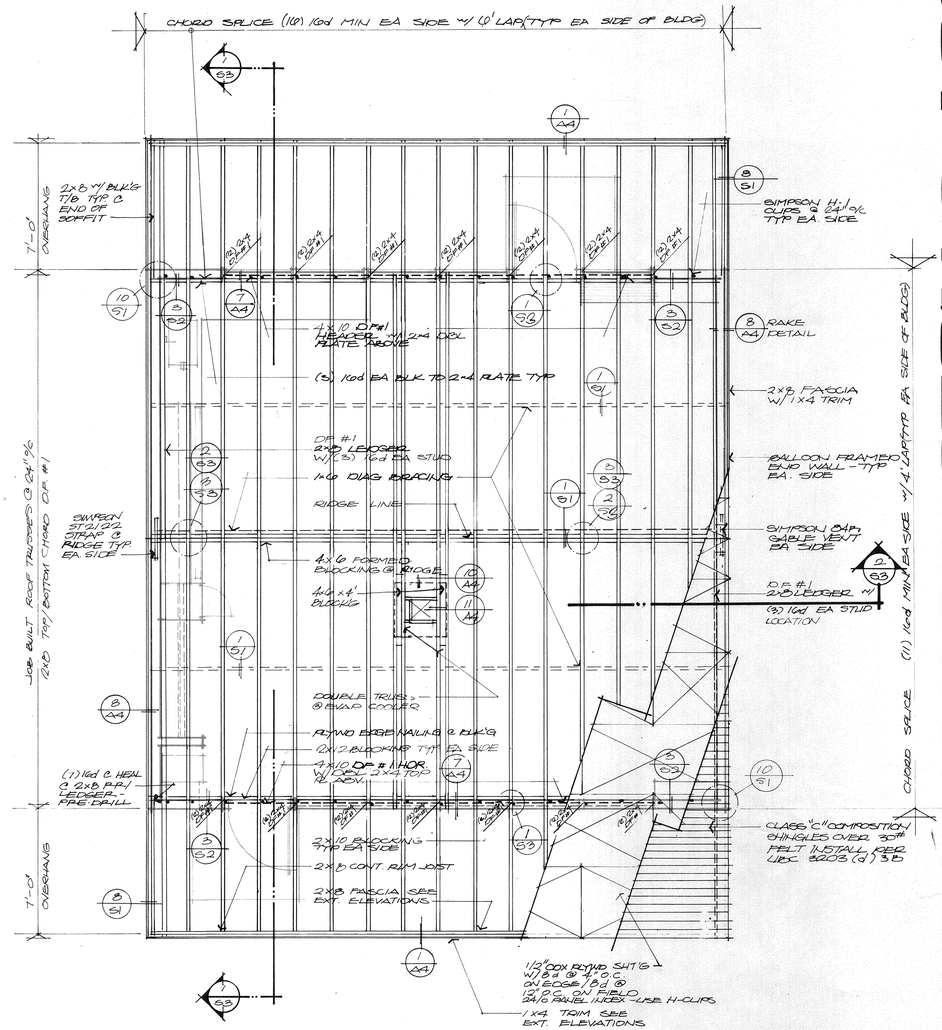


ROOF FRAMING PLAN 0 1/4"

CHRIS A. ADDINGTON
A.I.A. ARCHITECTS • 3434 TRUXTUN AVE. SUITE #240 • BAKERSFIELD • CALIF. 93301/805•327-1699

THE ABOVE DRAWINGS AND SPECIFICATIONS AND IDEAS, DESIGNS AND ARRANGEMENTS REPRESENTED THEREBY ARE AND SHALL REMAIN THE PROPERTY OF THE ARCHITECT, AND NO PART THEREOF SHALL BE COPIED, DISCLOSED TO OTHERS OR USED IN CONNECTION WITH ANY WORK OR PROJECT OTHER THAN THE SPECIFIC PROJECT FOR WHICH THEY HAVE BEEN PREPARED AND DEVELOPED WITHOUT THE WRITTEN CONSENT OF THE ARCHITECT. VISUAL CONTACT WITH THESE DRAWINGS OR SPECIFICATIONS SHALL CONSTITUTE CONCLUSIVE EVIDENCE OF ACCEPTANCE OF THESE RESTRICTIONS.
WRITTEN DIMENSIONS ON THESE DRAWINGS SHALL HAVE PRECEDENCE OVER SCALED DIMENSION. CONTRACTORS SHALL VERIFY AND BE RESPONSIBLE FOR ALL DIMENSIONS AND CONDITIONS ON THE JOB AND THIS OFFICE MUST BE NOTIFIED OF ANY VARIATIONS FROM THE DIMENSIONS AND CONDITIONS SHOWN BY THESE DRAWINGS. SHOP DETAILS MUST BE SUBMITTED TO THIS OFFICE FOR APPROVAL BEFORE PROCEEDING WITH FABRICATION.

83182

OZALID

| DATE: | PRINTS ISSUED FOR: | MARK | DATE | REVISIONS | DRAWN BY |
|---|---|---|---|---|---|
| 5-10-85 | BOARD APPROVAL | 1 | 6-19-85 | OSA CHANGES/REQ'D | EN |
| 5-20-86 | OSA | 2 | | | DATE 5-10-85 |
| 5-23-85 | BIDDING | 3 | | | JOB NO. 85-242.1 |
| | | 4 | | | CHECK'D MMS |
| | | 5 | | | |

CAA

CHRIS A. ADDINGTON C-8093

ROOF / FLOOR FRAMING PLANS/ NOTES DETAILS

NEW PORTABLE CLASSROOM
FOR BAKERSFIELD CITY SCHOOL DISTRICT.
BAKERSFIELD • KERN COUNTY • CALIFORNIA

S 2 OF 3 SHEETS