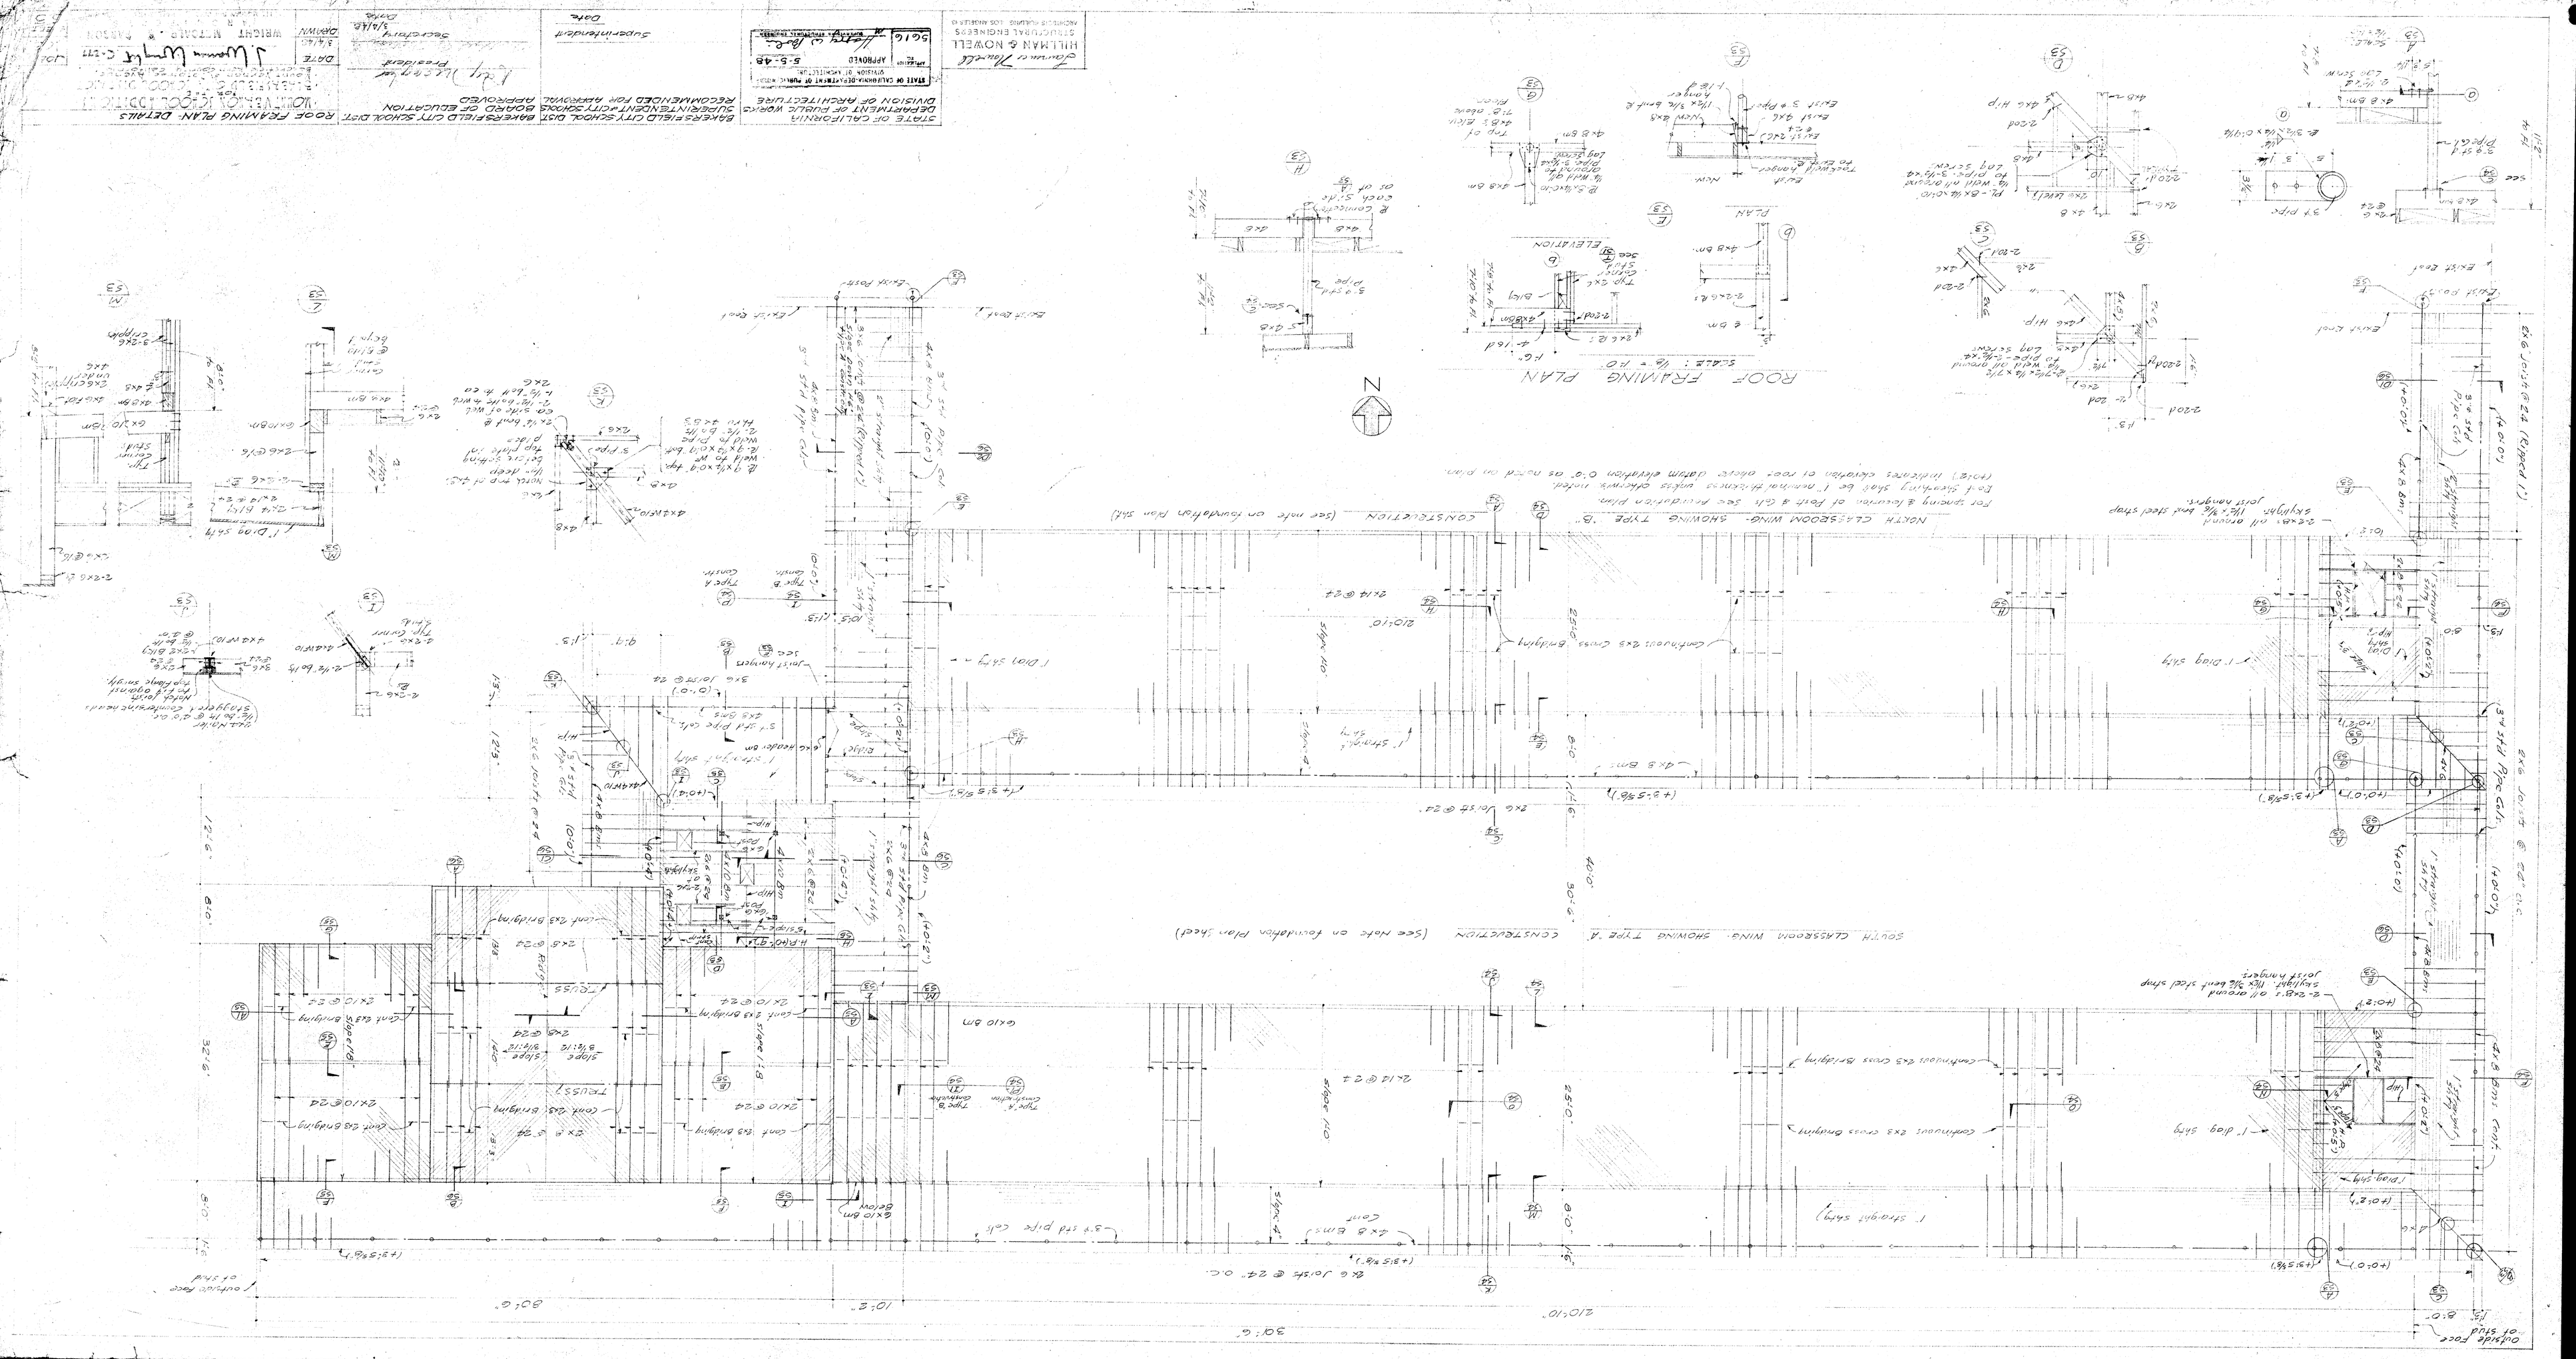
ROOF FRAMING PLAN
NORTH CLASSROOM WING SHOWING TYPE "B" CONSTRUCTION (See note on foundation plan sht.)
SOUTH CLASSROOM WING SHOWING TYPE "A" CONSTRUCTION (See Note on foundation plan sheet)
STATE OF CALIFORNIA
DEPARTMENT OF PUBLIC WORKS
DIVISION OF ARCHITECTURE
BAKERSFIELD CITY SCHOOL DIST.
SUPERINTENDENT OF CITY SCHOOLS
RECOMMENDED FOR APPROVAL
BAKERSFIELD CITY SCHOOL DIST.
APPROVED
ROOF FRAMING PLAN DETAILS
HILLMAN & NOWELL
STRUCTURAL ENGINEERS
APPROVED
5-5-48
5616
Superintendent
Date
Secretary
Date
Date
DRAWN
WRIGHT MITCHELL & PARSON
Outside Face of stud