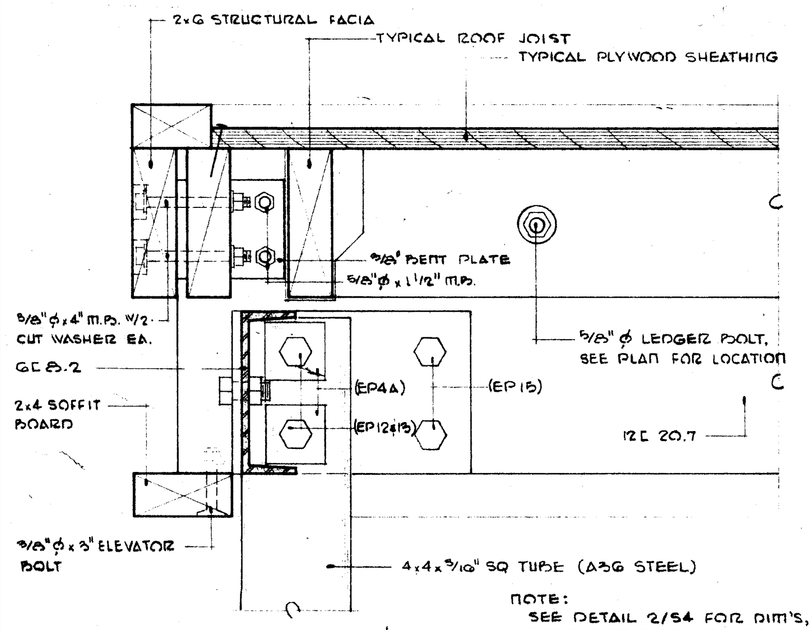

NOTE:
SEE DETAIL 2/S4 FOR DIM'S, BOLT SIZES, ECT. FOR COL. TO BEAM CONNECTION.

1 S-4 COLUMN to CHANNEL CONNECTION END MODULES

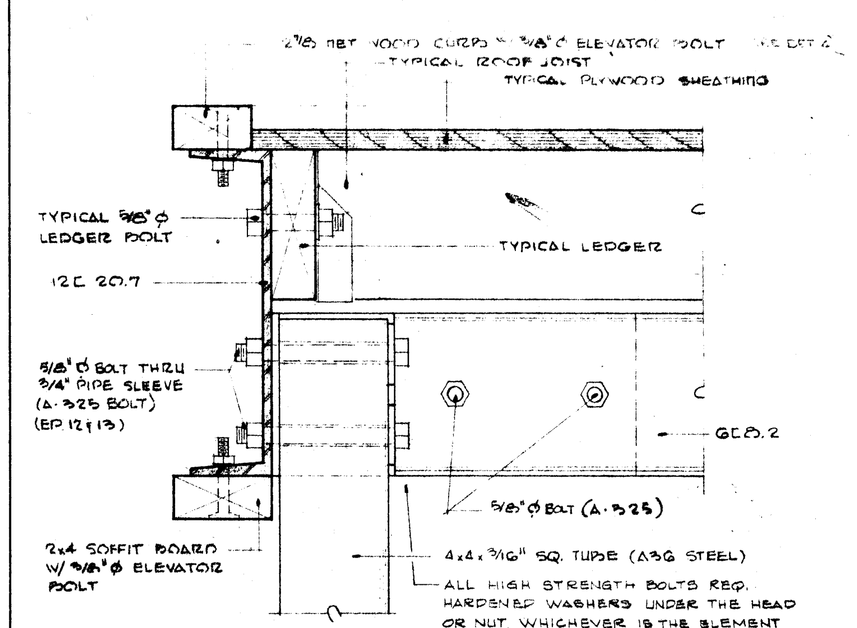

2 S-4 COLUMN to CHANNEL CONNECTION SIDE MODULES

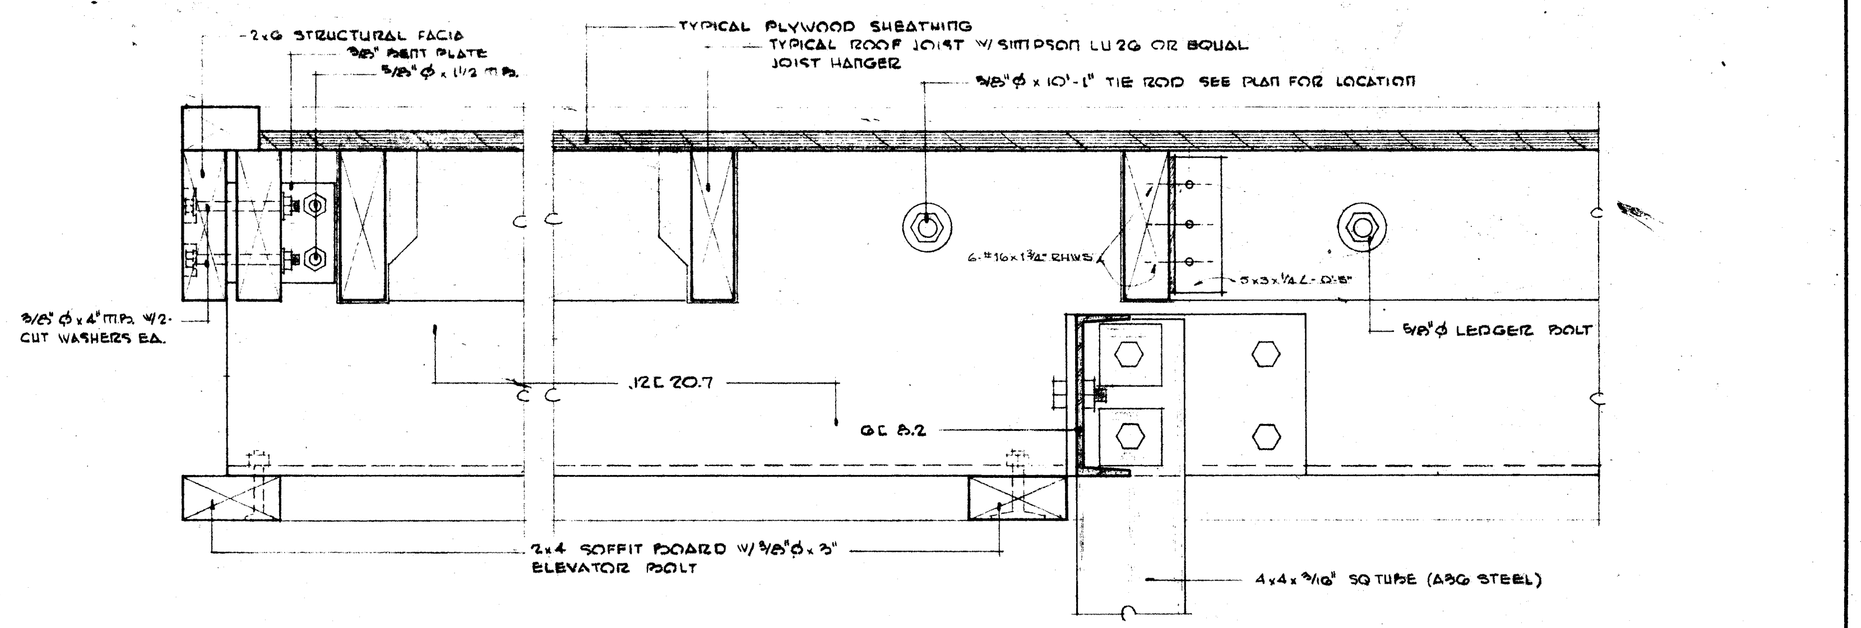

3 S-4 COLUMN to CHANNEL CONNECTION OVERHANG MODULES

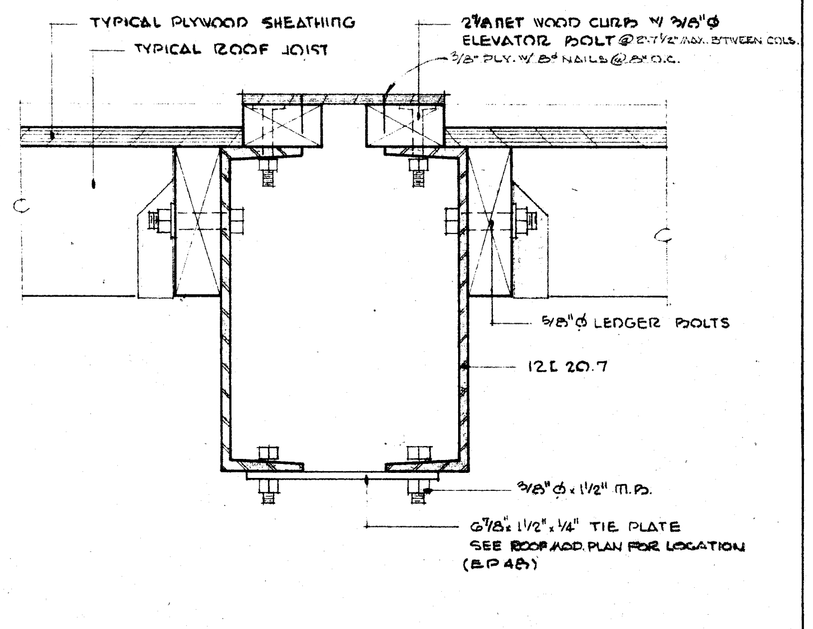

4 S-4 ROOF TIE PLATE DETAIL ADJOINING MODULES - SIDE to SIDE

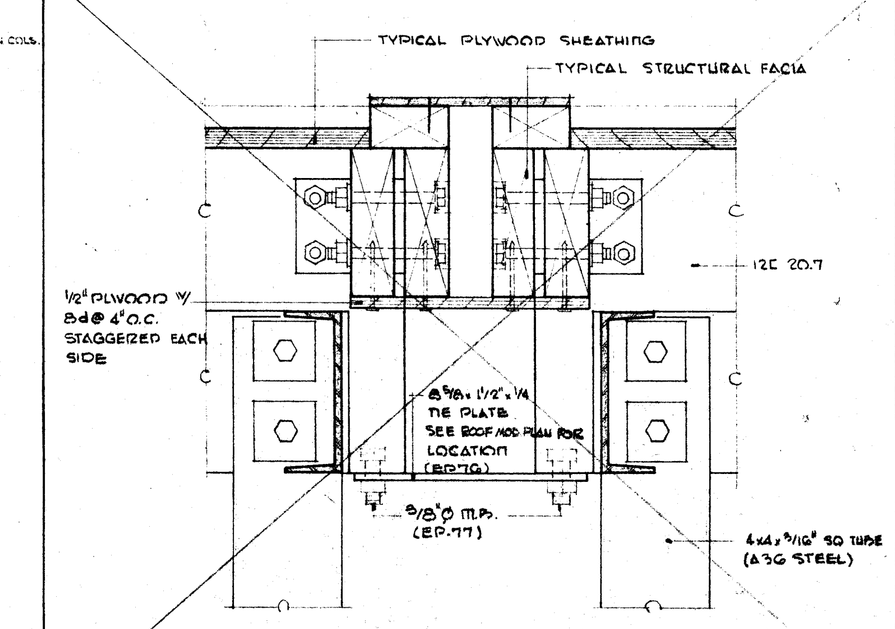

5 S-4 ROOF TIE PLATE DETAIL ADJOINING MODULES - END to END

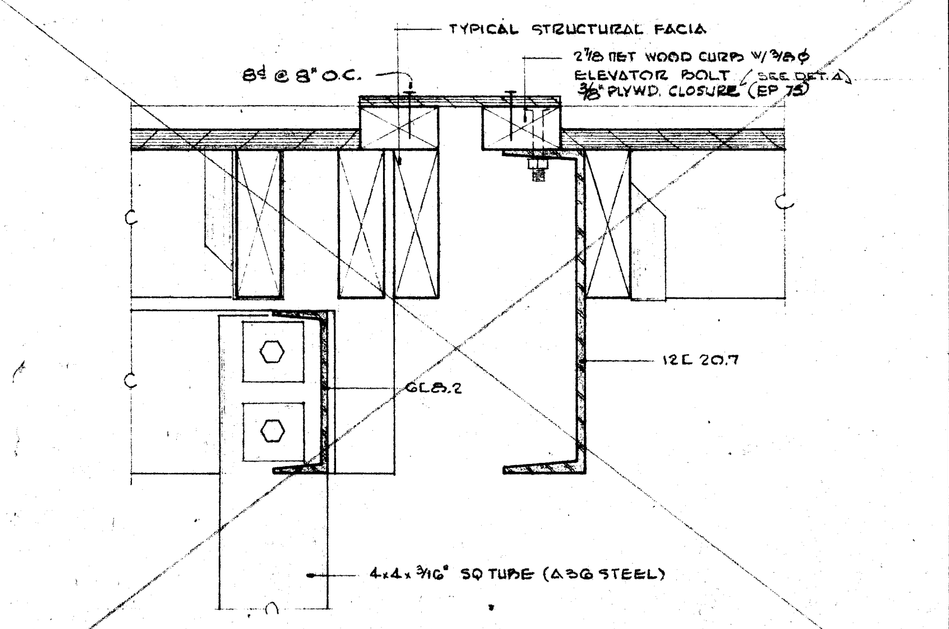

6 S-4 ROOF TIE PLATE DETAIL ADJOINING MODULES - END to SIDE

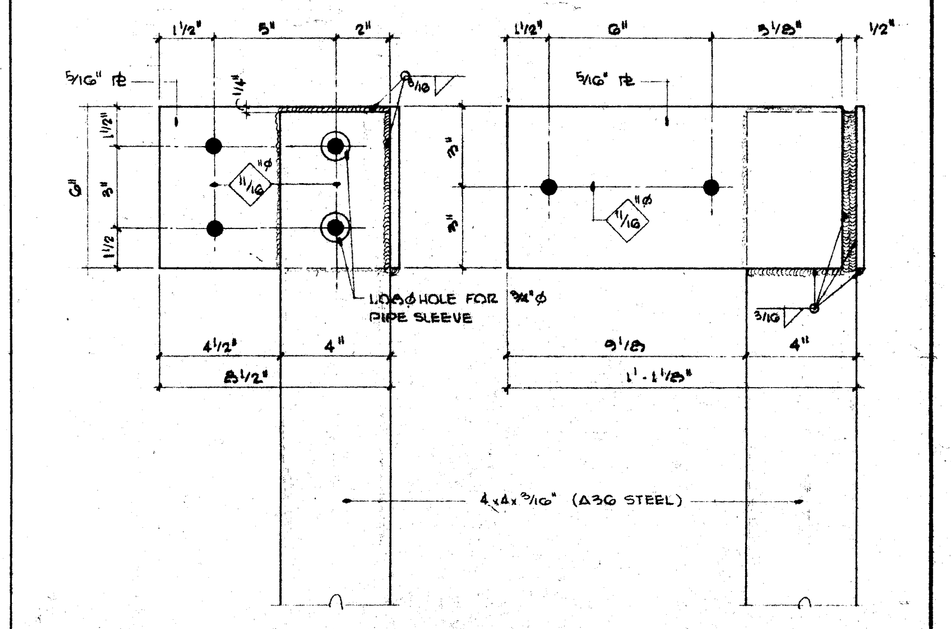

UNITS #1, #2 & #3

7 S-4 COLUMN CONNECTION DETAILS

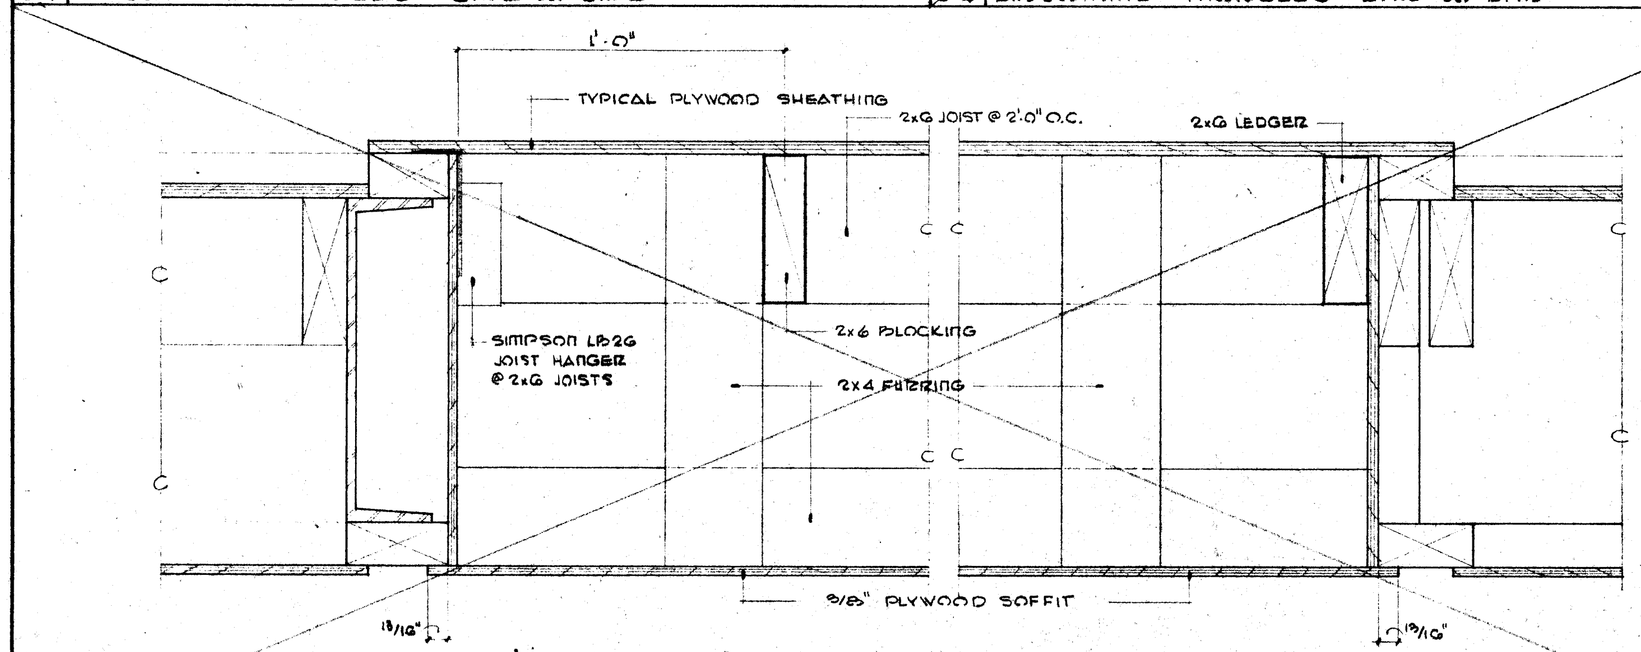

8 S-4 OVERHANG MAKE-UP

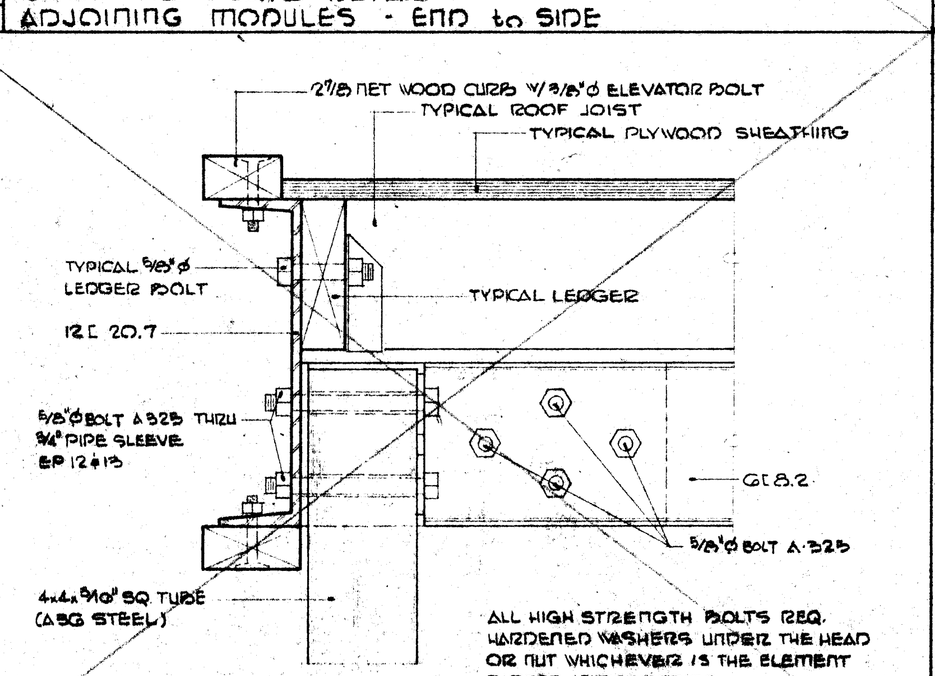

ALL HIGH STRENGTH BOLTS REQ. HARDENED WASHERS UNDER THE HEAD OR NUT WHICHEVER IS THE ELEMENT TURNED IN TIGHTENING

9 S-4 COLUMN to CHANNEL CONNECTION at DOUBLE UNITS SIDE MODULES

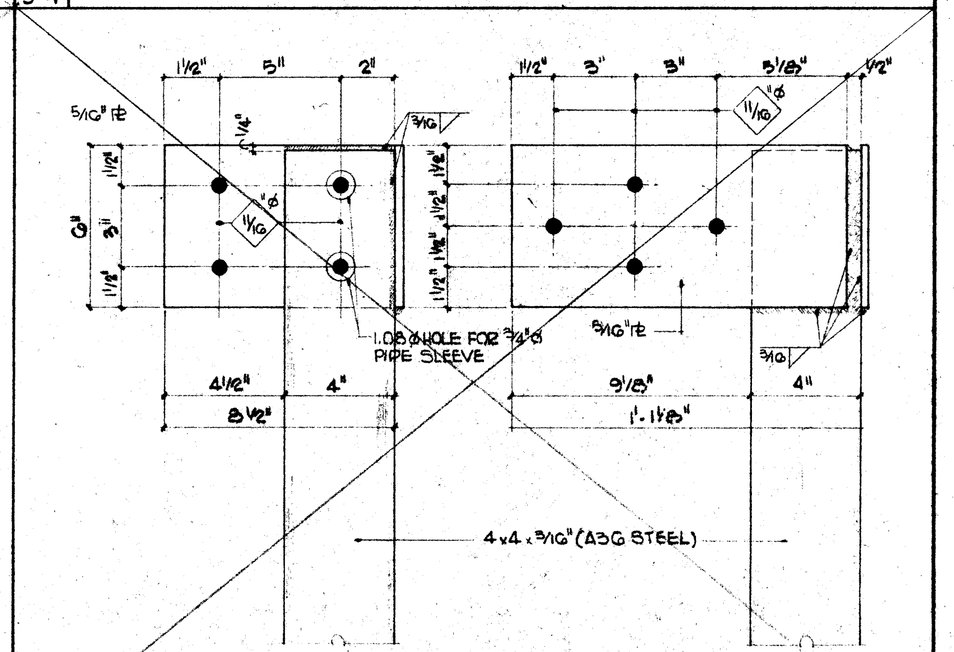

10 S-4 COLUMN CONNECTION at DOUBLE UNITS

BY	REVISIONS	DATE	NO.

The acceptance of this plan set constitutes agreement that the design, shop drawing and specifications for the project noted shall be used solely for said project and shall not be exhibited, delivered or transferred to anyone or reused for additional projects in whole or in part without the written consent of Speedspace Corporation.

REFERENCE PLAN SET NO.

APPROVED BY
STATE OF CALIFORNIA — DEPARTMENT OF GENERAL SERVICES
OFFICE OF ARCHITECTURE AND CONSTRUCTION
32682 APPROVED OCT 31 1969
OFFICE OF ARCHITECTURE & CONSTRUCTION

APPROVED BY
STATE FIRE MARSHAL

APPROVED BY
SCHOOL DISTRICT

KING BENIOFF STEINMANN KING
CONSULTING ENGINEERS
13101 RIVERSIDE DRIVE
SHERMAN OAKS, CALIF. 91403
DRAWN BY J.F.C. CHECKED BY DATE 12-25-69

ROOF FRAMING DETAILS 3"=1'-0"
BAKERSFIELD CITY S.D.
BAKERSFIELD, CALIFORNIA

SPEEDSPACE CORPORATION
Ver-I-Purpose RELOCATABLE BUILDINGS
P.O. Box 590 — Santa Rosa, California 95401
Telephone (707) 544-1661

AITC Licensed Plant No. M-140
L.A. City Licensed Fabricator No. 331

SPEEDSPACE JOB NO. 69132.5
SHEET NO. S-4
15 OF 31

PRINTED ON DIEPO NO. 1000H CLEARPRINT