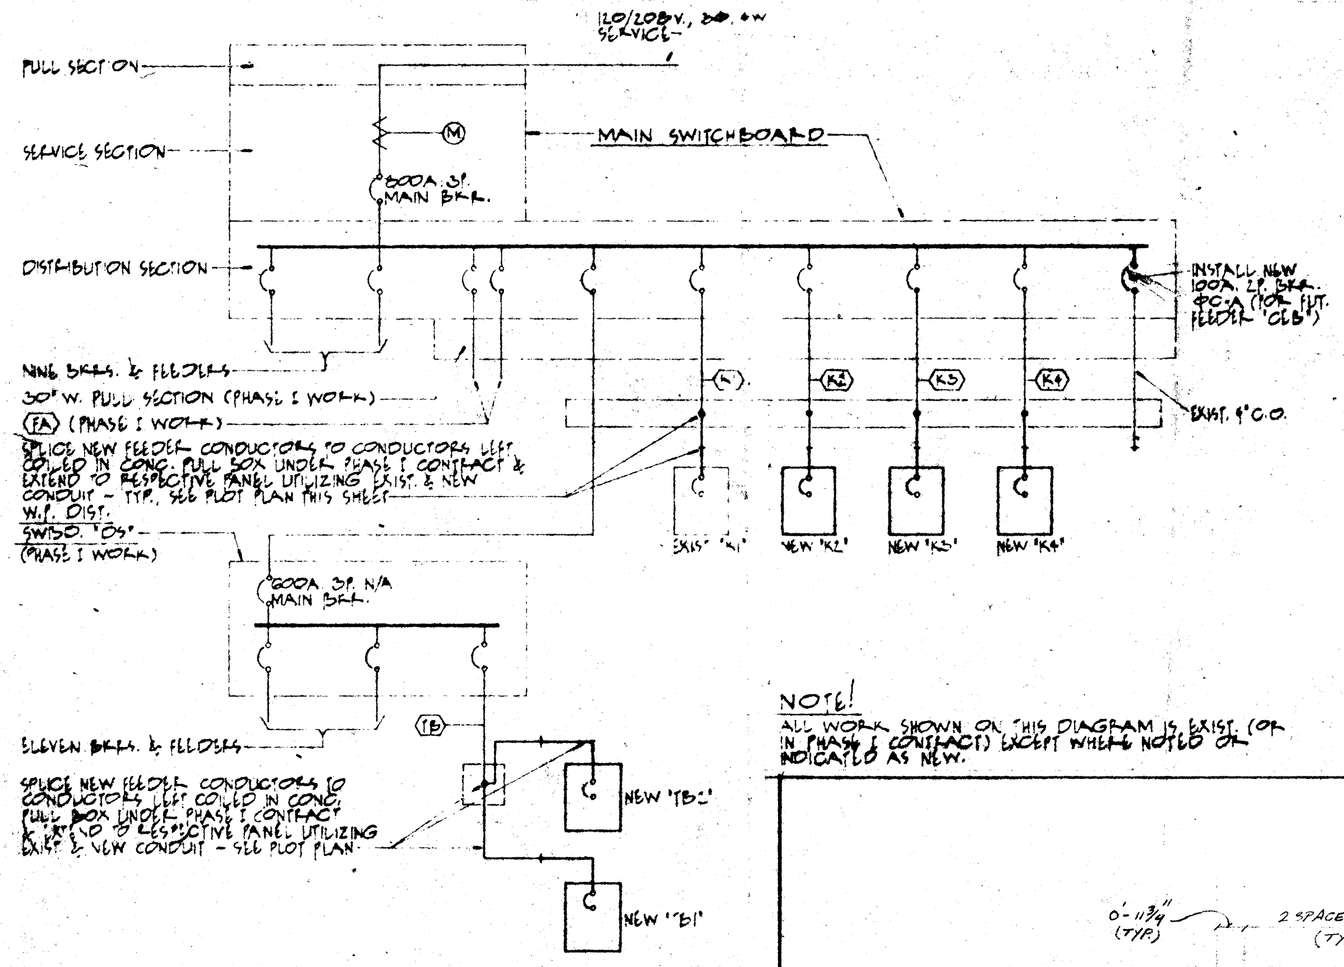

SINGLE LINE DIAGRAM

NOTE!
ALL WORK SHOWN ON THIS DIAGRAM IS EXIST. (OR IN PHASE I CONTRACT) EXCEPT WHERE NOTED OR INDICATED AS NEW.

FEEDER & LOAD SCHEDULE

	FEEDER DESIG.	COPPER		ALUMINUM		LOAD	
		CONDUCTOR SIZE	CONDUIT	CONDUCTOR SIZE	CONDUIT	KW	AMP.
*	K1	3#1/0	3"	3#300 MCM	3"	24.4	117
*	K2	3#1/0	3"	3#300 MCM	3"	24.5	119.5
*	K3	3#250 MCM	3"	3#350 MCM	3"	24.4	117
*	K4	3#250 MCM	3"	3#350 MCM	3"	24.4	117
**	CLB	3#1/0	2"	3#1/0	3"	19.2	80
*	TB	3#6	1"	———	———	7.2	30

FEEDER SCHEDULE NOTES:
1. * PORTIONS OF FEEDER CONDUIT & CONDUCTORS HAVE BEEN INSTALLED UNDER PHASE I CONTRACT. SEE SINGLE LINE DIAGRAM & PLOT PLAN, THIS SHEET, FOR EXTENSION OF FEEDER UNDER THIS CONTRACT.
2. ** FEEDER SHOWN FOR INFORMATION ONLY - ONLY THE NEW BREAKER & THE EXTENSION OF A PHASE I CONDUIT STUB-OUT ARE IN THIS CONTRACT.

NOTE: SEE SHEET E-1 FOR PANEL BOARD SCHEDULES

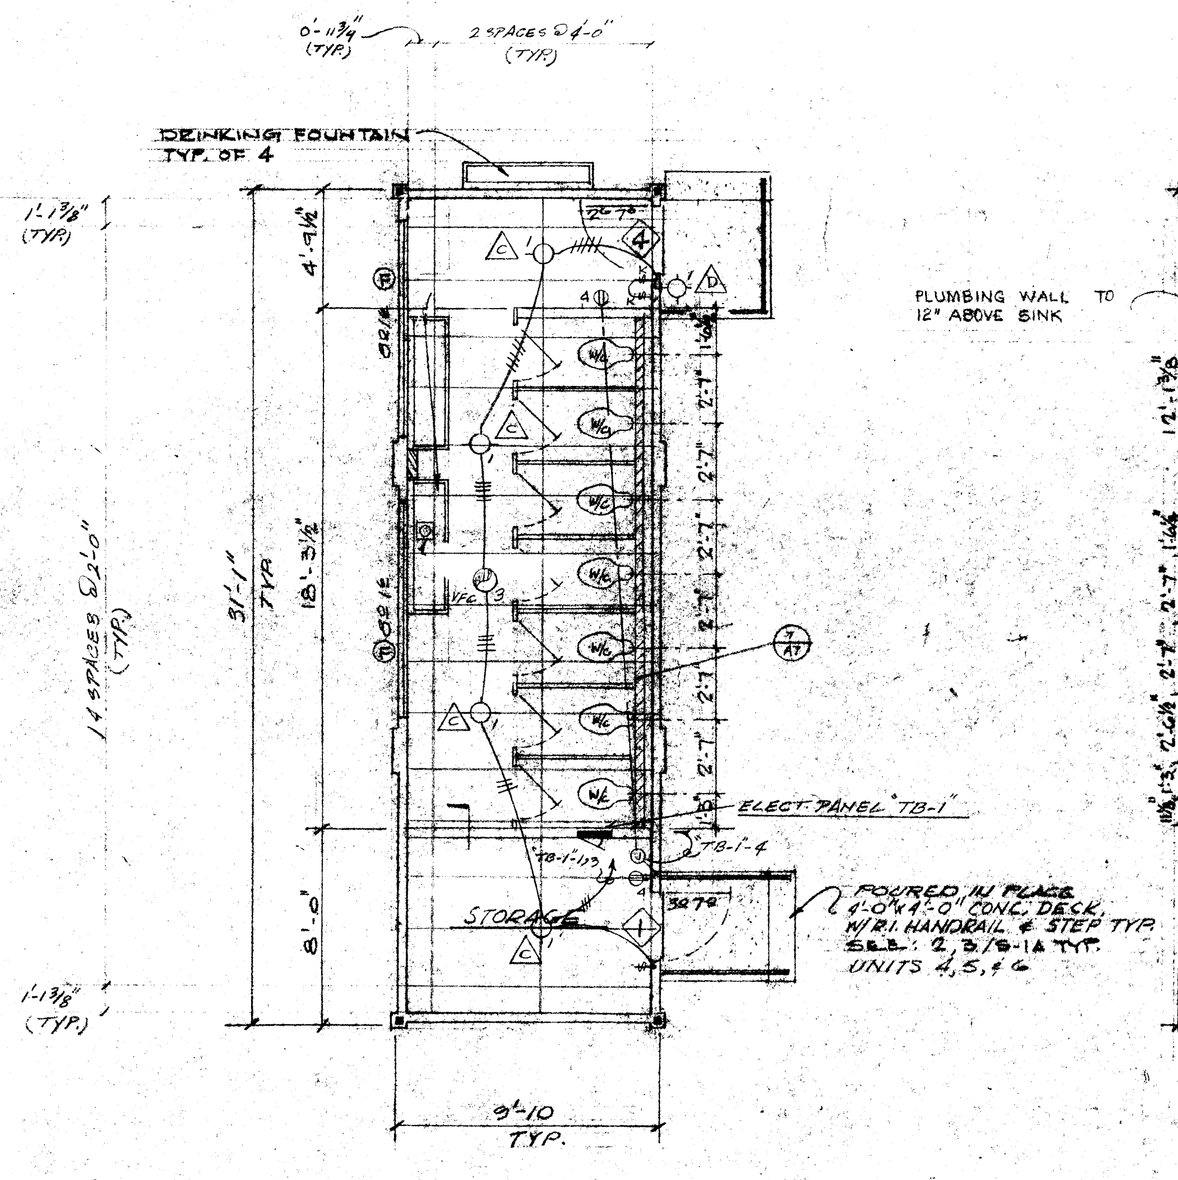

UNIT #4

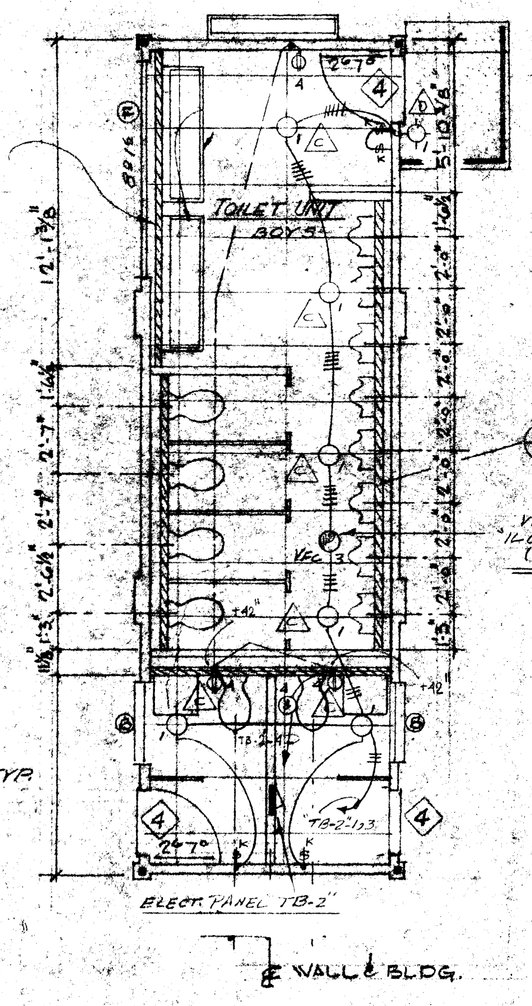

UNIT #5

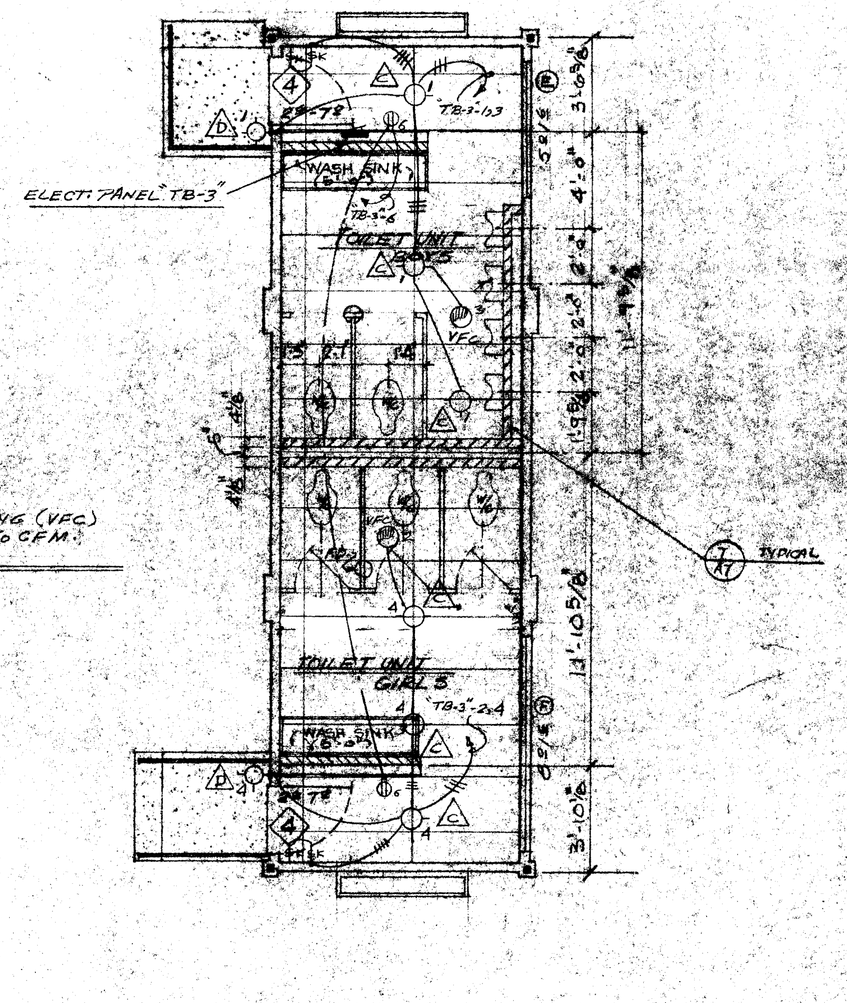

UNIT #6

N

UNITS 4 5 6

I-T	REVISION AS PER SCHOOL DISTRICT ARCHITECT CORRECTIONS	10/24/69	1
BY	REVISIONS	DATE	NO.

The acceptance of this plan set constitutes agreement that the design, shop drawing and specifications for the project noted shall be used solely for said project and shall not be exhibited, delivered or transferred to anyone or reused for additional projects in whole or in part without the written consent of Speedspace Corporation.

REFERENCE PLAN SET NO.

APPROVED BY — STATE OF CALIFORNIA — DEPARTMENT OF GENERAL SERVICES — OFFICE OF ARCHITECTURE AND CONSTRUCTION
32682 APPROVED OCT 31 1969
OFFICE OF ARCHITECTURE & CONSTRUCTION

APPROVED BY — STATE OF CALIFORNIA
STATE FIRE MARSHAL

APPROVED BY
SCHOOL DISTRICT

KING BEARDSLEY & BIGGS — CIVIL ENGINEERS — LAND SURVEYORS
Ben Bennett
J.P.C. 11/18/69

ELECTRICAL 1 1/4" = 1'-0"

BAKERSFIELD CITY S.D.
BAKERSFIELD, CALIFORNIA

SPEEDSPACE CORPORATION
Vari-Purpose RELOCATABLE BUILDINGS
P.O. Box 590 — Santa Rosa, California 95401
Telephone (707) 544-1661
Licensed Plant No. 140
L.A. City Licensed Fabricator No. 332

SPEEDSPACE JOB NO. 69-132-N
SHEET NO. E-2
2 OF 31 SHEETS

PRINTED ON DIEPO NO. 1000H BLEARPRINT 7-68