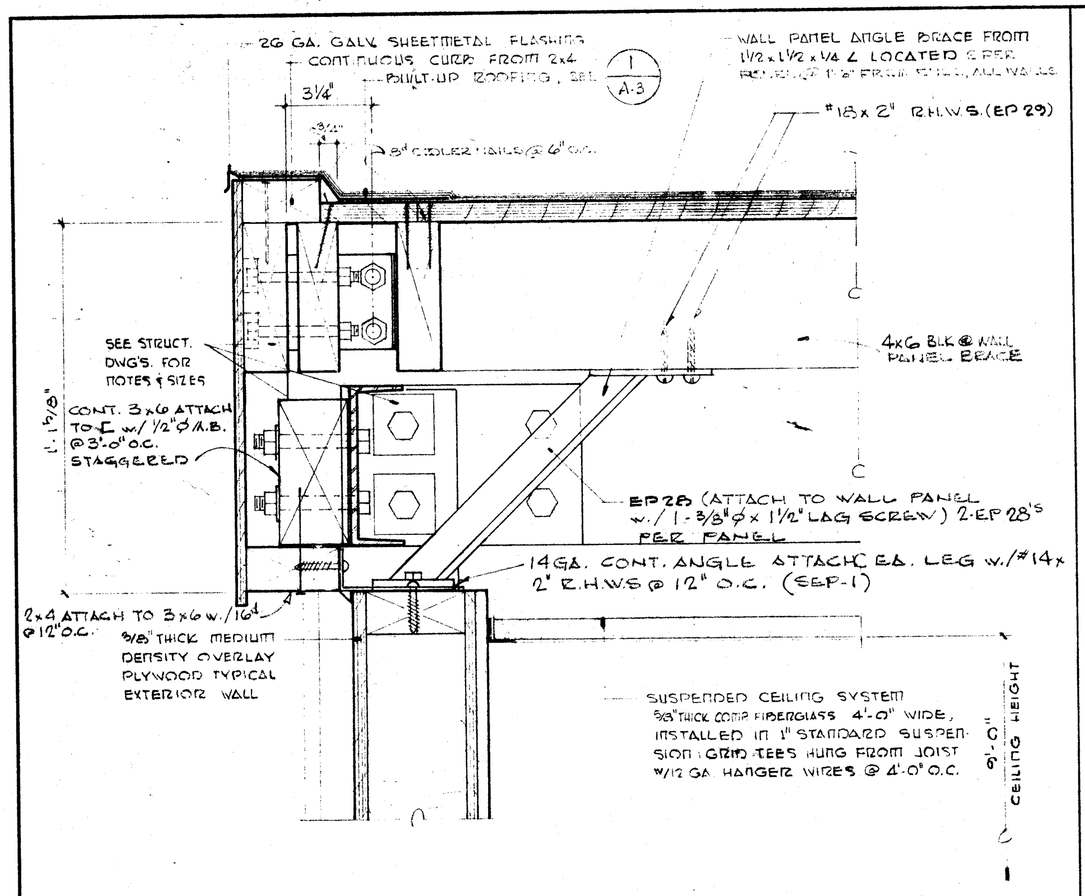

1 FASCIA & HEAD DETAIL
A-3A END WALL

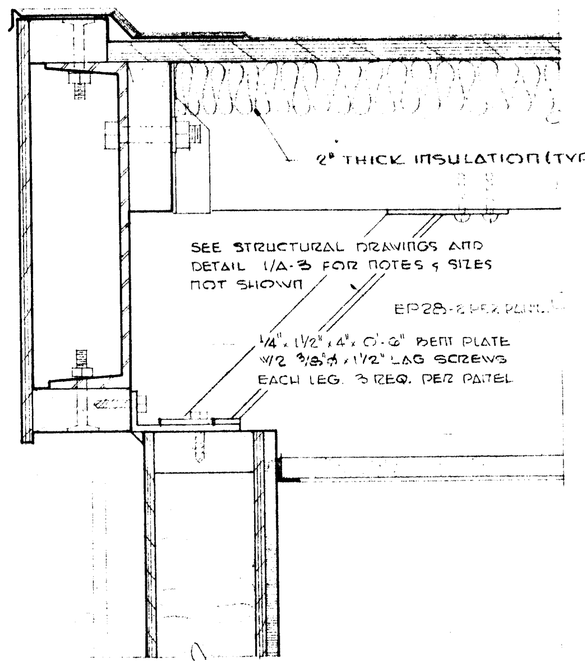

4 FASCIA & HEAD DETAIL
A-3A SIDE WALL

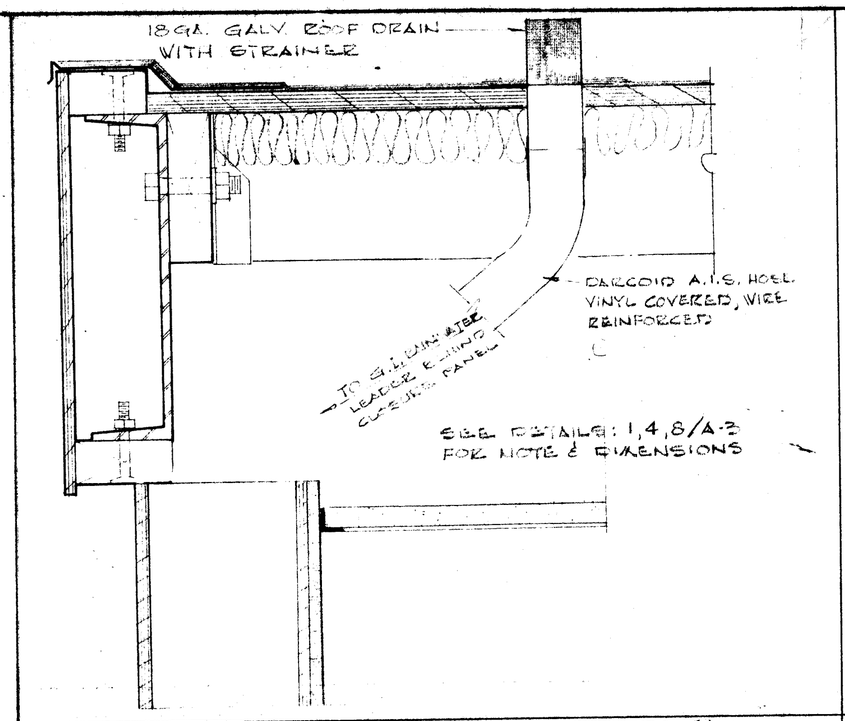

7 FASCIA & HEAD DETAIL
A-3 SIDE WALL CLOSURE PANEL

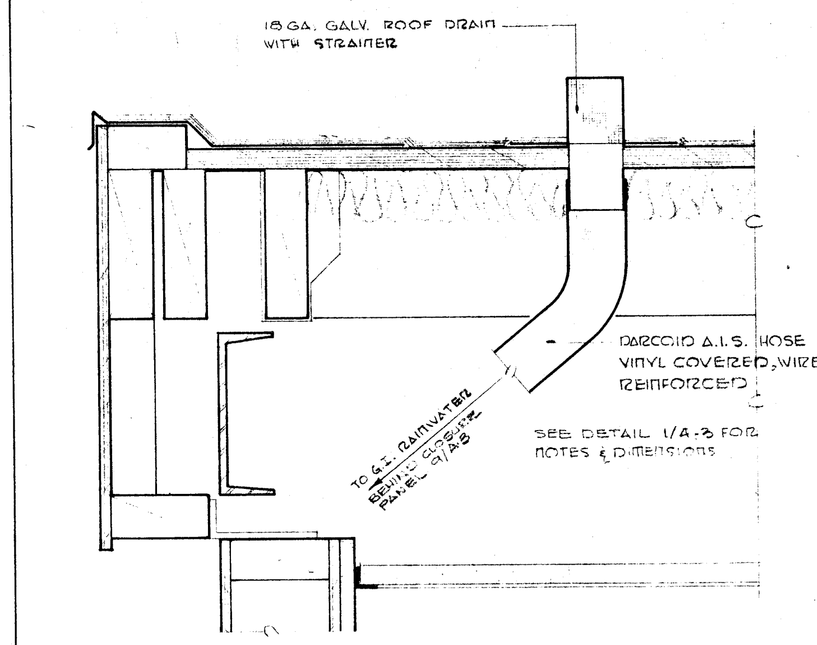

8 ROOF DRAIN DETAIL
A-3 END WALL

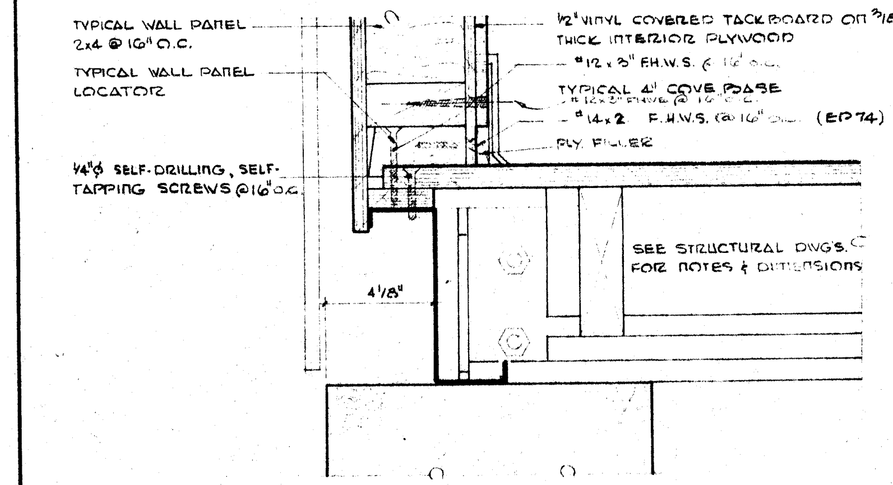

3 FLOOR & SILL DETAIL - CONCRETE FLOOR
A-3A END WALL

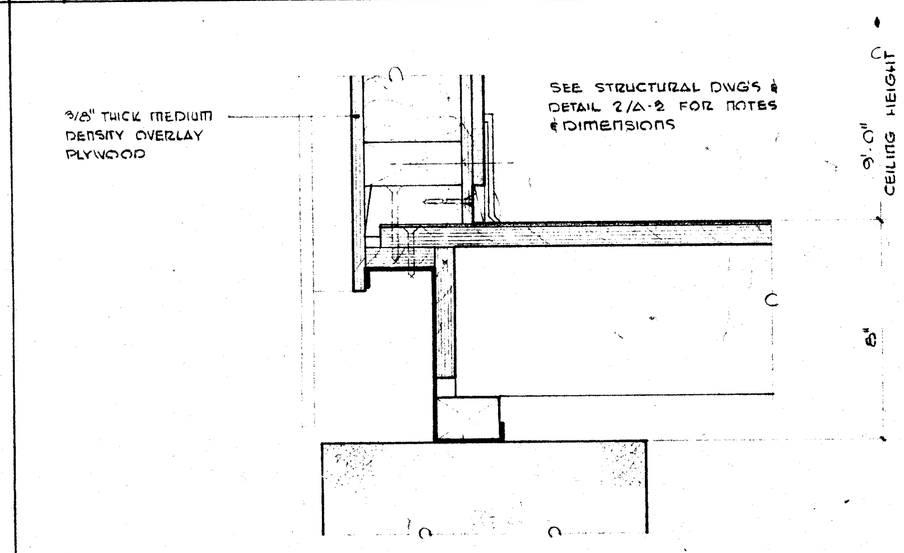

6 FLOOR & SILL DETAIL - CONCRETE FLOOR
A-3A SIDE WALL

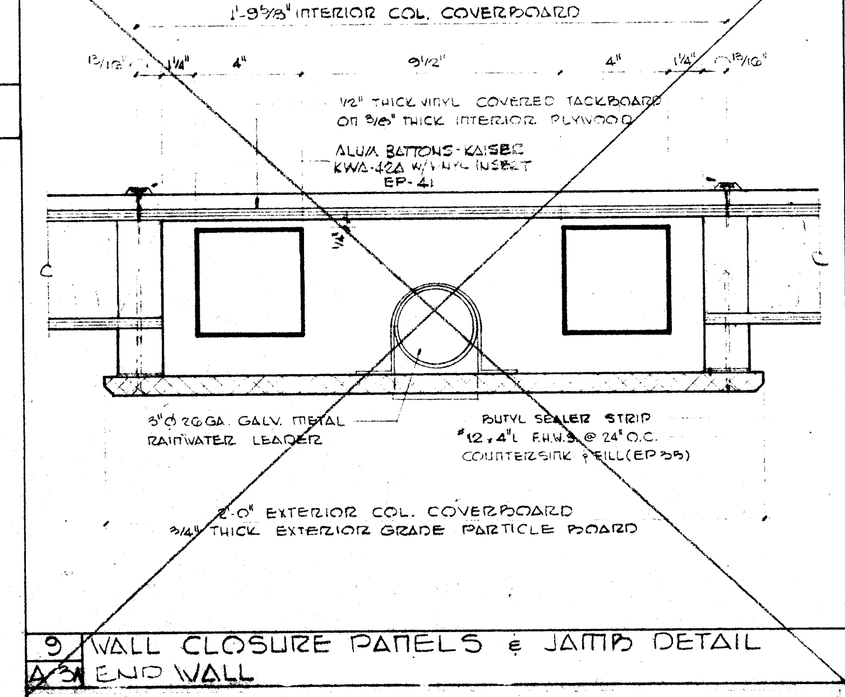

9 WALL CLOSURE PANELS & JAMB DETAIL
A-3 END WALL

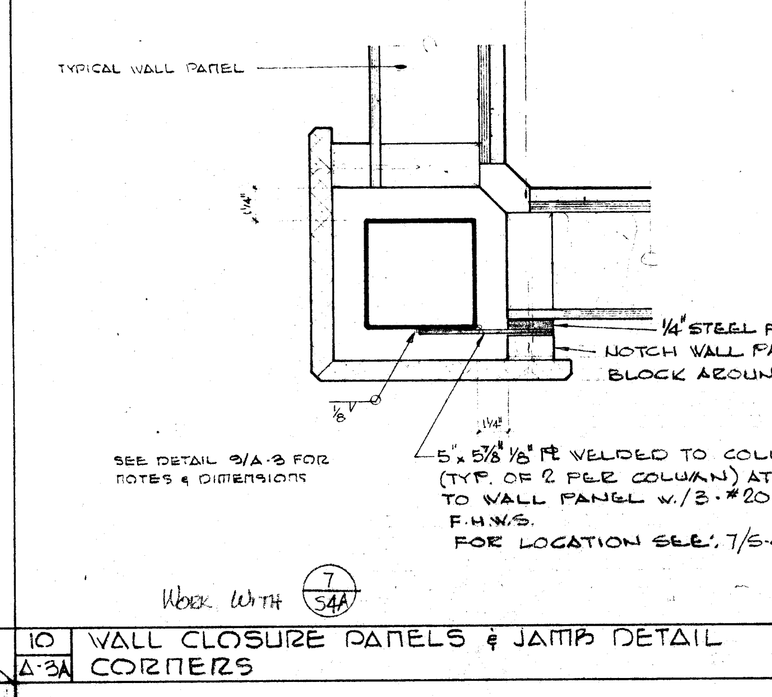

10 WALL CLOSURE PANELS & JAMB DETAIL
A-3A CORNERS

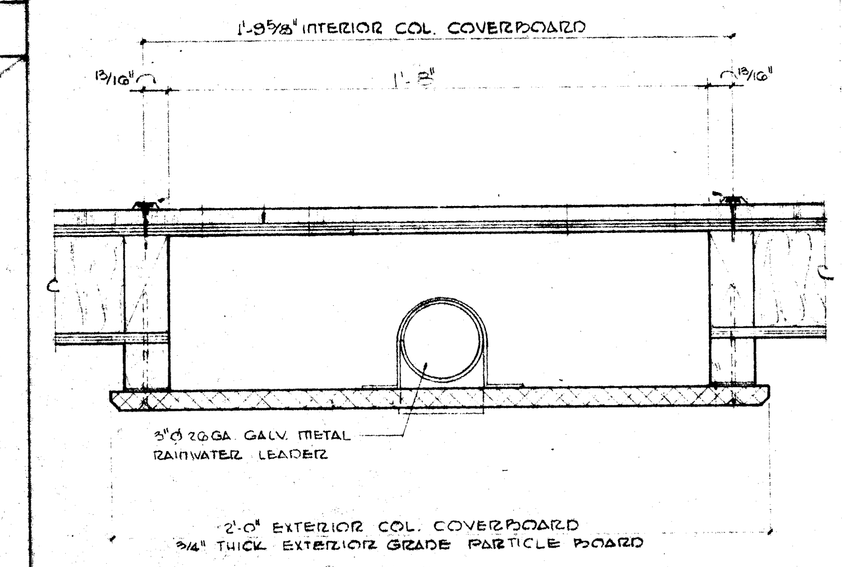

11 WALL CLOSURE PANELS & JAMB DETAIL
A-3A ICE WALL

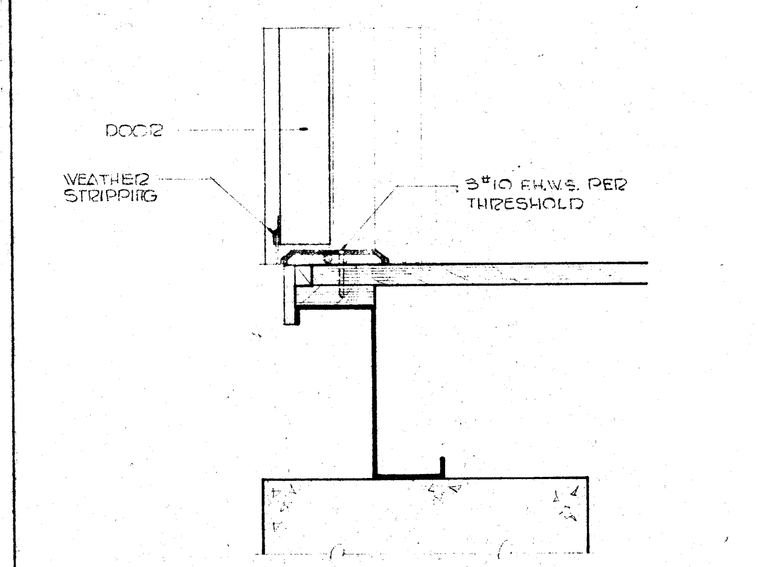

12 DOOR THRESHOLD DETAIL
A-3A STANDARD FLOOR ASSEMBLY

2 FLOOR & SILL DETAIL - STANDARD FLOOR ASSEMBLY
A-3A END WALL

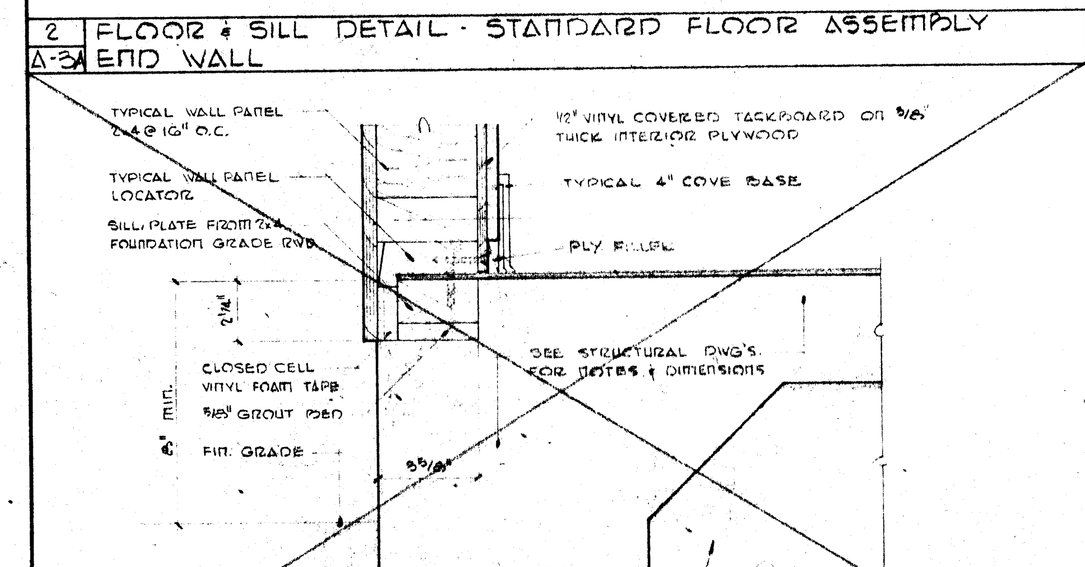

5 FLOOR & SILL DETAIL - STANDARD FLOOR ASSEMBLY
A-3A SIDE WALL

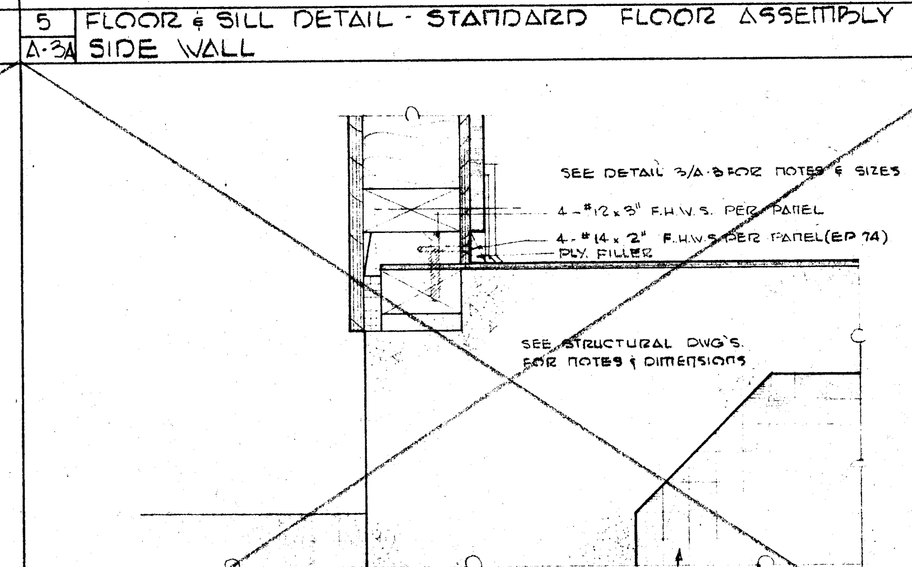

BY	REVISIONS	DATE	NO.

The acceptance of this plan set constitutes agreement that the design, shop drawing and specifications for the project noted shall be used solely for said project and shall not be exhibited, delivered or transferred to anyone or reused for additional projects in whole or in part without the written consent of Speedspace Corporation.

REFERENCE PLAN
SET NO.

APPROVED BY
STATE OF CALIFORNIA — DEPT. OF GENERAL SERVICES — OFFICE OF ARCHITECTURE AND CONSTRUCTION
32682 APPROVED OCT 31 1969
OFFICE OF ARCHITECTURE & CONSTRUCTION

APPROVED BY
STATE FIRE MARSHAL

APPROVED BY
SCHOOL DISTRICT

KING-BENIOFF-STEINMANN-KING
CONSULTING ENGINEERS
13731 RIVERSIDE DRIVE
SHERMAN OAKS, CALIF. 91403
DRAWN BY F.E.F. | CHECKED BY | DATE 9-29-69

ARCHITECTURAL DETAILS 3" = 1'-0"

BAKERSFIELD CITY S.D.
BAKERSFIELD, CALIF.

SPEEDSPACE CORPORATION
Vari-Purpose RELOCATABLE BUILDINGS
P.O. Box 590 — Santa Rosa, California 95401
Telephone (707) 544-1661
AITC QUALIFIED LICENSEE — Licensed Plant No. M-140 — L.A. City Licensed Fabricator No. 331

SPEEDSPACE JOB NO. 69-132-S
SHEET NO. A-3A
7 OF 31

PRINTED ON DIEPO NO. 1000H CLEARPRINT 4-68