FINISH SCHEDULE

UNITS #2,3

ROOM No.	ROOM NAME	FLOOR	BASE	WALLS NORTH	WALLS SOUTH	WALLS EAST	WALLS WEST	WAINSCOT MAT'L	WAINSCOT HT.	CEIL'G MAT'L	CEIL'G HT.	REMARKS
1	CLASS RM.	VAT.	6" TOPSET	VINYL TK. BD.	VINYL TK. BD.	VINYL TK. BD.	VINYL TK. BD.	MARLITE	9'-0"	3/8 FIB.GL.	9'-0"	MARLITE WAINSCOT AROUND ALCOVE ONLY
2	" "	"	"	do	do	do	do	MARLITE	9'-0"	3/8 FIB.GL.	9'-0"	MARLITE WAINSCOT AROUND ALCOVE ONLY
3	WORK RM.	"	"	GOLD BOND	GOLD BOND	"	GOLD BOND	—	9'-0"	3/8 FIB.GL.	9'-0"	
4	REST RM.	CER. TILE	4" CER. TILE	MARLITE	MARLITE	MARLITE	MARLITE	MARLITE	9'-0"	3/8 FIB.GL.	9'-0"	*SEE NOTE NO.1 BELOW
5	" "	do	do	do	do	do	do	do	9'-0"	3/8 FIB.GL.	9'-0"	*SEE NOTE NO.1 BELOW
6	TOILET	do	do	do	do	do	do	do	9'-0"	3/8 FIB.GL.	9'-0"	*SEE NOTE NO.1 BELOW
7	"	do	do	do	do	do	do	do	9'-0"	3/8 FIB.GL.	9'-0"	" " " "
8	"	do	do	do	do	do	do	do	9'-0"	3/8 FIB.GL.	9'-0"	" " " "
9	"	do	do	do	do	do	do	do	9'-0"	3/8 FIB.GL.	9'-0"	" " " "
	UNIT #1											
1	CLASS RM.	VAT.	6" TOPSET	VINYL TK. BD.	VINYL TK. BD.	VINYL TK. BD.	VINYL TK. BD.	MARLITE	9'-0"	3/8 FIB. GL.	9'-0"	MARLITE WAINSCOT AROUND ALCOVE ONLY
2	WORK RM.	"	"	do	GOLD BOND	GOLD BOND	do	—	—	3/8 FIB. GL.	9'-0"	
3	REST RM.	CER. TILE	4" CER. TILE	MARLITE	MARLITE	MARLITE	MARLITE	MARLITE	9'-0"	3/8 FIB. GL.	9'-0"	*SEE NOTE NO.1 BELOW
4	TOILET	CER. TILE	do	do	do	do	do	do	9'-0"	3/8 FIB. GL.	9'-0"	" " " "
5	"	CER. TILE	do	do	do	do	do	do	9'-0"	3/8 FIB. GL.	9'-0"	" " " "
6	STORAGE	VAT.	6" TOPSET	GOLD BOND	3/8" P.W. PAINT'D	3/8" P.W. PAINT'D	3/8" P.W. PAINT'D	—	—	5/8 FIB. GL.	9'-0"	

NOTE /
1. ALL WALLS IN ALL TOILETS TO BE MARLITE.
2. MIRRORS TO BE: 14" x 18" FPG w/ METAL EDGE T.P. (MIRRORS TO BE PROVIDED OVER ALL LAVATORIES) TASPER PROOF HANGERS
3. VINYL ASBESTOS TILE SHALL BE 3/32" THICK !!

DOOR SCHEDULE

TYPE	SIZE WIDTH	SIZE HEIGHT	DETAILS HEAD DET. No.	DETAILS HEAD SHT. No.	DETAILS JAMB DET. No.	DETAILS JAMB SHT. No.	DETAILS SILL DET. No.	DETAILS SILL SHT. No.	GLASS TYPE	GLASS SIZE	LOUVERS	REMARKS
1	3'-0"	7'-0"	1	A5	1	A5	12	A3	—	—	—	MET. H.C.
2	2'-8"	6'-8"	13	A7	13	A7	—	—	—	—	—	WD. H.C.
3	2'-4"	6'-8"	13	A7	13	A7	—	—	—	—	—	WD. H.C.
4	2'-6"	7'-0"	1	A5	1	A5	12	A3	—	—	—	MET. H.C.

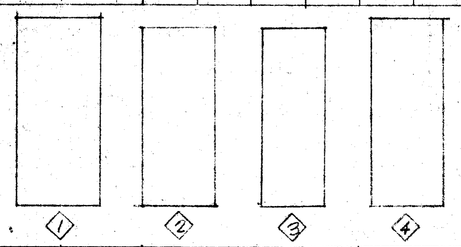

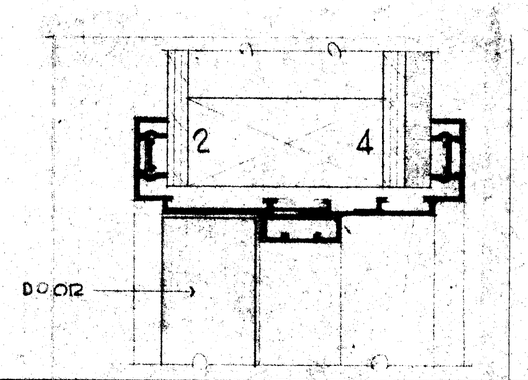

1/A5 DOOR HEAD (EXT.) JAMB SIM. 1/2 SIZE

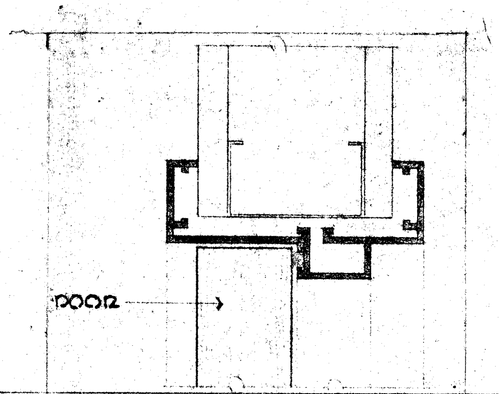

2/A5 DOOR HEAD (INT.) JAMB SIM. 1/2 SIZE

WINDOW SCHEDULE

TYPE	NOM. SIZE WIDTH	NOM. SIZE HEIGHT	DETAILS HEAD DET. No.	DETAILS HEAD SHT. No.	DETAILS JAMB DET. No.	DETAILS JAMB SHT. No.	DETAILS SILL DET. No.	DETAILS SILL SHT. No.	GLASS	REMARKS
A	8'-0"	4'-0"	3	A5	4	A5	5	A5	GRAYLITE	SLIDING w./ SCREENS
B	3'-0	1'-6"	3	A5	4	A5	5	A5	OBSCURE	do
C	4'-0"	1'-6"	3	A5	4	A5	5	A5	GRAYLITE	SLIDING w./ SCREENS
D	6'-0"	1'-6"	3	A5	4	A5	5	A5	do	FIXED
E	5'-8"	1'-6"	3	A-5	4	A-5	5	A-5	GRAYLITE	SLIDING w./ SCREENS
F	8'-0"	1'-6"	3	A-5	4	A-5	5	A-5	do	do

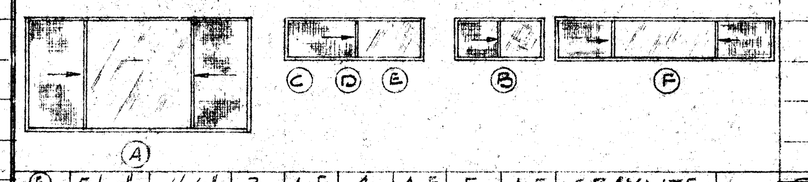

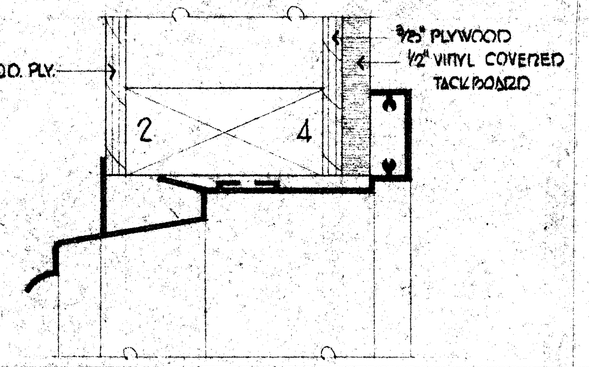

3/A5 WINDOW HEAD (EXT.) 1/2 SIZE

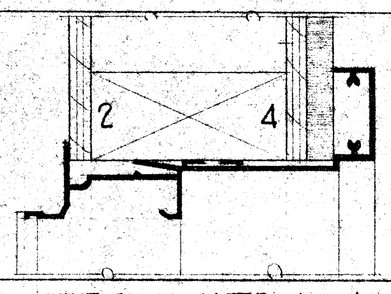

4/A5 WINDOW JAMB (EXT.) 1/2 SIZE

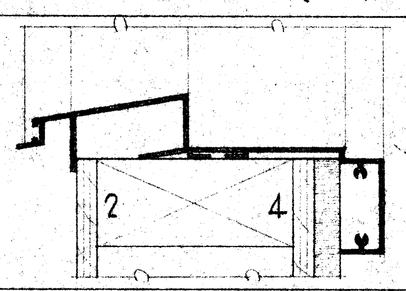

5/A5 WINDOW SILL (EXT.) 1/2 SIZE

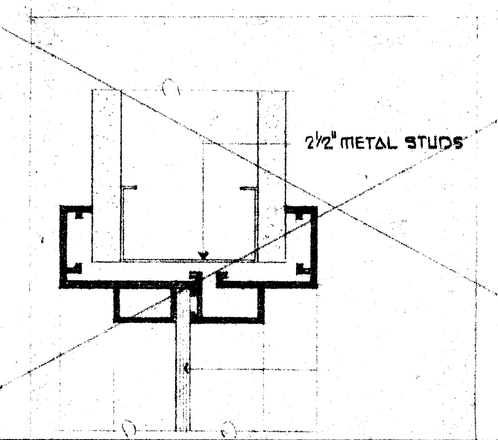

6/A5 WINDOW HEAD (INT.) JAMB & SILL SIM. 1/2 SIZE

BY	REVISIONS	DATE	NO.
E.E.F.	REVISED P&E ARCHITECTS CHECK SET	10-22-69	1

The acceptance of this plan set constitutes agreement that the design, shop drawing and specifications for the project noted shall be used solely for said project and shall not be exhibited, delivered or transferred to anyone or in part without the written consent of Speedspace Corporation.

REFERENCE PLAN SET NO.

APPROVED BY — STATE OF CALIFORNIA — DEPARTMENT OF GENERAL SERVICES, OFFICE OF ARCHITECTURE AND CONSTRUCTION — 32682 APPROVED OCT 31 1969 — OFFICE OF ARCHITECTURE & CONSTRUCTION

APPROVED BY — APPROVED STATE FIRE MARSHAL STATE OF CALIFORNIA DATE OCT 31 1969 — STATE FIRE MARSHAL

APPROVED BY — SCHOOL DISTRICT

KING-DENIOFF-STEINMANN-KING CONSULTING ENGINEERS 14001 RIVERSIDE DRIVE SHERMAN OAKS, CALIF. 91403 — DRAWN BY: J.P.C. — CHECKED BY: — DATE: 9/25/69

SCHEDULE - INTERIOR ELEVATIONS

BAKERSFIELD CITY SCH. DIST.
BAKERSFIELD, CALIFORNIA

SPEEDSPACE CORPORATION
Var-I-Purpose RELOCATABLE BUILDINGS
P.O. Box 590 — Santa Rosa, California 95401
Telephone (707) 544-1661

AITC — Licensed Plant No. 140 — L.A. City Licensed Fabricator No. 331

SPEEDSPACE JOB NO. 5-132-5

SHEET NO. A-5
8 OF 31

PRINTED ON DIEPO NO. 1000H CLEARPRINT 1-69