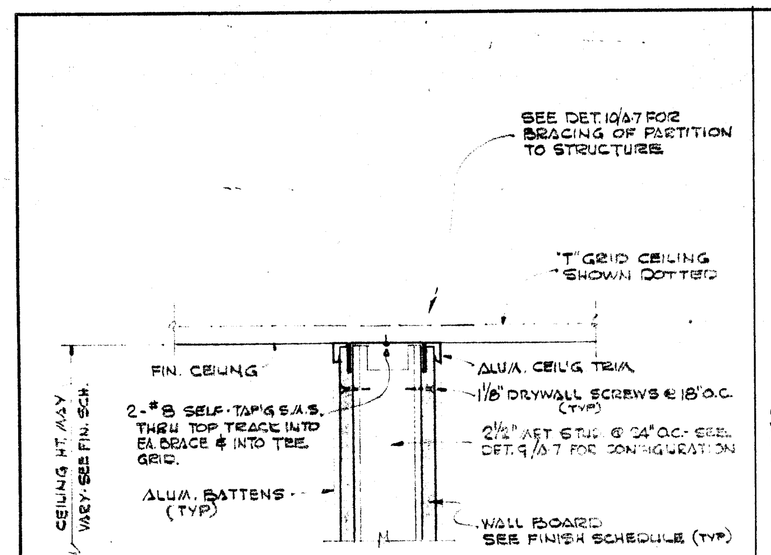

1 | A-7 METAL STUD PARTITION - HEAD DETAIL AT CEILING LINE

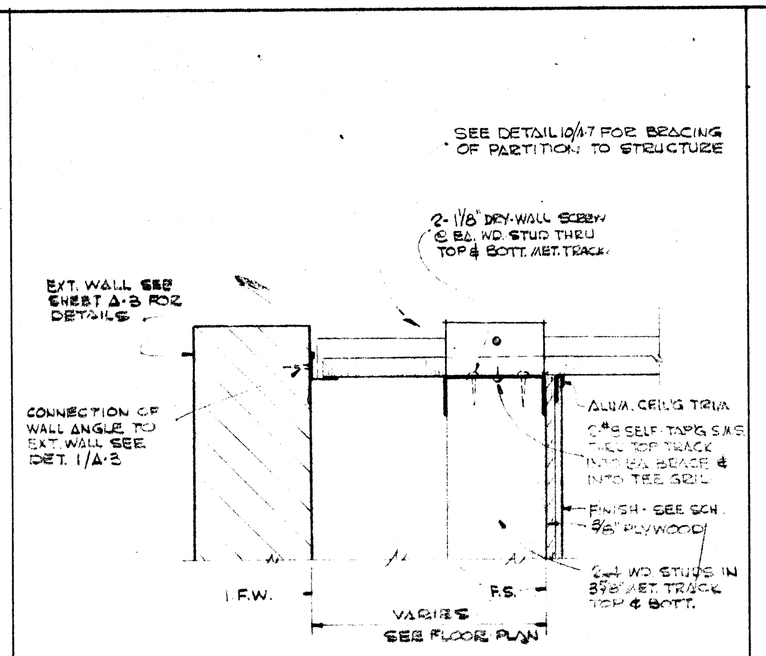

4 | A-7 SINGLE PLUMBING WALL - HEAD DETAIL - ADJACENT TO EXTERIOR WALL

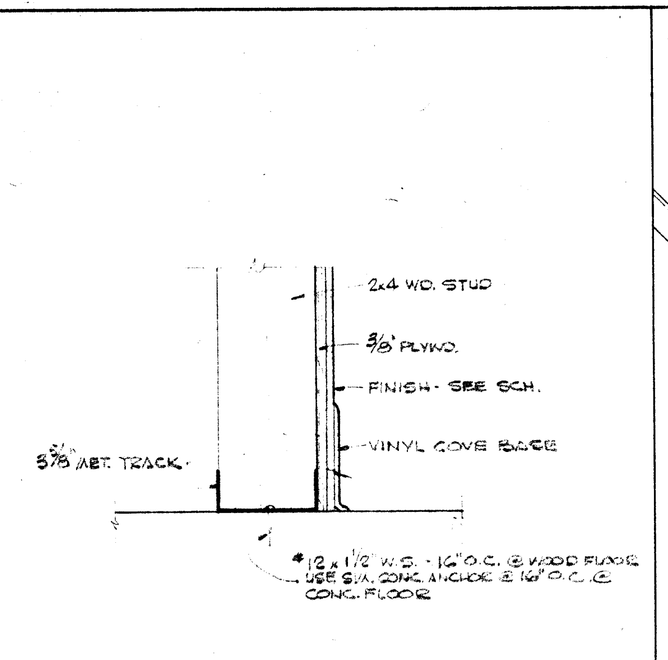

7 | A-7 SILL @ PLUMBING WALL

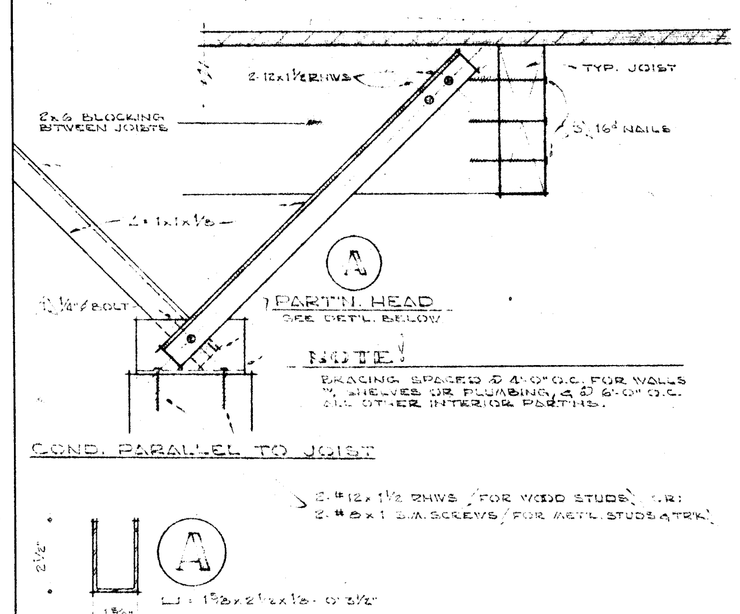

10 | A-7 PARTITION HEAD BRACING DETAIL

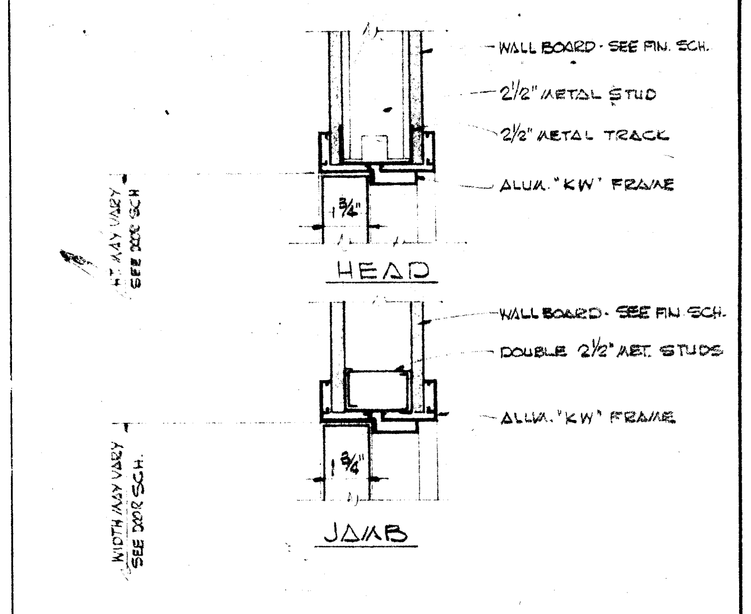

13 | A-7 TYPICAL INTERIOR DOOR DETAILS

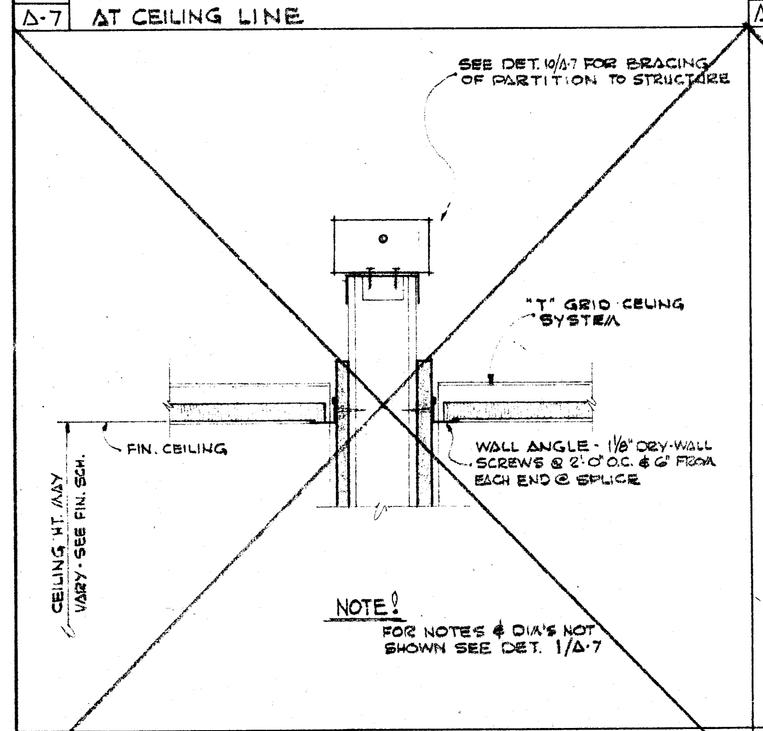

2 | A-7 METAL STUD PARTITION - HEAD DETAIL THRU CEILING LINE

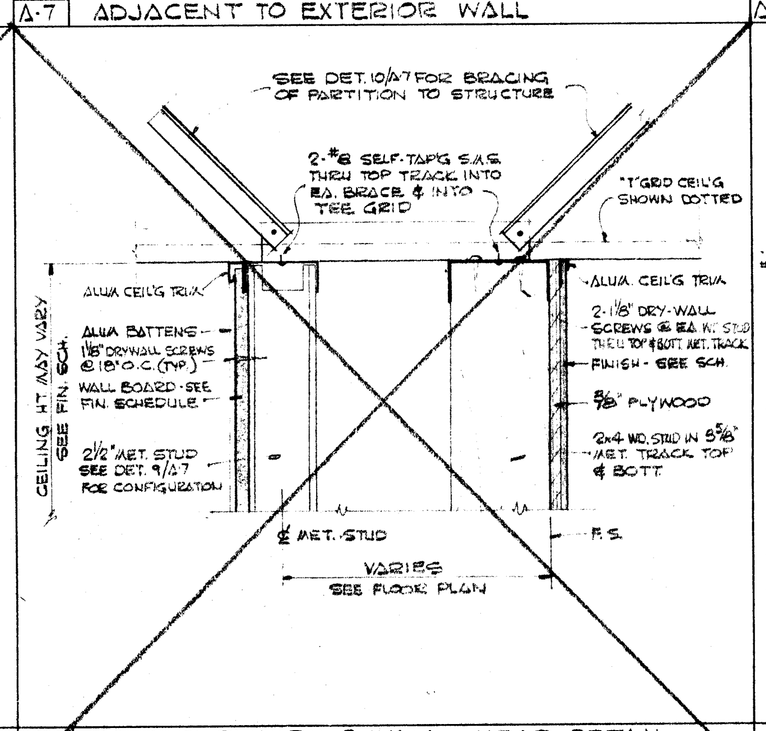

5 | A-7 SINGLE PLUMBING WALL - HEAD DETAIL - ADJACENT TO METAL STUD PARTITION

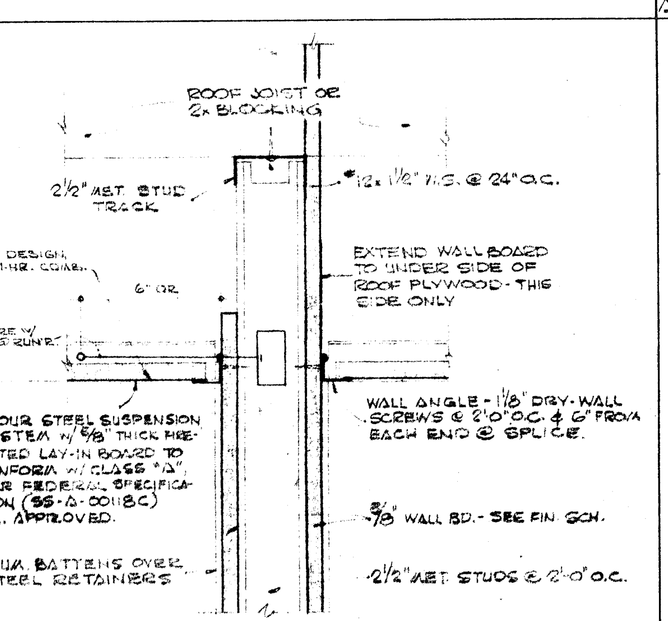

8 | A-7 HEAD DETAIL AT 1 HOUR WALL & CEILING (SILL SIM. TO DET. 5/A-7)

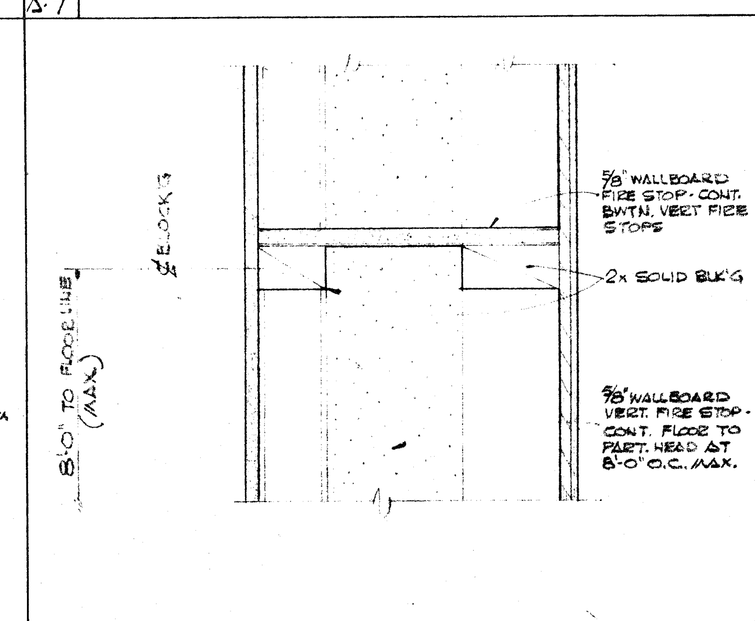

11 | A-7 TYPICAL FIRE STOP DETAIL AT PLUMBING WALLS

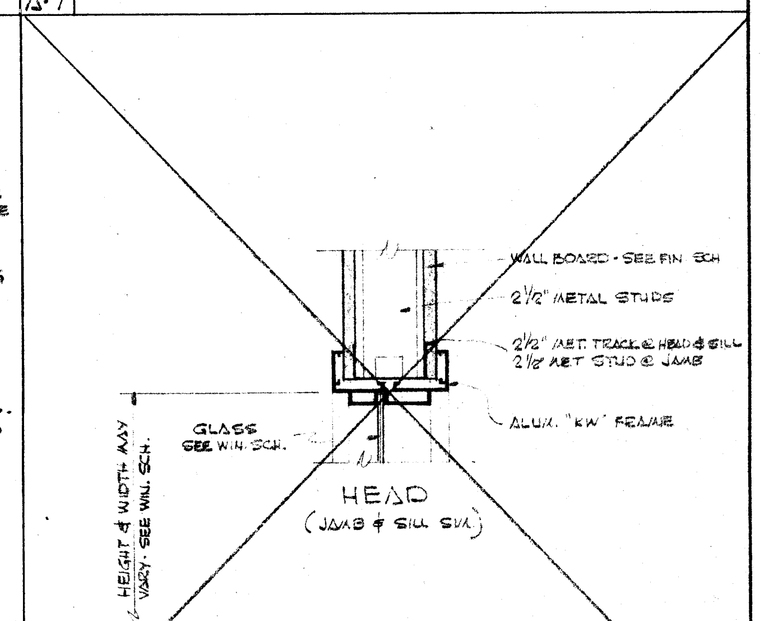

14 | A-7 TYPICAL BORROWED LIGHT DETAILS

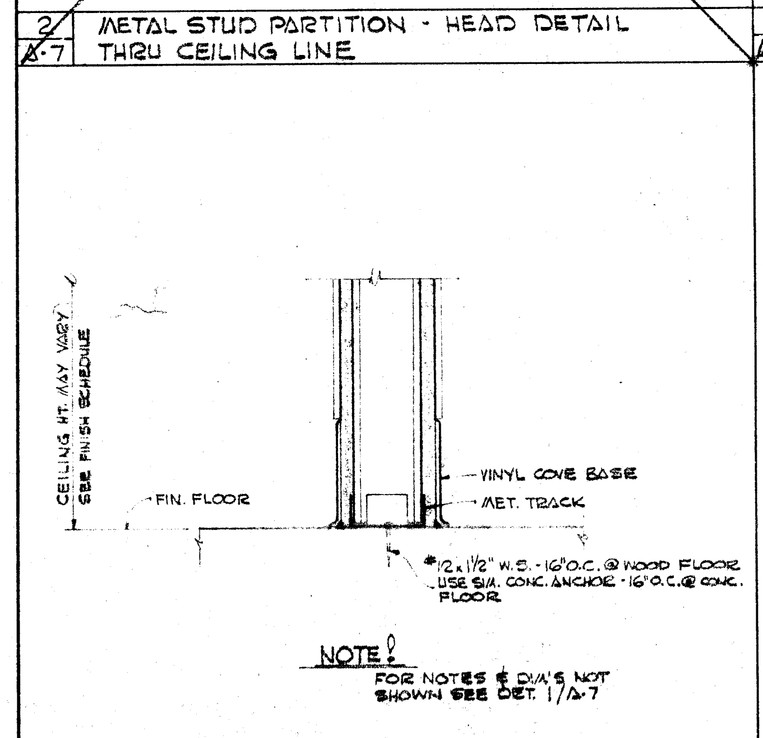

3 | A-7 METAL STUD PARTITION - SILL DETAIL - TYPICAL

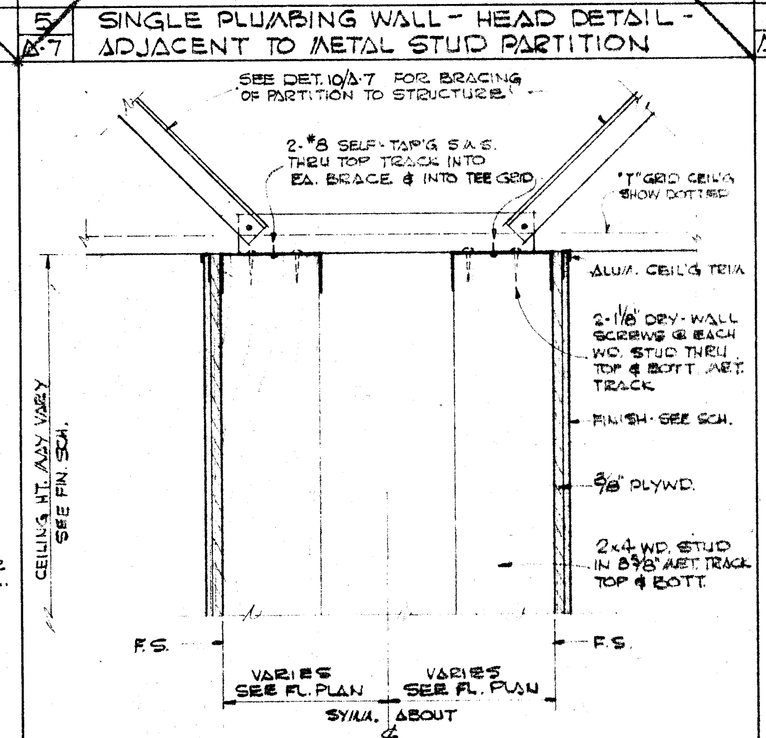

6 | A-7 DOUBLE PLUMBING WALL - HEAD DETAIL -

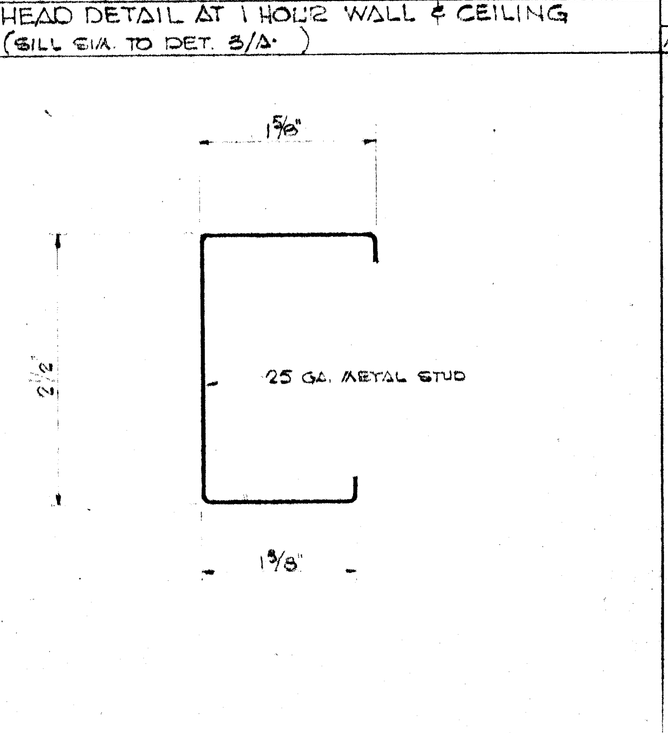

9 | A-7 TYPICAL METAL STUD CONFIGURATION

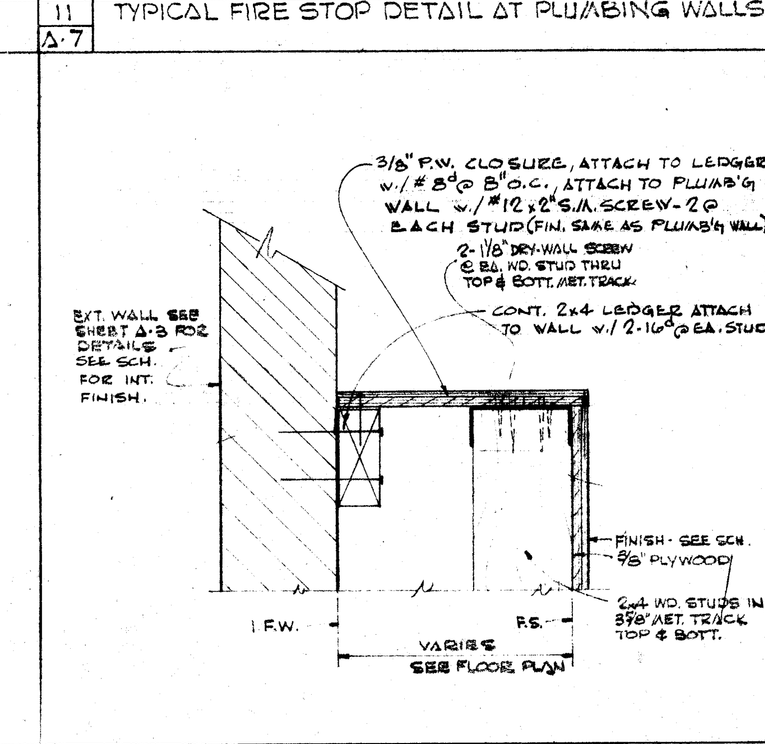

12 | A-7 LOW PLUMBING WALL - HEAD DETAIL - ADJACENT TO EXTERIOR WALL

NO.	DATE	REVISIONS	BY
1	10-22-69	REVISED PER ARCHITECTS CHECK SET	E.G.F.

REFERENCE PLAN SET NO.

The acceptance of this plan set constitutes agreement that the design, shop drawing and specifications for the project noted shall be used solely for said project and shall not be exhibited, delivered or transferred to anyone or reused for additional projects in whole or in part without the written consent of Speedspace Corporation.

APPROVED BY
STATE OF CALIFORNIA — DEPARTMENT OF GENERAL SERVICES — OFFICE OF ARCHITECTURE AND CONSTRUCTION
32682 APPROVED OCT 31 1969
OFFICE OF ARCHITECTURE & CONSTRUCTION

APPROVED BY
STATE FIRE MARSHAL

APPROVED BY
SCHOOL DISTRICT

KING BENIOFF-STEINMANN-KING
CONSULTING ENGINEERS
FIRST RESIDENT BANK
BAKERSFIELD, CALIF. 93305

DRAWN BY: E.G.F. | CHECKED BY: | DATE: 9/29/69

ARCHITECTURAL DETAILS
INTERIOR PARTITIONS
SCALE: 3"=1'-0"

BAKERSFIELD CITY S.D.
BAKERSFIELD, CALIF.

SPEEDSPACE CORPORATION
Var-I-Purpose RELOCATABLE BUILDINGS
P.O. Box 590 — Santa Rosa, California 95401
Telephone (707) 544-1661

AITC — American Institute of Timber Construction — Qualified Licensee
Licensed Plant No. 140
L. A. City Licensed Fabricator No. 331

SPEEDSPACE JOB NO. 69-132-5
SHEET NO. A-7
9 OF 31

PRINTED ON DIEPO NO. 1000H CLEARPRINT 1-69