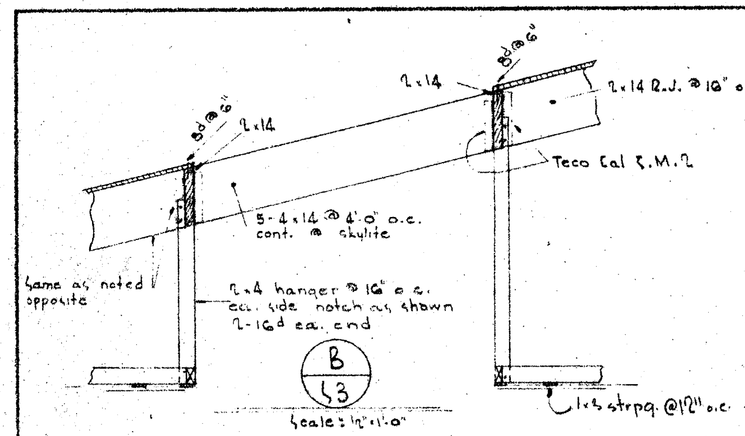

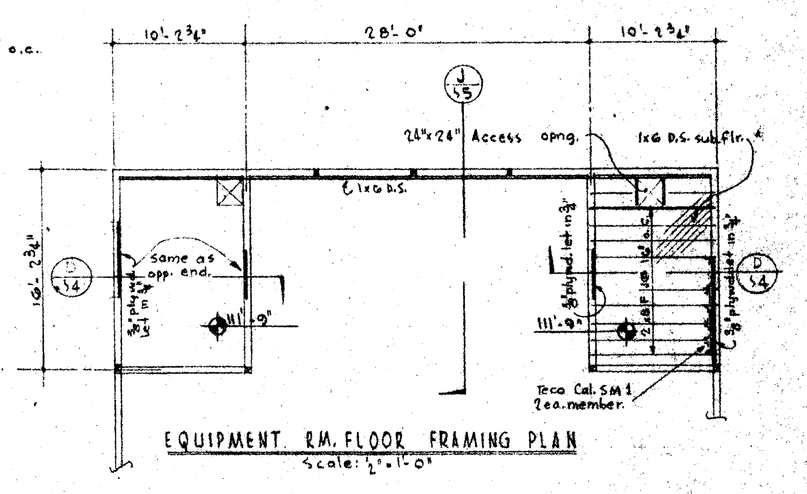

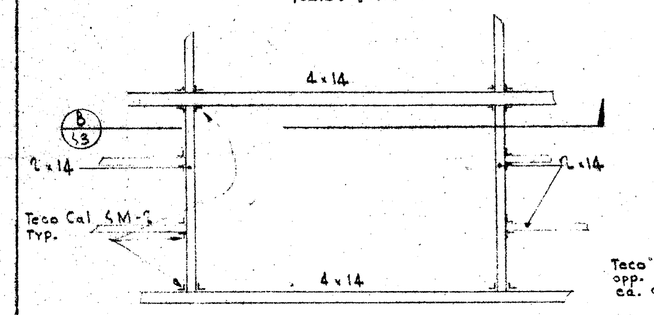

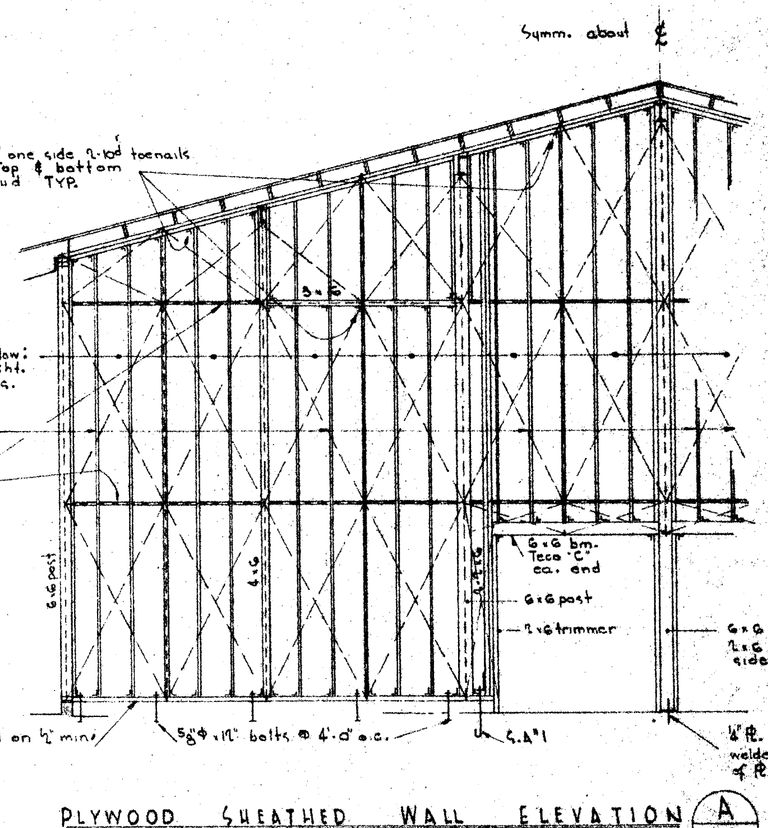

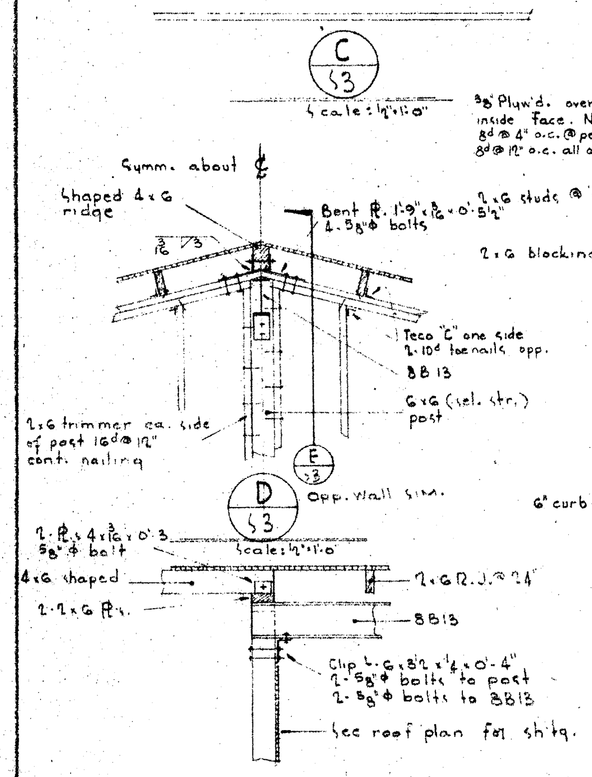

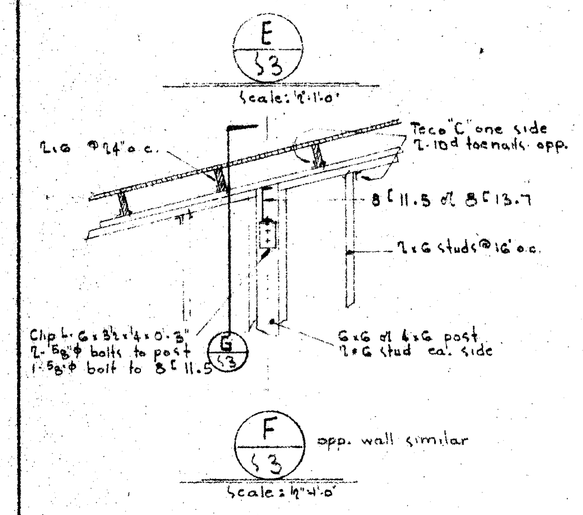

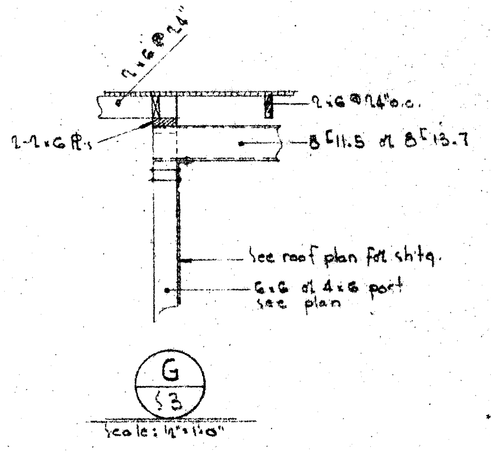

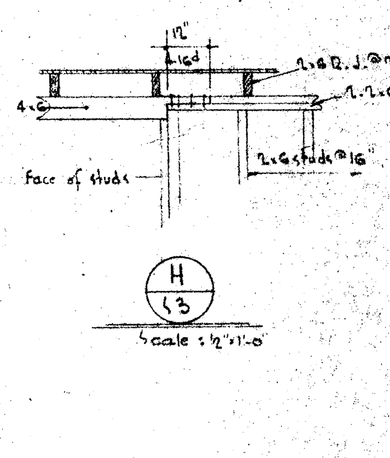

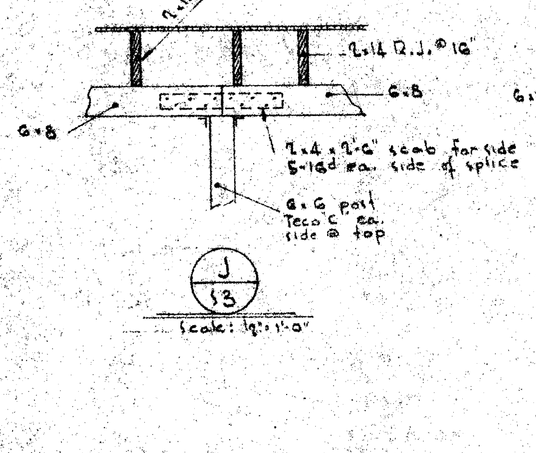

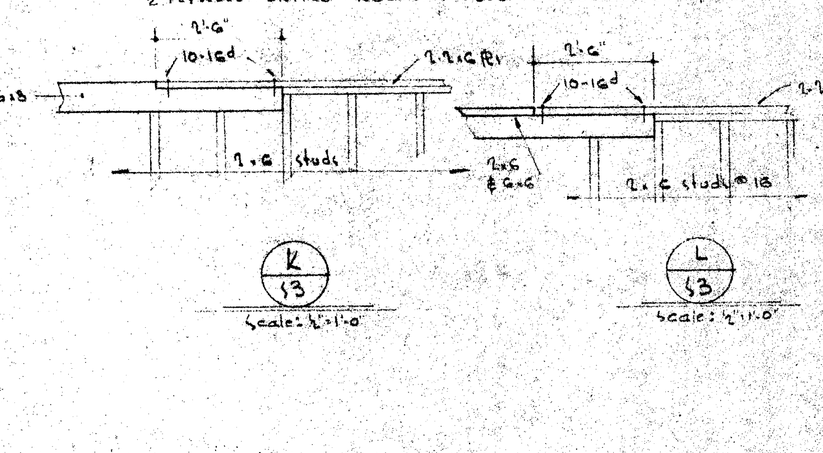

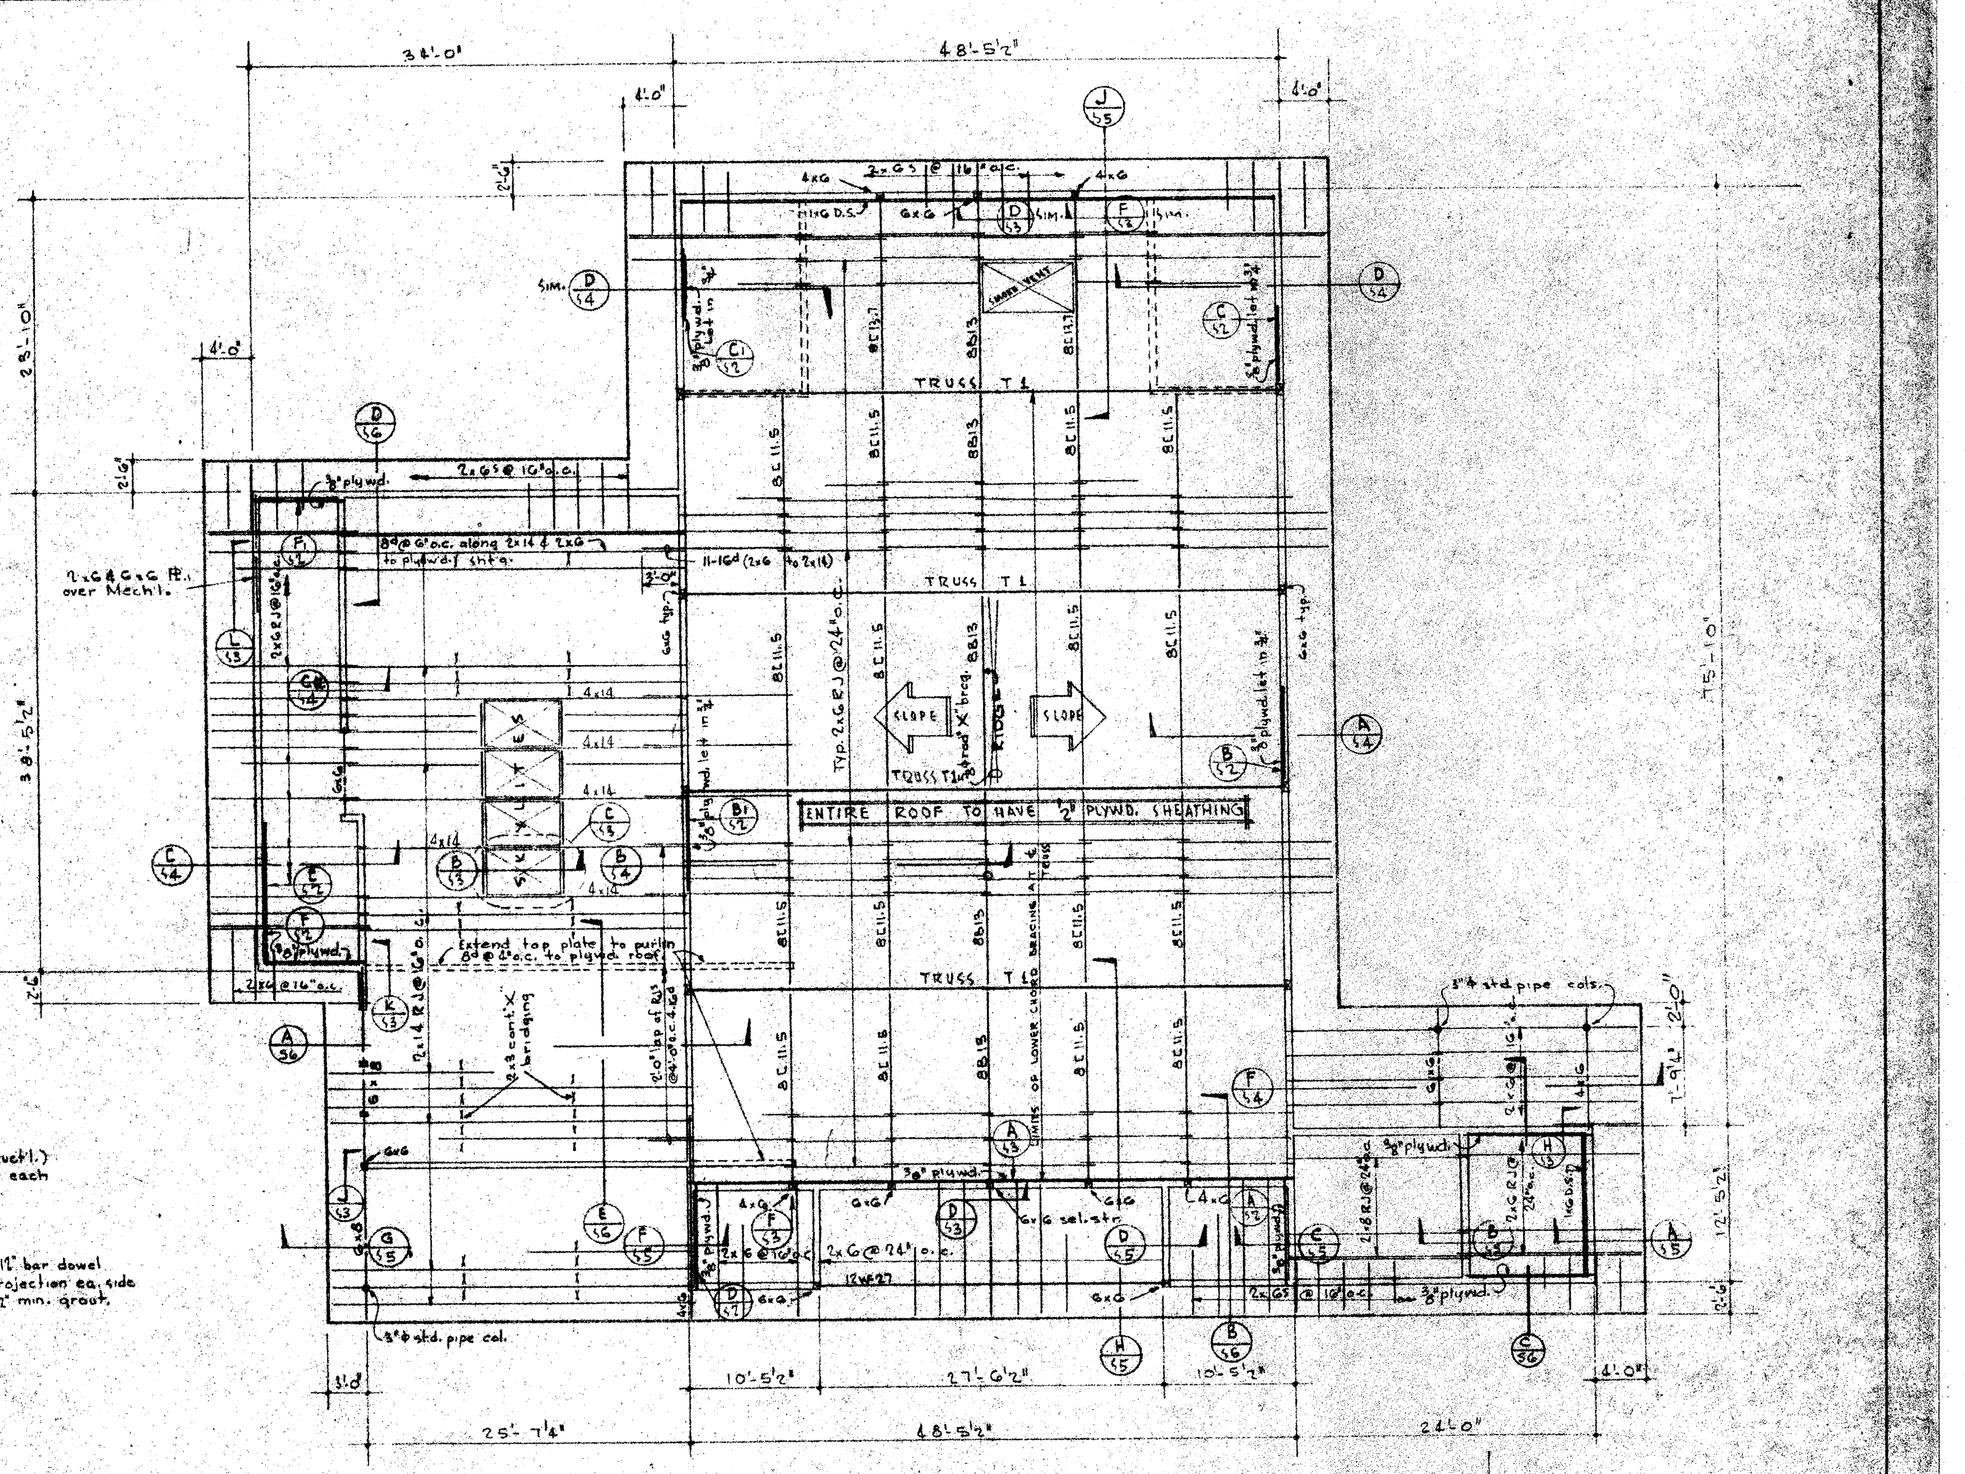

ROOF FRAMING PLAN

Scale: 1/8" = 1'-0"

REFER AND CHECK WITH ARCH'L. DRWGS. FOR ROOF SLOPES, GUTTERS, VENTS, SADDLES ETC. AND DIMENSIONS. NOT SHOWN.
1/2" PLYWOOD ENTIRE ROOF. —— D.S. = DIAGONAL SHEATHING.

APPROVED BY BOARD OF EDUCATION BAKERSFIELD CITY SCHOOL DISTRICT
DATE 9/26/58 19
BY John R. Compton
SUPERINTENDENT OF SCHOOLS EXECUTIVE OFFICER

STATE OF CALIFORNIA — DEPARTMENT OF PUBLIC WORKS DIVISION OF ARCHITECTURE
19177 APPROVED SEP 15 1958
APPLICATION NO. Por

• ROOF FRAMING PLAN •
• MULTI-PURPOSE ROOM •
• MT. VERNON SCHOOL •
• BAKERSFIELD CITY SCHOOL DISTRICT •

C. barton alford
ARCHITECT
1516 CALIFORNIA AVENUE BAKERSFIELD, CALIFORNIA
A.I.A.

S 3