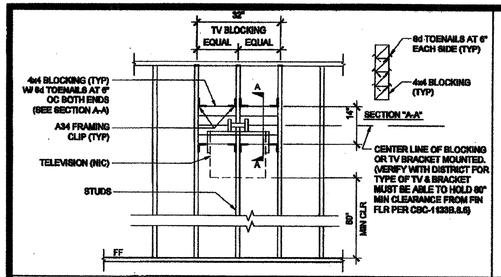

T.V. BLOCKING ATTACHMENT AT WOOD STUD SCALE : 1/2" = 1'-0" 16

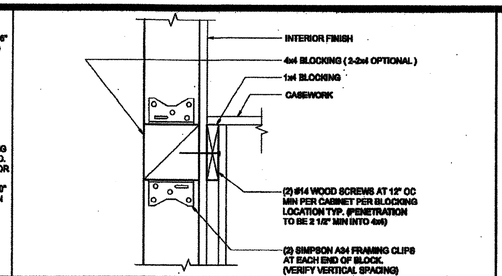

ATTACHMENT TO BLOCKING AT WOOD STUD SCALE : 3" = 1'-0" 11

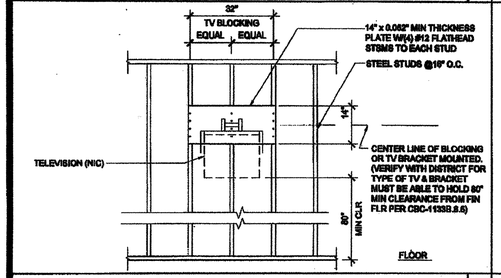

T.V. BLOCKING ATTACHMENT AT STEEL STUD SCALE : 1/2" = 1'-0" 17

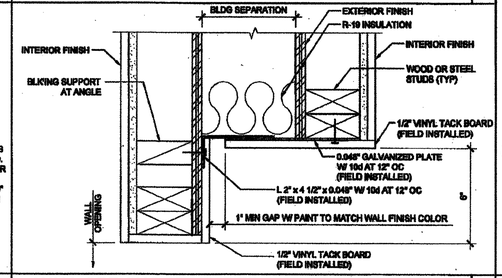

WALL OPENING AT HEADER AND JAMB SCALE : 3"=1'-0" 12

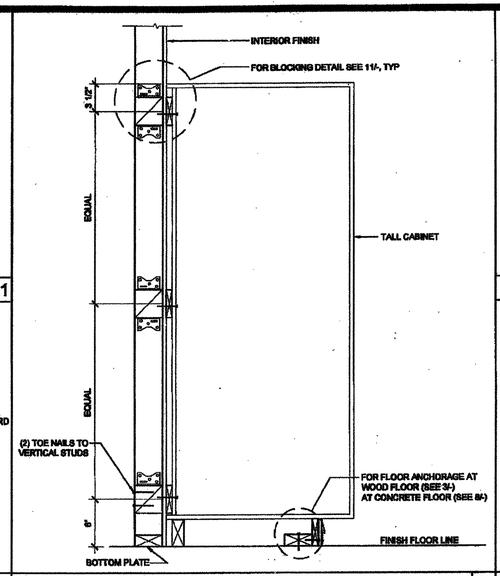

TALL CABINET WALL ANCHORAGE AT WOOD STUD SCALE : 1 1/2" = 1'-0" 7

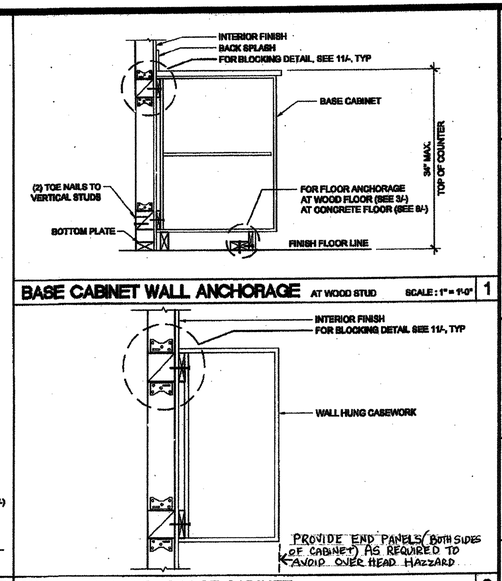

BASE CABINET WALL ANCHORAGE AT WOOD STUD SCALE : 1" = 1'-0" 1

WALL HUNG ANCHORAGE CABINET AT WOOD STUD SCALE : 1 1/2" = 1'-0" 2

PROJECTION SCREEN MOUNTING SCALE : NTS 18

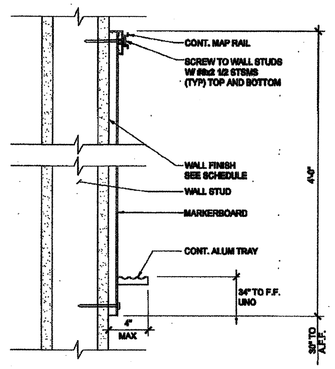

MARKER BOARD ATTACHMENT SCALE : 3" = 1'-0" 14

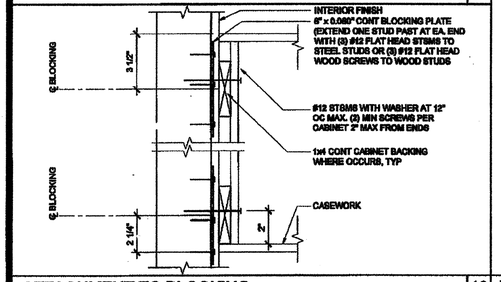

ATTACHMENT TO BLOCKING SCALE : 3" = 1'-0" 19

TEACHING WALL - ELEVATION / SECTION - OPTION SCALE : 3/8" = 1'-0" 15

ATTACHMENT TO BLOCKING - CONC. FLOOR SCALE : 3" = 1'-0" 8

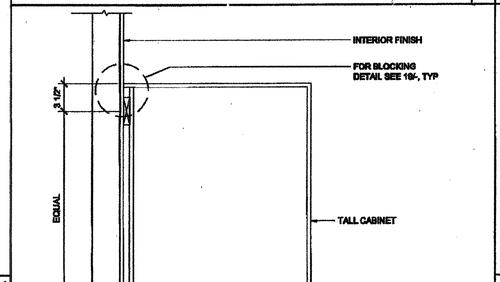

TALL CABINET WALL ANCHORAGE SCALE : 1 1/2" = 1'-0" 10

ATTACHMENT TO BLOCKING - WOOD FLOOR SCALE : 3" = 1'-0" 3

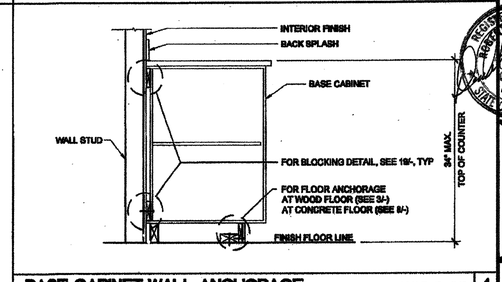

BASE CABINET WALL ANCHORAGE SCALE : 1" = 1'-0" 4

WALL HUNG ANCHORAGE CABINET SCALE : 1 1/2" = 1'-0" 5

THESE DRAWINGS AND ALL MATERIAL CONTAINED HEREIN ARE THE PROPERTY OF SILVERCREEK INDUSTRIES, INC (SCI Inc) AND SHALL NOT BE REPRODUCED, COPIED OR OTHERWISE DISPOSED OF DIRECTLY OR INDIRECTLY AND SHALL NOT BE USED IN WHOLE OR IN PART TO ASSIST IN THE MAKING OF OR FOR THE PURPOSE OF FURNISHING ANY INFORMATION FOR THE MAKING OF DRAWINGS, PRINTS, APPARATUS OR PARTS THEREOF WITHOUT THE FULL KNOWLEDGE AND WRITTEN CONSENT OF SCI Inc.
ALL PATENTABLE MATERIAL CONTAINED HEREIN AND ORIGINATING WITH SCI Inc SHALL BE THE PROPERTY OF SCI Inc

SILVER CREEK INDUSTRIES, INC.
"BUILDING FOR THE NEXT GENERATION"
SILVER CREEK
195 EAST MORGAN PERRIS, CALIFORNIA 92571
PHONE: 951-943-5399 FAX: 951-943-2211

PROJECT NAME:

CLASS LEASING
CLASSROOMS BLDG'S

SHEET TITLE:

ARCHITECTURAL
DETAILS
MISCELLANEOUS/OPTIONS

TAVARES ASSOCIATES

REVISED
FEB 26 2015
12/23/2011

IDENTIFICATION STAMP
DIV. OF THE STATE ARCHITECT
OFFICE OF REGULATION SERVICES
04 112892
AC PC SS
DATE NOV 20 2015

REGISTERED ARCHITECT
TAVARES, MICHAEL
No. C10322
8-26-16
STATE OF CALIFORNIA

PROJECT SPECIFIC STATE AGENCY APPROVAL

IDENTIFICATION STAMP
DIV. OF THE STATE ARCHITECT
OFFICE OF REGULATION SERVICES
04 111749
AC PC SS
DATE AUG 28 2015

REGISTERED ARCHITECT
TAVARES, MICHAEL
No. C10322
8-26-17
STATE OF CALIFORNIA

ORIGINAL PC STATE AGENCY APPROVAL

IDENTIFICATION STAMP
DIV. OF THE STATE ARCHITECT
OFFICE OF REGULATION SERVICES
PC 04-112072
AC PC SS
DATE DEC 29 2011

CHECK PC DOCUMENTS FOR COMPLIANCE WITH CBC 2010 CODE

REVISIONS

SILVER CREEK INDUSTRIES
24' x 40' PC

PROJECT NO:
DRAWN BY:
SCALE: AS NOTED
DATE: 12-23-11

P.C. SHEET NUMBER
A-5.80

STKP 140