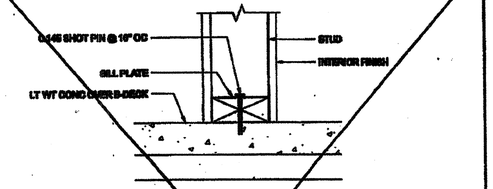

PARTITION CONNECTION AT CONC FLOOR SCALE: 3"=1'-0" 16

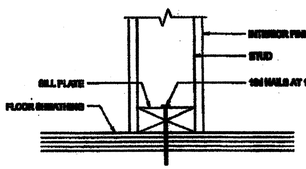

PARTITION CONNECTION AT WOOD FLOOR SCALE: 3"=1'-0" 11

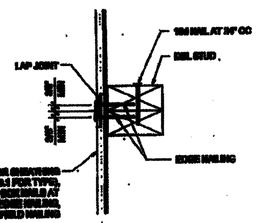

VERTICAL SHEATHING LAP JOINT SCALE: 3"=1'-0" 6

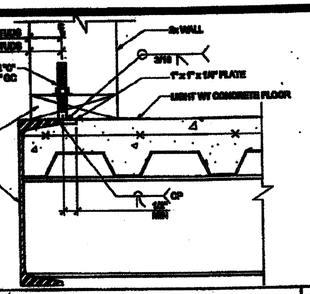

OPTIONAL BOLTED WALL TO FLOOR SCALE: NTS 1

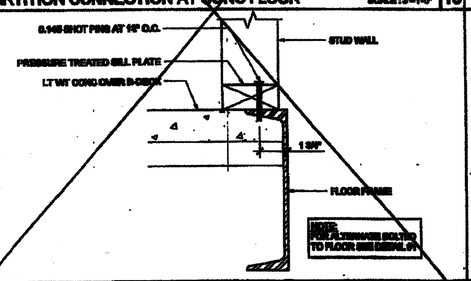

WALL SILL AT CONCRETE FLOOR SCALE: 3"=1'-0" 17

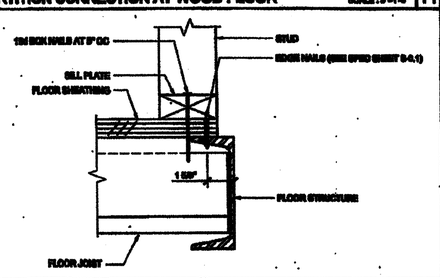

WALL SILL AT WOOD FLOOR SCALE: 3"=1'-0" 12

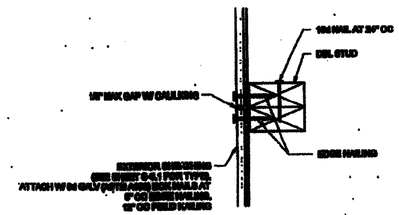

VERTICAL SHEATHING BUTT JOINT SCALE: 3"=1'-0" 7

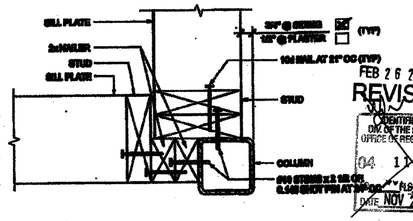

COLUMN AT ENDWALL (2x8) SCALE: 3"=1'-0" 2

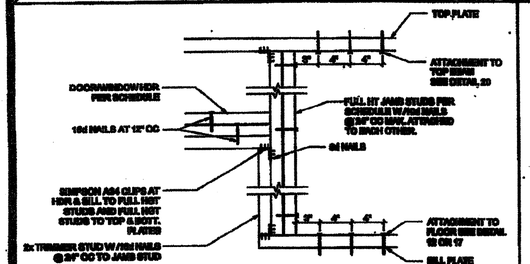

DOOR/WINDOW HEADER AND JAMB SCALE: 1 1/2"=1'-0" 18

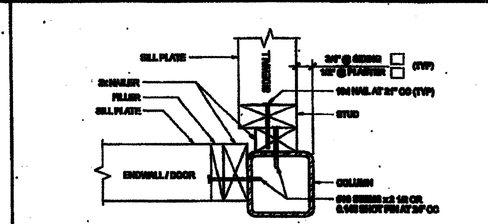

COLUMN AT ENDWALL SCALE: 3"=1'-0" 13

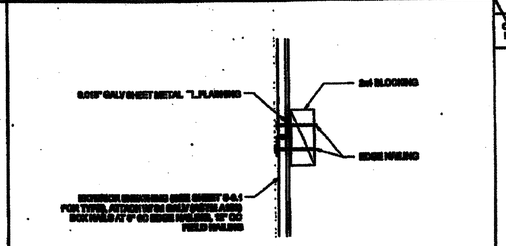

HORIZONTAL SHEATHING JOINT SCALE: 3"=1'-0" 8

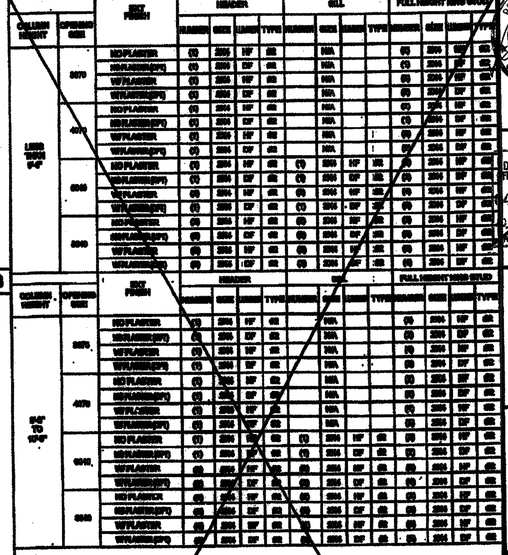

COLUMN HEIGHT	STUD SIZE	MAX. FINISH	HEADER					SILL					FULL HEIGHT WIND STUDS			
			THICKNESS	WIDTH	LUMBER	TYPE	THICKNESS	WIDTH	LUMBER	TYPE	THICKNESS	WIDTH	LUMBER	TYPE

SEE 20/S-5.11

WALL FRAMING SCHEDULE - 100 MPH 6

TOP PLATE AT ROOF BEAM SCALE: 3"=1'-0" 20

LET-IN BLOCK ATTACHMENT SCALE: 3"=1'-0" 14

DOOR	WINDOW	☑ STANDARD		☐ WELDED FRAME	
2070		24"	80"	26 1/8"	83 1/8"
2870		32"	80"	43 1/8"	83 1/8"
4070		60"	80"	63 1/8"	83 1/8"
6070		74"	80"	78 1/8"	83 1/8"
	4848	47 3/8"	47 3/8"	63 1/8"	63 1/8"
	5948	71 3/8"	47 3/8"	78 1/8"	63 1/8"
	5948	59 3/8"	47 3/8"	166 1/8"	63 1/8"
	5968	71 3/8"	59 3/8"	78 1/8"	83 1/8"
	5968	59 3/8"	59 3/8"	166 1/8"	83 1/8"

ROUGH OPENING SCHEDULE 15

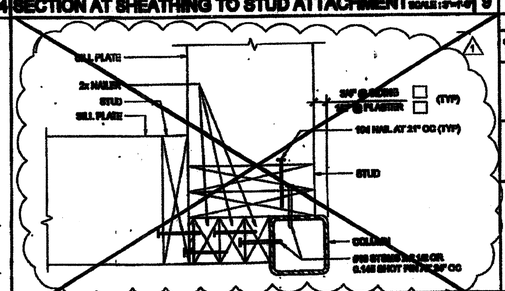

COLUMN AT ENDWALL (2x8) SCALE: 3"=1'-0" 10


OPENING STUDS SCHEDULE - 100 MPH 4

GENERAL NOTES AND ALL MATERIAL CONTAINED HEREIN ARE THE PROPERTY OF SILVER CREEK INDUSTRIES, INC. (SCI Inc) AND SHALL NOT BE USED, COPIED OR COPIED FROM WITHOUT THE WRITTEN PERMISSION OF SILVER CREEK INDUSTRIES, INC. (SCI Inc) AND SHALL NOT BE LOANED, GIVEN OR SOLD TO ANY PERSON, FIRM, ASSOCIATION OR CORPORATION WITHOUT THE WRITTEN PERMISSION OF SCI Inc. ALL RIGHTS RESERVED. ALL MATERIAL CONTAINED HEREIN AND COMMUNICATED WITH SCI Inc SHALL BE THE PROPERTY OF SCI Inc

SILVER CREEK INDUSTRIES, INC.

"BUILDING FOR YOUR NEXT GENERATION"

SILVER CREEK

195 EAST MORGAN FRESNO, CALIFORNIA 93277
PHONE: 559-439-8000 FAX: 559-439-8011

PROJECT NAME:

CLASS LEASING
CLASSROOM BLDG'S

SHEET TITLE:

WALL FRAMING DETAILS
WOOD STUDS

IDENTIFICATION STAMP DIV. OF THE STATE ARCHITECT OFFICE OF REGULATION SERVICES 04 113892 AC FLS SS DATE NOV 27 2013

REVISED FEB 26 2015

TAVARES ENGINEERING

REGISTERED ARCHITECT ROBERT A. TAVARES C10322 6-30-15 STATE OF CALIFORNIA

SEP 14 2012

IDENTIFICATION STAMP DIV. OF THE STATE ARCHITECT OFFICE OF REGULATION SERVICES 04 113892 AC FLS SS DATE AUG 28 2014

PROJECT SPECIFIC STATE AGENCY APPROVAL

IDENTIFICATION STAMP DIV. OF THE STATE ARCHITECT OFFICE OF REGULATION SERVICES 04 113536 AC FLS SS DATE APR 04 2014

ORIGINAL PC STATE AGENCY APPROVAL

PRE-CHECK (PC) DOCUMENT CCR, TITLE 24 A DOCUMENT PREPARED FOR CONSTRUCTION PERMITTING

IDENTIFICATION STAMP DIV. OF THE STATE ARCHITECT OFFICE OF REGULATION SERVICES PC 04-112072 AC FLS SS DATE JAN 09 2013

REVISED

REVISIONS

1 PC REVISION 07/24/2012
2
3
4
5
6
7

SILVER CREEK INDUSTRIES
24'x 48'PC

PROJECT NO:
DRAWN BY:
SCALE: AS NOTED
DATE: 10-28-11

P.C. SHEET NUMBER
S-5.10

STKP 140