ALTERNATE No. 5 ADDITIVE:
ADD HVAC REGISTERS AS SHOWN.
FOR BASE BID, SEE MECH. DWGS.

ALTERNATE No. 6 ADDITIVE:
ADD SUSPENDED ACOUSTICAL CEILING INCLUDING ALL STRUCTURAL REQUIREMENT FOR SUSPENSION, AND LIGHT FIXTURES AS SHOWN. BASE BID INCLUDES PAINTING OF (E) CEILING AND REPLACEMENT OF EXISTING LIGHT FIXTURES AS SHOWN ON ELECTRICAL DWGS. ROOM 602 ONLY

BUILDING 400

THIS T-BAR CEILING LAYOUT TO BE TYPICAL AT ROOMS 403, 404, 405, 406 & 407

T-BAR CEILING LAYOUT OF THIS ROOM SIMILAR TO ROOM 502

(E) 1HT. CEILING @ 9'-2" TO REMAIN IN ROOMS 504, 505, & 506

(E) POST FOR FIN WALL BELOW

BUILDING 600
REFLECTED CEILING PLANS

NOTE: FOR REFLECTED CEILING PLAN LEGEND SEE SHEET A-11

BUILDING 500

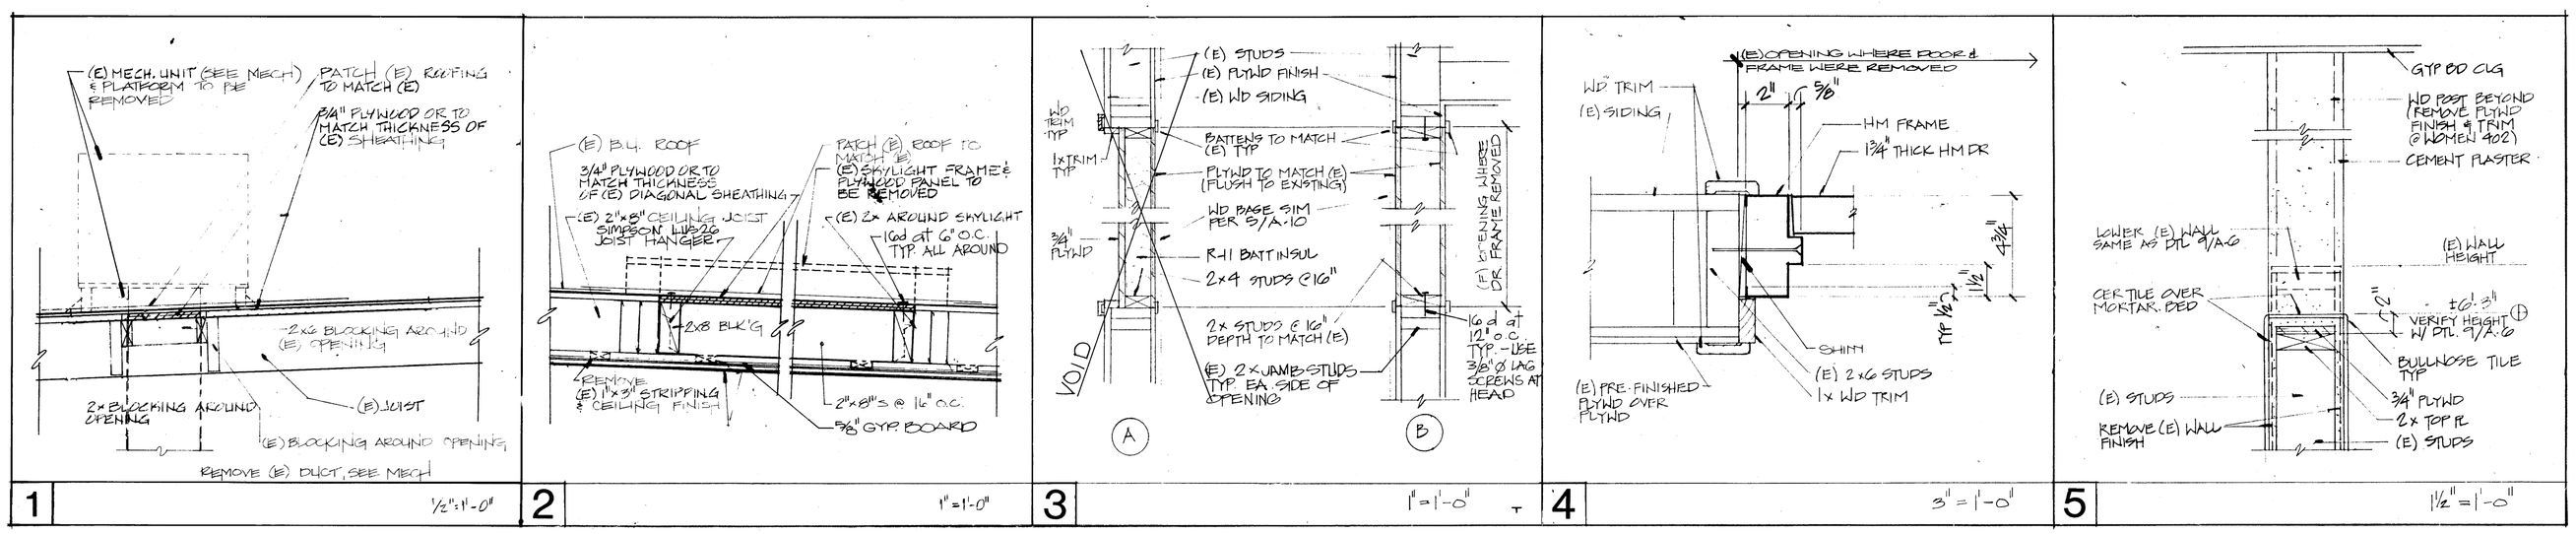

1201 REMOVE (E) SKYLIGHT & INFILL OPENING, SEE DETAIL 2 SHEET A-12
1202 5/8" GYPSUM BOARD CEILING
1203 T & T CEILING
1204 BAROMETRIC RELIEF GRILLE, SEE MECHANICAL

approved .

C. 3132
C. 3269
C. 6564
C. 8021
C. 8702

© copyrighted 1989

bfgc inc.
architects planners
31 south real road box 9698
bakersfield california 93309
805 832 8122

APPLICATION NO. 77/50602

BLDGS. 400/500 REFLECTED CEIL. PLANS 1/8"=1'-0"

MT. VERNON MODERNIZATION
BAKERSFIELD CITY SCHOOL DISTRICT
2161 POTOMAC AVENUE
BAKERSFIELD, CALIFORNIA 93307

job 87-126

date 1 FEB. 1989

sheet A-12

bfgc architects - planners