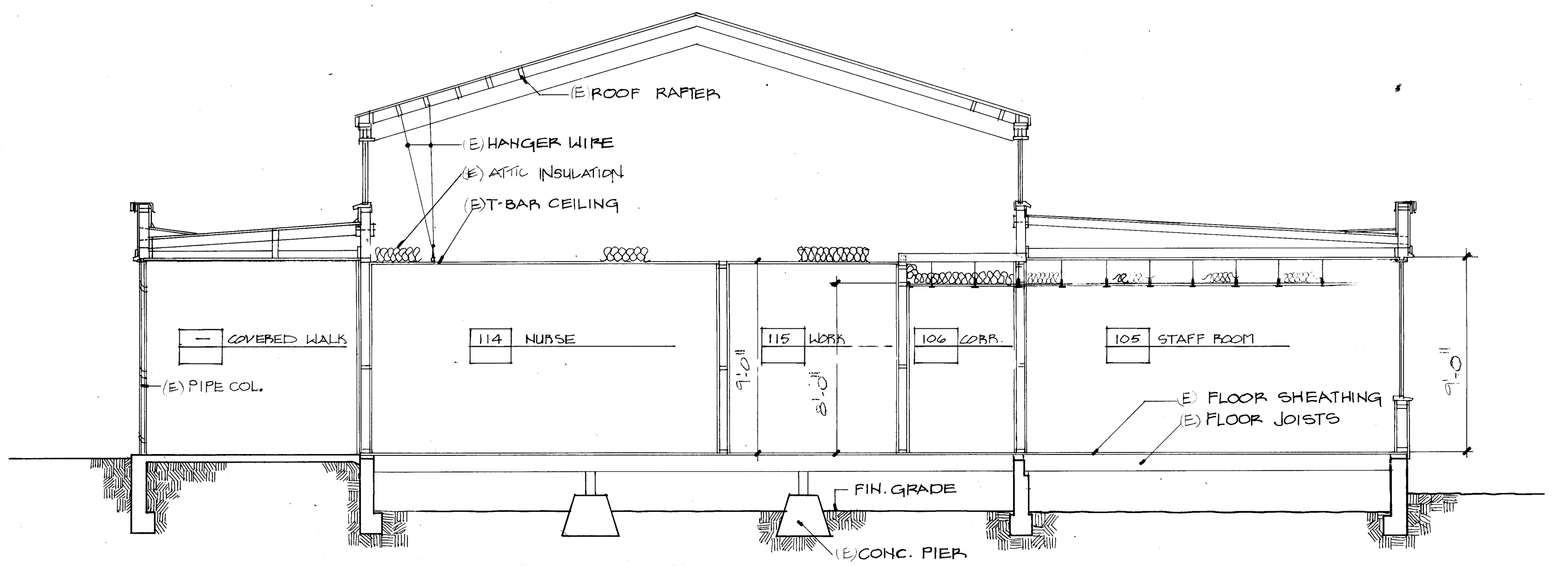

BLDG 100
(A) SECTION

NO NEW WORK SHOWN ON THIS SECTION

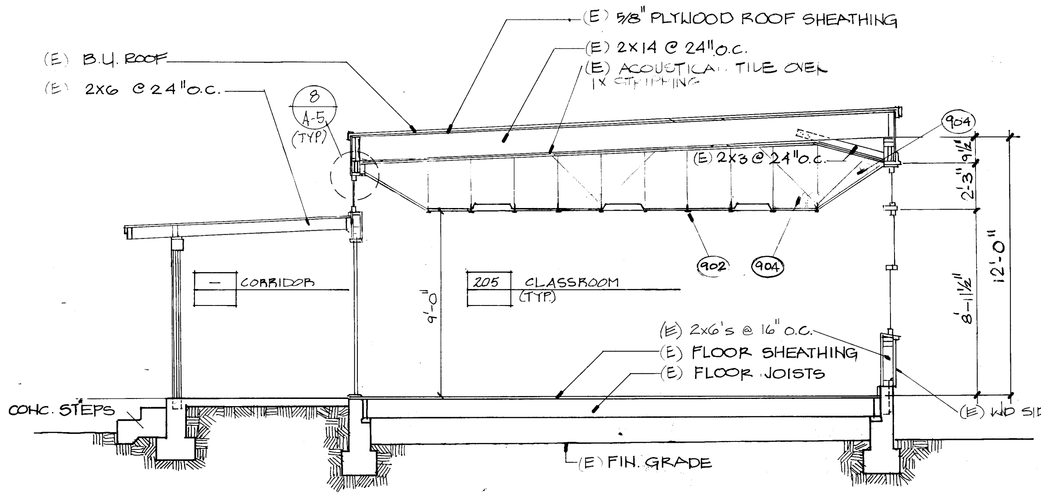

BLDG 200 & 300
(B) SECTION

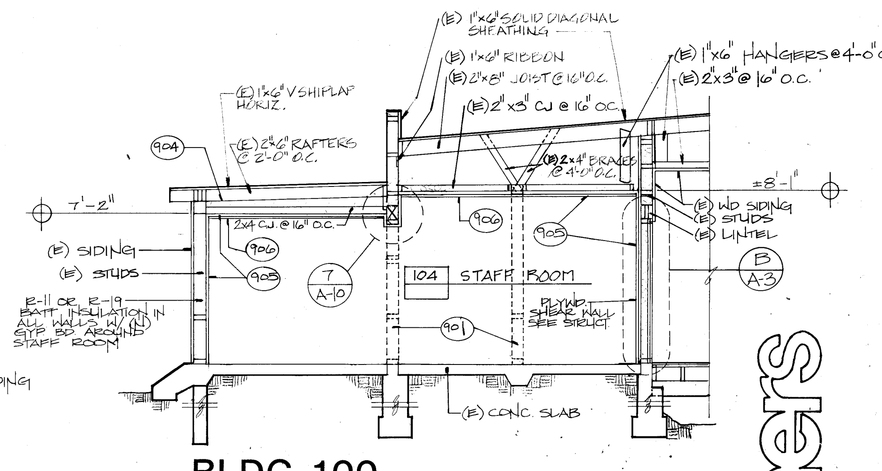

BLDG 100
J SECTION

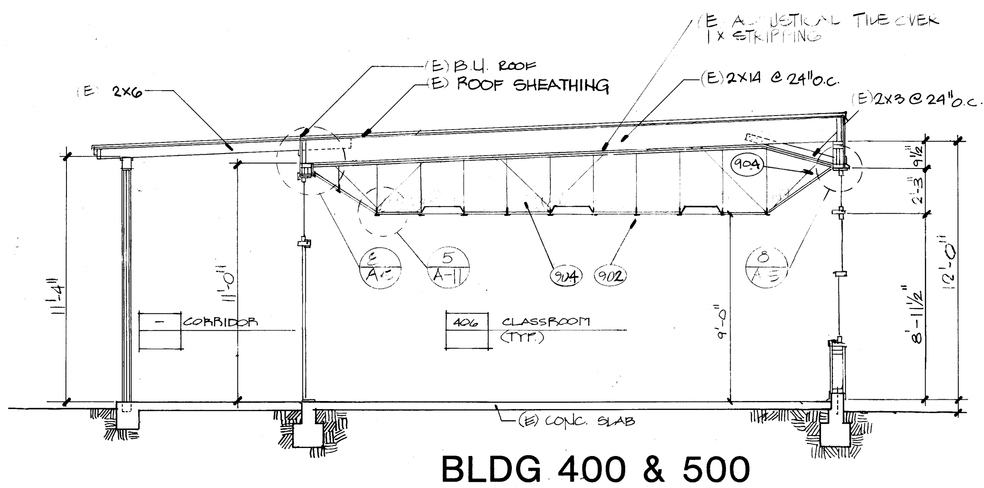

BLDG 400 & 500
(C) SECTION

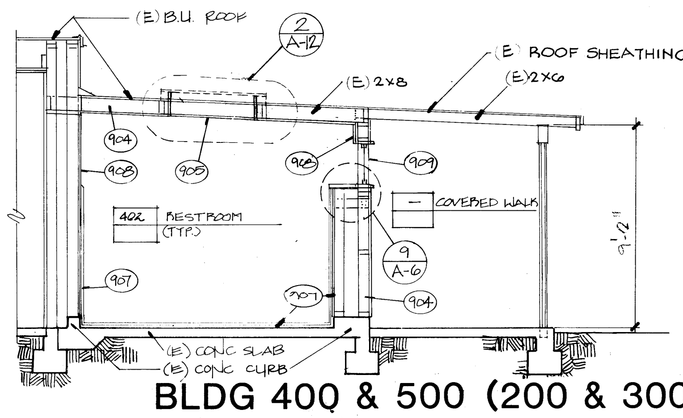

BLDG 400 & 500 (200 & 300 SIM)
(D) SECTION

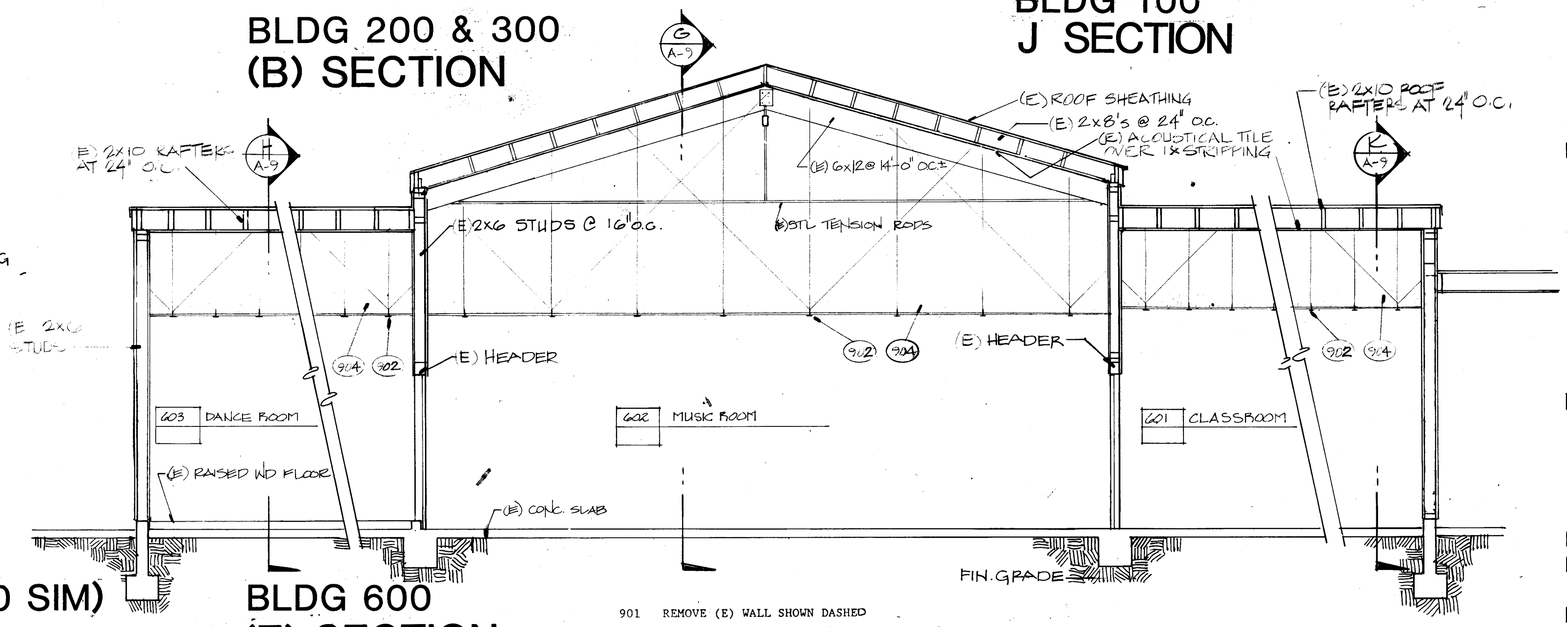

BLDG 600
(E) SECTION

901 REMOVE (E) WALL SHOWN DASHED
902 T & T CEILING
903
904 6"-10" BATT INSULATION
905 5/8" GYP. BOARD
906 ACOUSTIC TILE
907 CERAMIC TILE OVER MORTAR BED
908 CEMENT PLASTER
909 REMOVE AND REPLACE (E) GLASS IN (E) WINDOWS WITH PATTERNED GLASS
910 REMOVE (E) PLYWOOD AT (E) CLEARSTORY WINDOWS AND REPLACE WITH GLASS

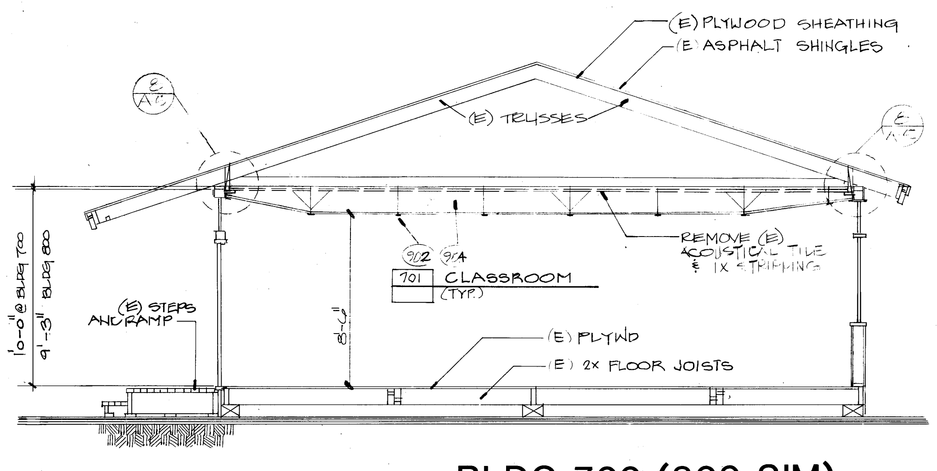

BLDG 700 (800 SIM)
(F) SECTION

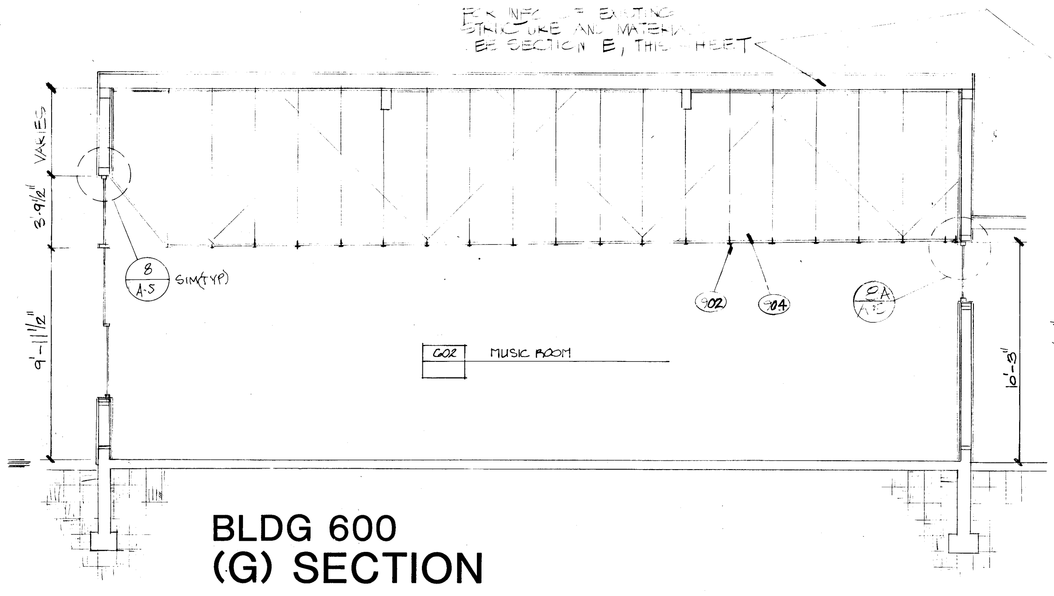

BLDG 600
(G) SECTION

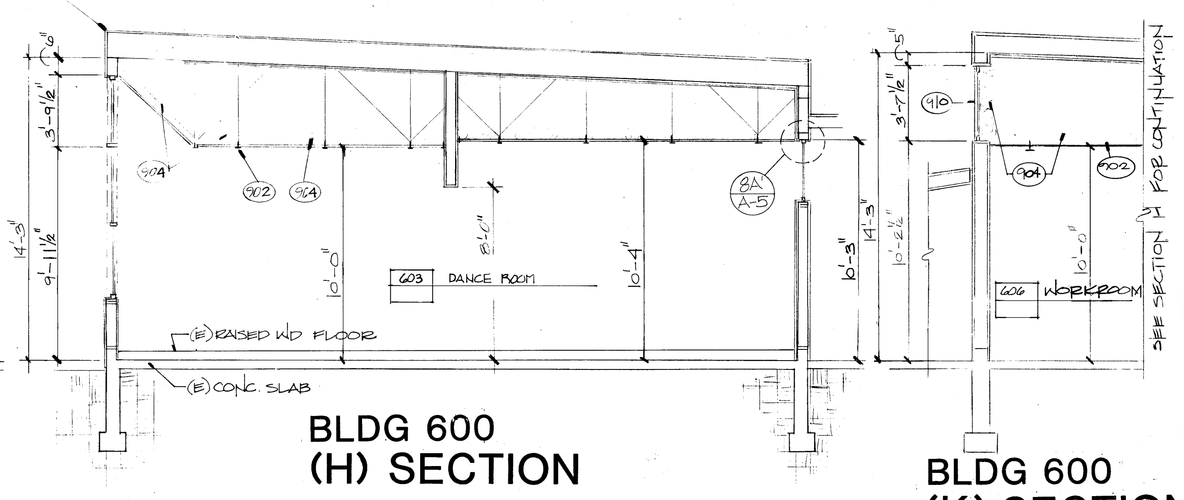

BLDG 600
(H) SECTION

BLDG 600
(K) SECTION

approved

C. 3132
C. 3269
~~C. 6564~~
C. 8021
C. 8702

D.R. CARTHA

© copyrighted 1989

bfgc inc.
architects planners
31 south real road box 9698
bakersfield california 93309
805 832 8122

APPLICATION NO. 77/50602

SECTION A TO J 1/4"=1'-0"

MT. VERNON MODERNIZATION
BAKERSFIELD CITY SCHOOL DISTRICT
2161 POTOMAC AVENUE
BAKERSFIELD, CALIFORNIA 93307

job 87-126

date 1 FEB. 89

sheet A9

bfgc architects - planners