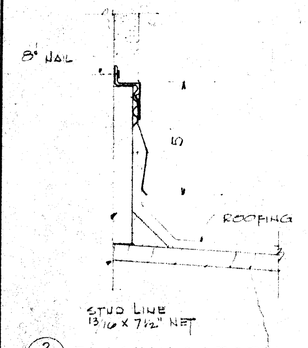

2/A6 FLASHING DETAIL
SCALE 3" = 1'-0"

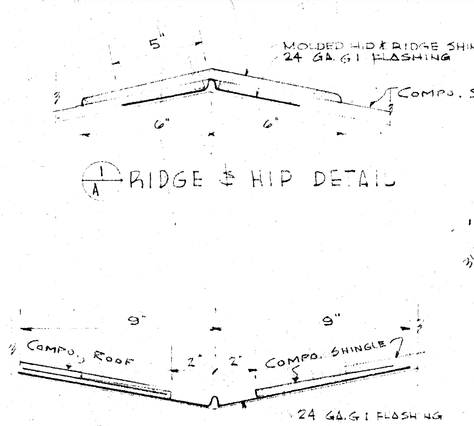

1/A6 RIDGE & HIP DETAIL

8/A6 VALLEY DETAIL
SCALE 3" = 1'-0"

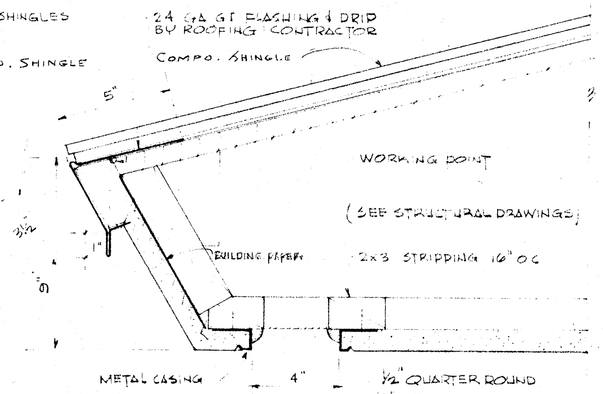

4/A6 TYPICAL EAVE DETAIL
SCALE 3" = 1'-0"

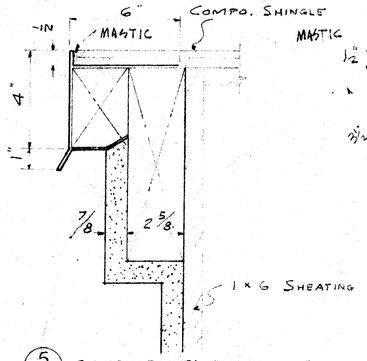

5/A6 RAKE DETAIL OF EXISTING DETAIL
SCALE 3" = 1'-0"

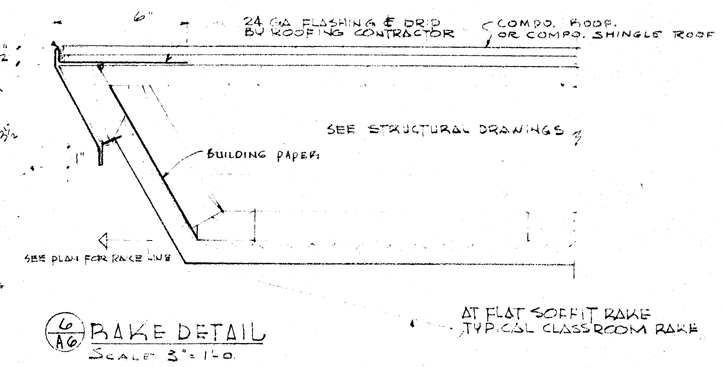

6/A6 RAKE DETAIL
SCALE 3" = 1'-0"

AT FLAT SOFFIT RAKE
TYP. CAL CLASSROOM RAKE

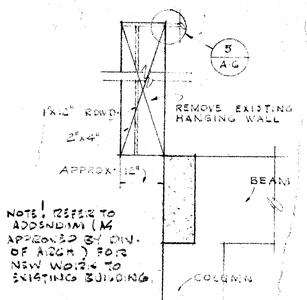

10/A6 HANGING WALL DETAIL
SCALE 3" = 1'-0"

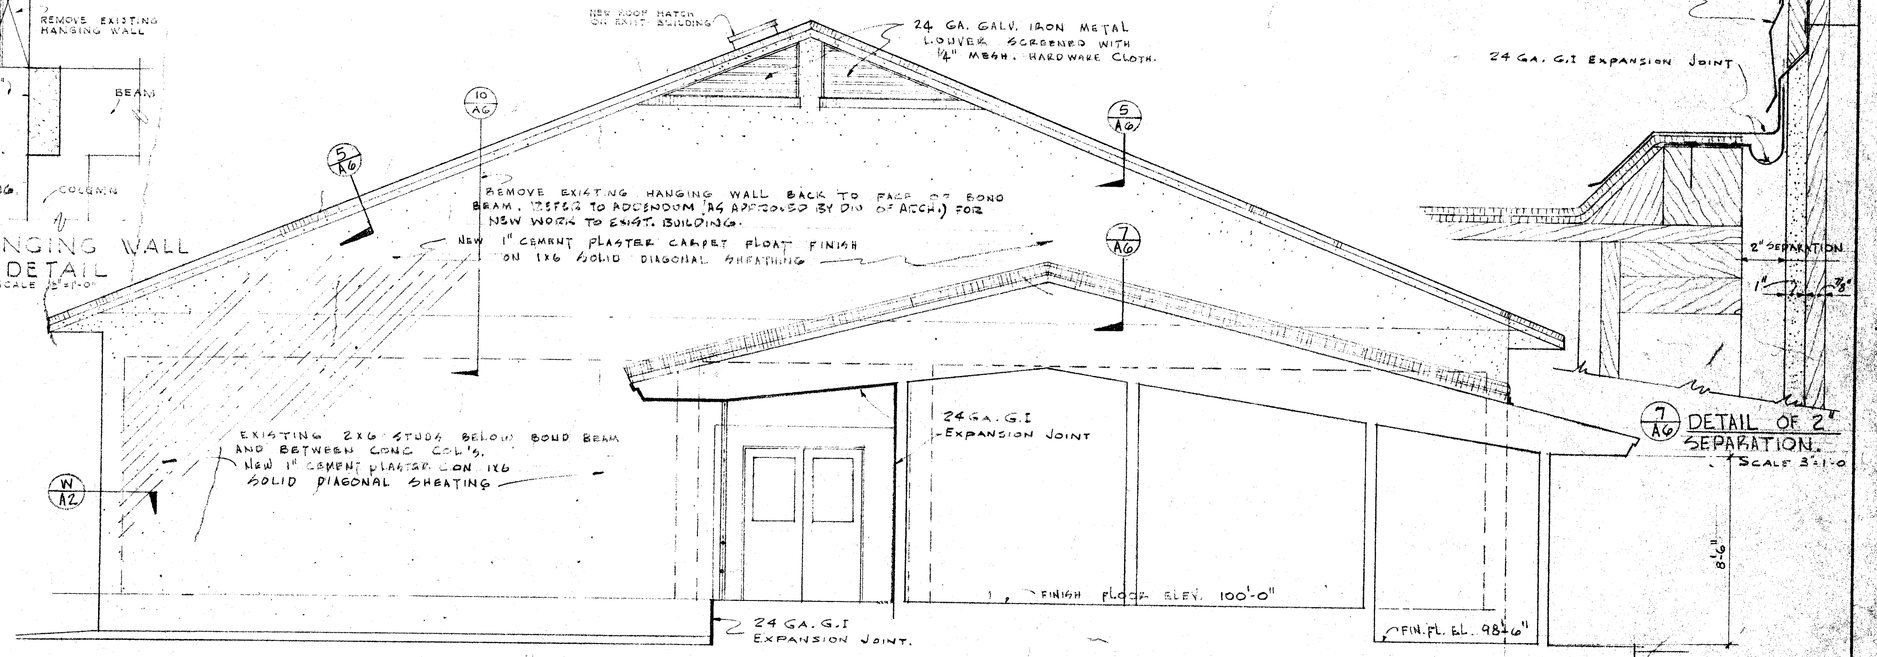

SECTION THRU. B/A6 AND ELEVATION OF EXISTING BUILDING BEYOND
SCALE ¼" = 1'-0"

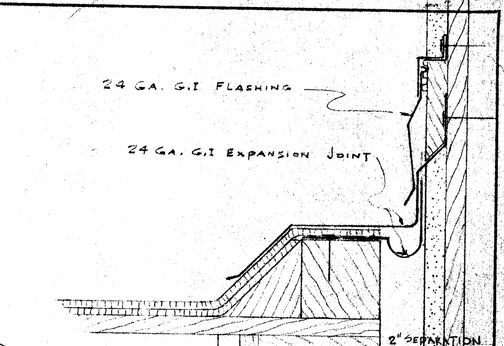

7/A6 DETAIL OF 2" SEPARATION.
SCALE 3" = 1'-0"

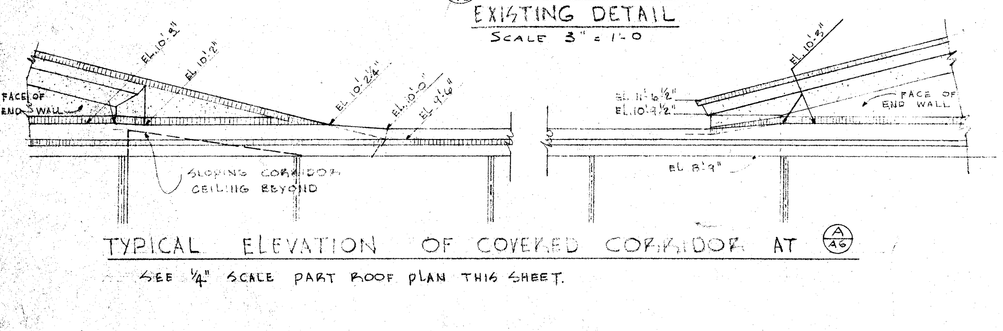

TYPICAL ELEVATION OF COVERED CORRIDOR AT A/A6
SEE ¼" SCALE PART ROOF PLAN THIS SHEET.

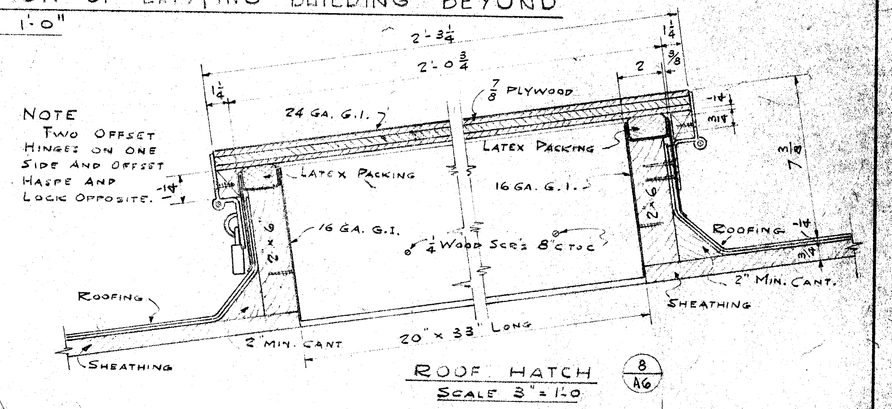

ROOF HATCH
SCALE 3" = 1'-0"
8/A6

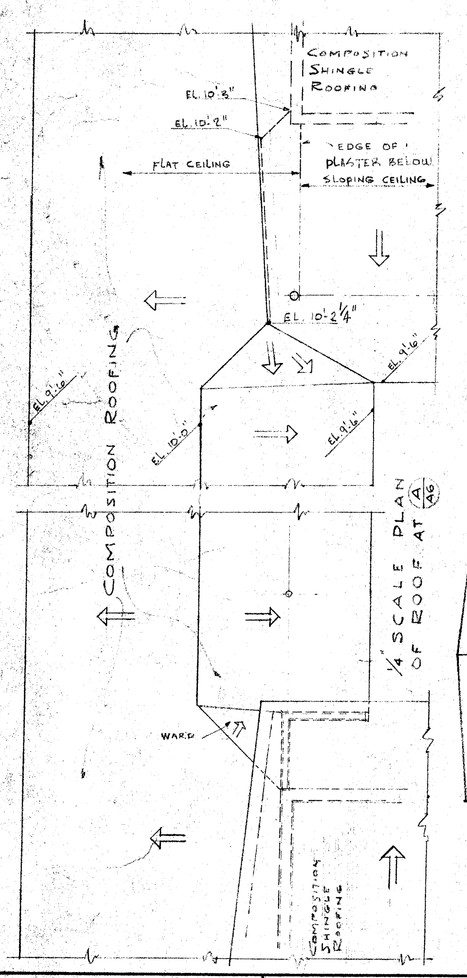

¼" SCALE PLAN OF ROOF AT A/A6

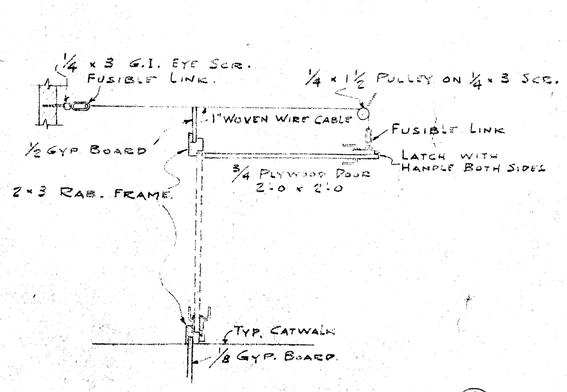

SELF CLOSING DRAFT STOP DOOR 9/A6
SCALE 1" = 1'-0"

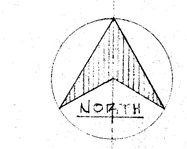

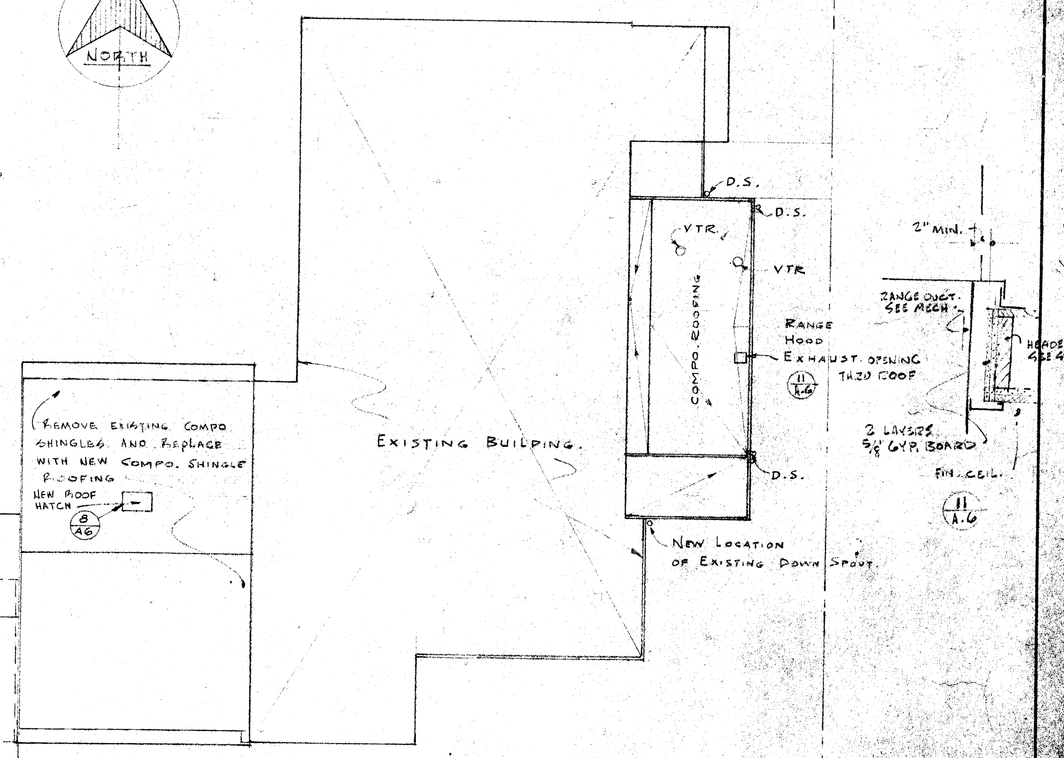

ROOF PLAN
SCALE 1/16" = 1'-0"

CHECK AND VERIFY ALL DIMENSIONS AND CONDITIONS AT JOB SITE BEFORE PROCEEDING WITH THE WORK. REPORT ANY DISCREPANCIES TO THE ARCHITECT.

ROOF PLAN AND DETAILS SCALE AS NOTED

OFFICE OF SUPERINTENDENT OF SCHOOLS
APPROVED
DATE 11-16-53

STATE OF CALIFORNIA
DEPARTMENT OF PUBLIC WORKS
DIVISION OF ARCHITECTURE

STATE OF CALIFORNIA—DEPARTMENT OF PUBLIC WORKS DIVISION OF ARCHITECTURE
APPLICATION NO. 11362
APPROVED NOV 12 1953
J. A. McCutchen
SUPERVISING STRUCTURAL ENGINEER

BAKERSFIELD CITY SCHOOLS
1600 H ST. BAKERSFIELD CALIFORNIA
BOARD OF EDUCATION

APPROVED DATE Nov 12 1953

ROOSEVELT ELEM. SCHOOL ADDITION
BAKERSFIELD CITY SCHOOL DISTRICT
2324 VERDE STREET
BAKERSFIELD CALIFORNIA

ERNEST L. McCOY A.I.A. ARCHITECT
2811 H STREET
BAKERSFIELD
PHONE 4-9851
CALIFORNIA

C-335
JOB NO. 52-22

DATE 11-10-53
DRAWN
CHECKED

SHEET No. 6 OF 13 SHTS