

HILLMAN & NEWELL
 ARCHITECTS
 1133 L STREET, N.W.
 WASHINGTON, D.C. 20004





CHECK AND VERIFY ALL DIMENSIONS AND CONDITIONS AT JOB SITE BEFORE PROCEEDING WITH THE WORK. REPORT ANY DISCREPANCIES TO THE ARCHITECT.





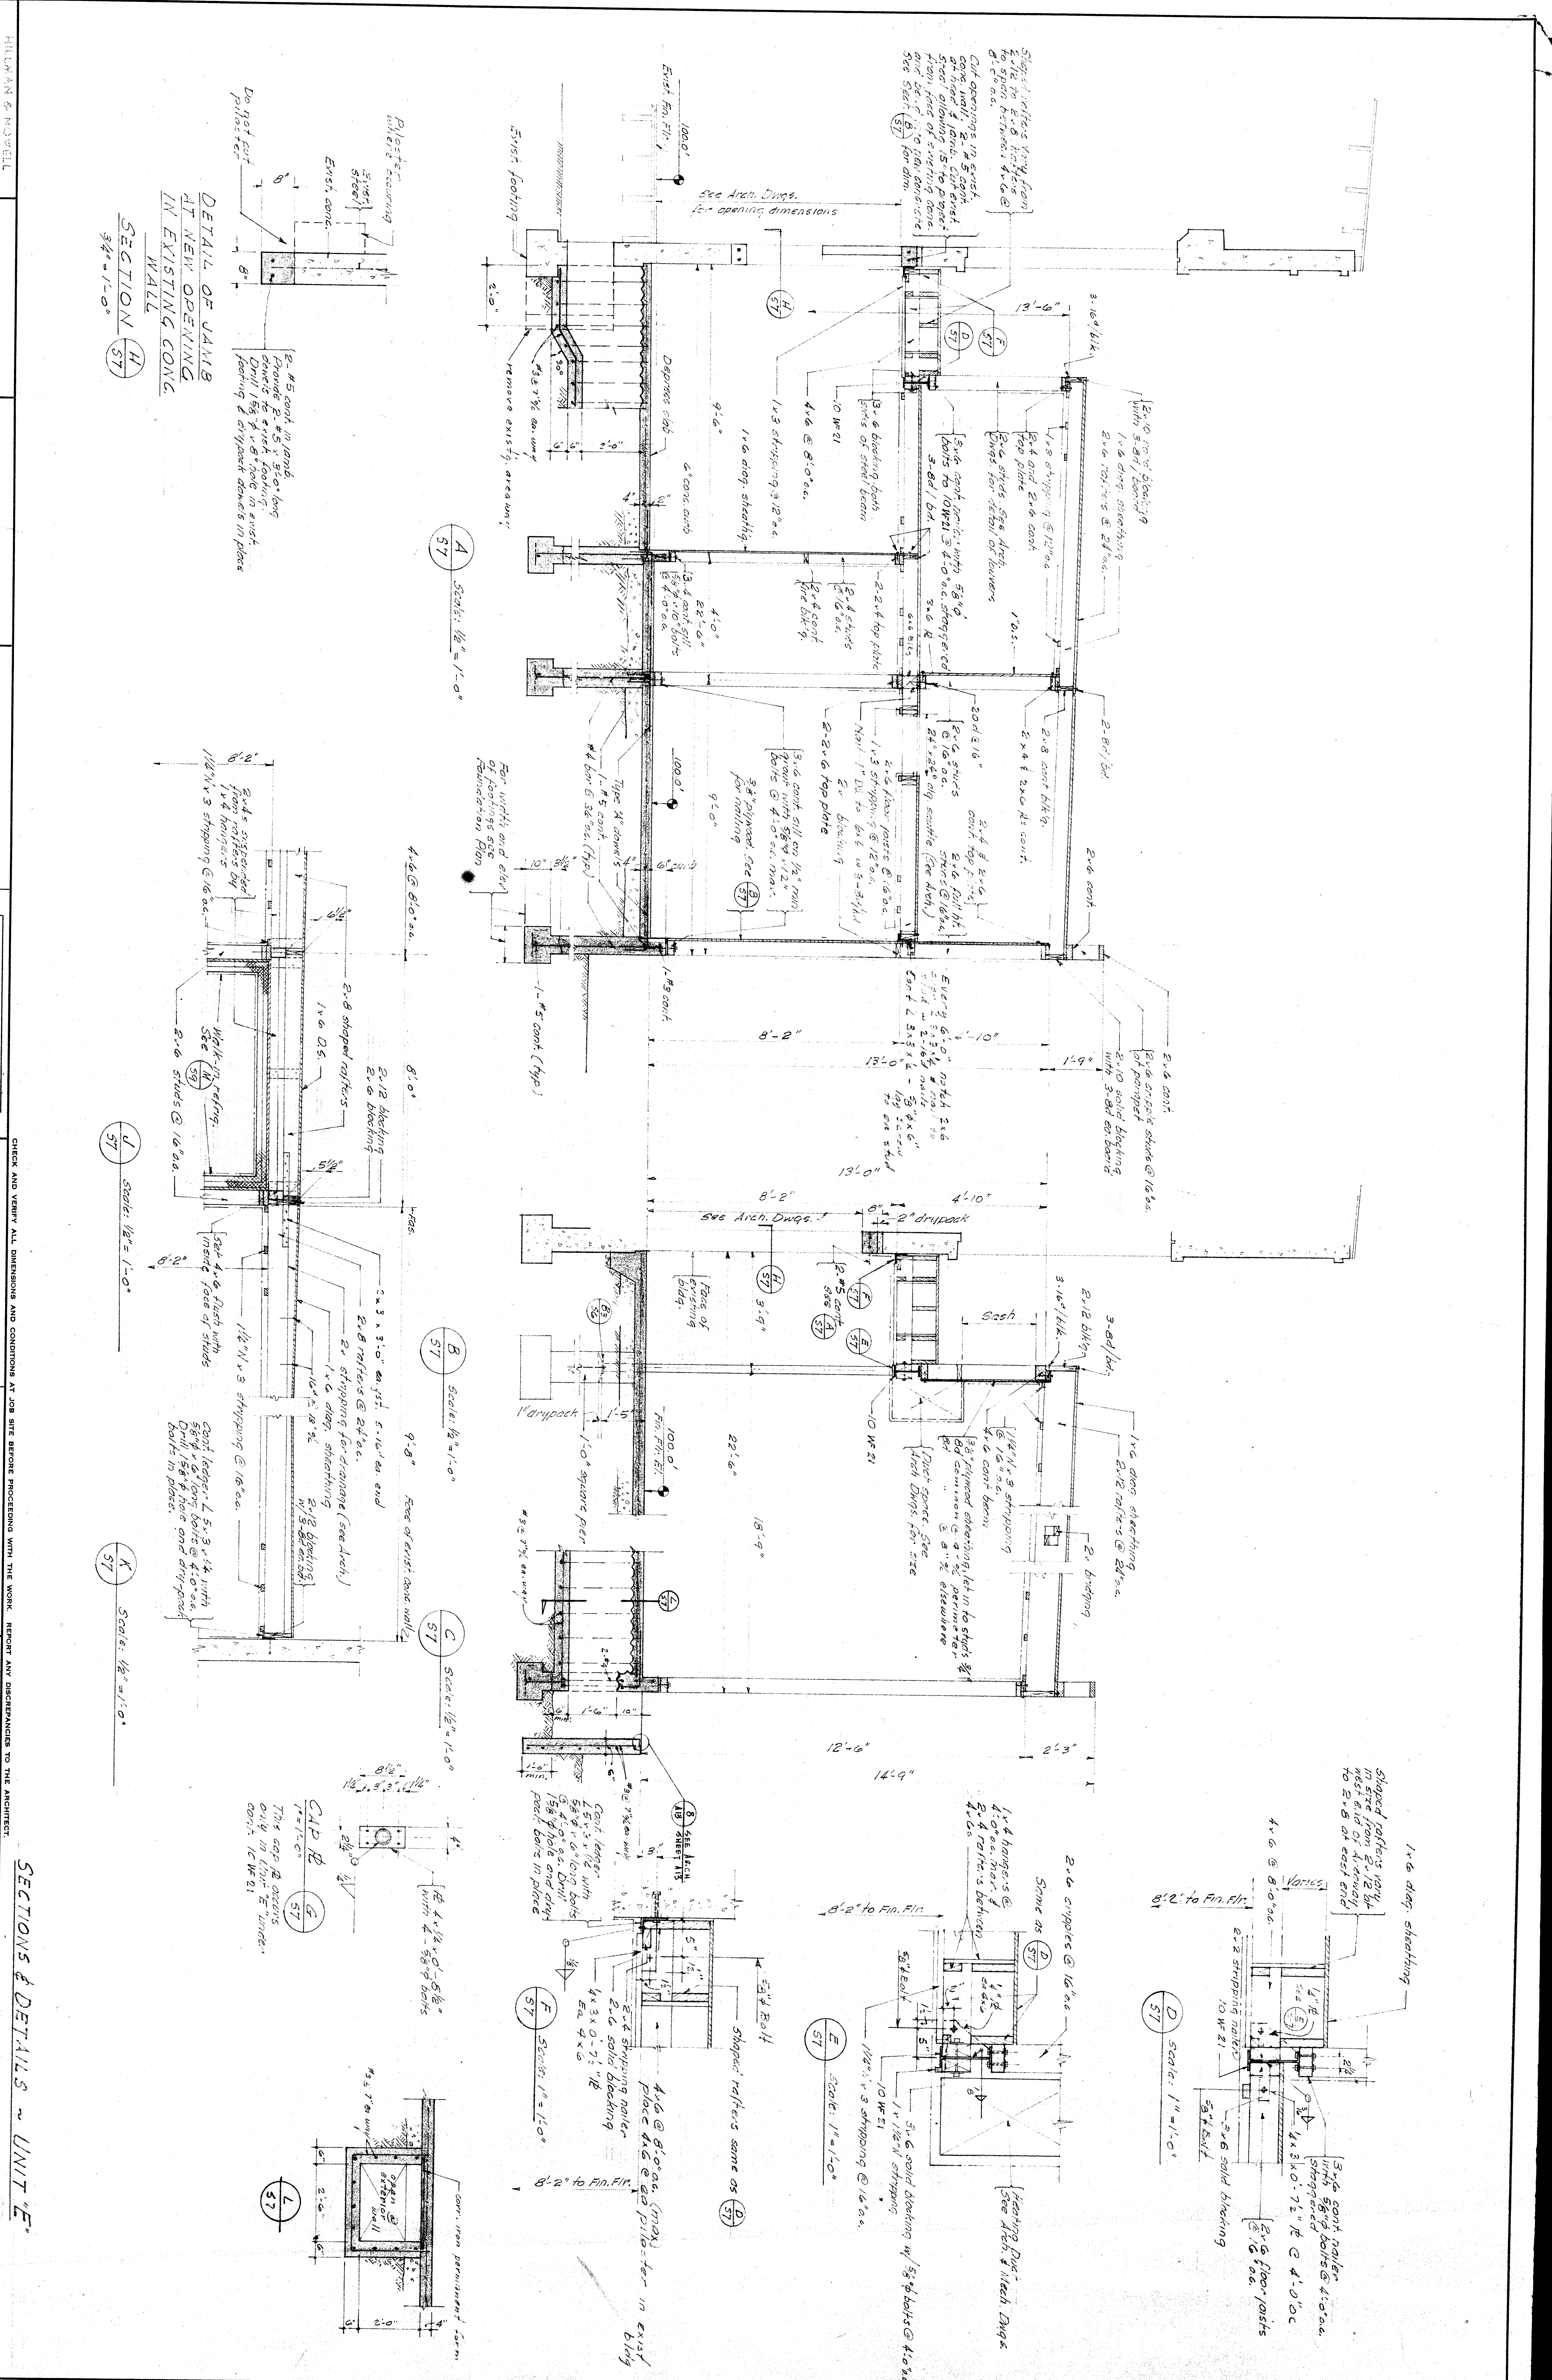

SECTIONS & DETAILS ~ UNIT #E

DETAIL OF JAMB
 AT NEW OPENING
 IN EXISTING CONC.
 WALL
 SECTION H-H
 3/4" = 1'-0"












