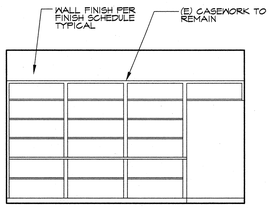

1 NORTH

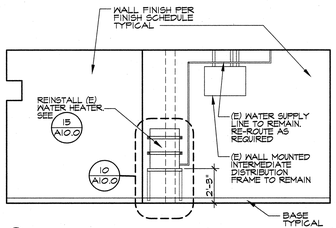

2 EAST

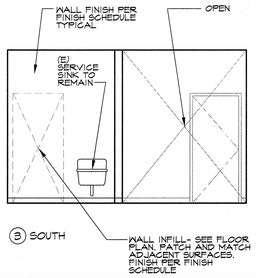

3 SOUTH

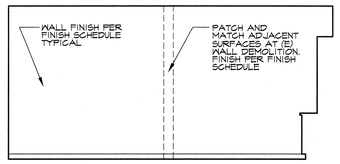

4 WEST

D108 CUSTODIAN

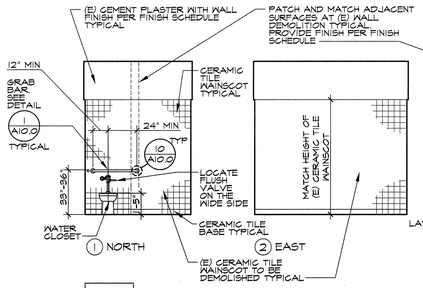

1 NORTH 2 EAST

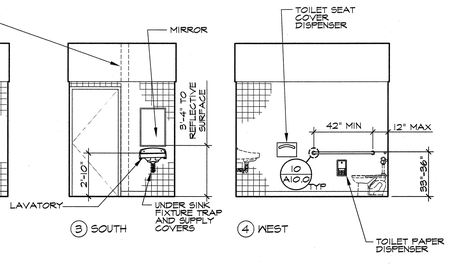

3 SOUTH 4 WEST

D109 MEN

FOR ACCESSORY MOUNTING HEIGHTS AND CLEARANCES, SEE DETAIL 1 A10.0

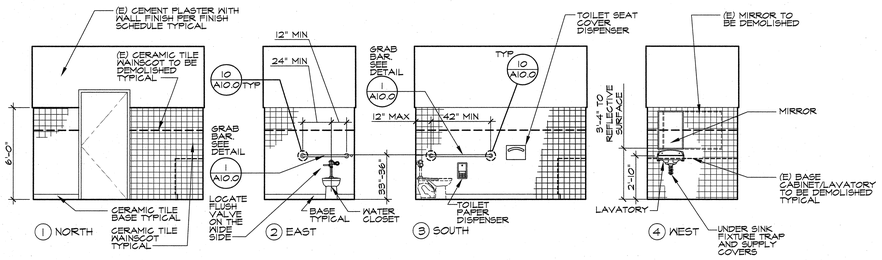

1 NORTH 2 EAST 3 SOUTH 4 WEST

C104 WOMEN

FOR ACCESSORY MOUNTING HEIGHTS AND CLEARANCES, SEE DETAIL

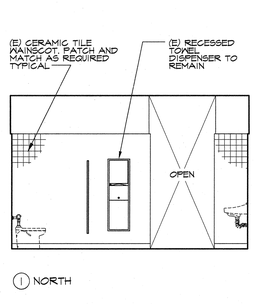

1 NORTH

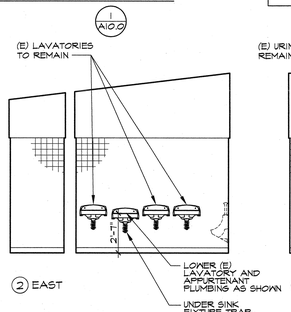

2 EAST

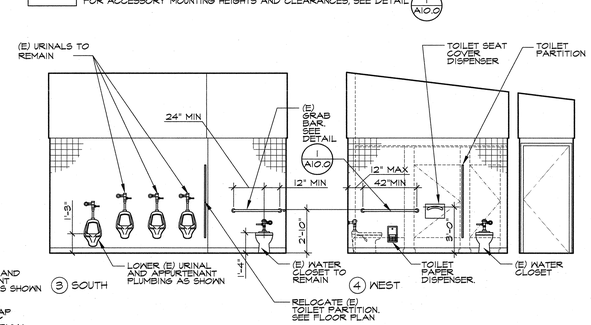

3 SOUTH 4 WEST

C108 BOYS NOTE : REPLACE ALL CERAMIC TILE WITH CRACKS OR HOLES TYPICAL

FOR ACCESSORY MOUNTING HEIGHTS AND CLEARANCES, SEE DETAIL 1 A10.0

1 NORTH

2 EAST

3 SOUTH

4 WEST

C109 GIRLS NOTE : REPLACE ALL CERAMIC TILE WITH CRACKS OR HOLES TYPICAL

FOR ACCESSORY MOUNTING HEIGHTS AND CLEARANCES, SEE DETAIL 1 A10.0

A INTERIOR ELEVATIONS

SCALE : 1/4"=1'-0"

MARK	DATE	REVISIONS
1		
2		
3		

CHECK AND VERIFY ALL DIMENSIONS BEFORE PROCEEDING WITH THE WORK. REPORT DISCREPANCIES TO THE ARCHITECT. ALL CONSTRUCTION SHALL CONFORM TO THE C.B.C.

ROOSEVELT ELEMENTARY SCHOOL
SITE IMPROVEMENTS FOR MODULAR CLASSROOM
2324 VERDE STREET,BAKERSFIELD, CALIFORNIA
FOR
BAKERSFIELD CITY SCHOOL DISTRICT
BAKERSFIELD, KERN COUNTY, CALIFORNIA, 93304

IDENTIFICATION STAMP
DIV. OF THE STATE ARCHITECT
OFFICE OF REGULATION SERVICES
APPL 03-110979
FILE 15-6
AC W FLS MM SS
DATE 4-13-16

PTN : 63321-204

ARCHITECT SCI INC
1601 NEW STINE ROAD, SUITE 280
BAKERSFIELD, CA 93309
PH: (661) 397-4377
FAX: (661) 397-4378
WWW.SCARCHITECT.COM

LICENSED ARCHITECT STEPHEN J. CORBY No. C-16788 REN. 08/31/2017 STATE OF CALIFORNIA

STEPHEN J. CORBY, NCARB, AIA, LEED AP BD+C

INTERIOR ELEVATIONS

JOB NO.	
1216	
DRAWN :	
CHECKED :	
DATE :	4/13/2016

9.0 OF SHEETS