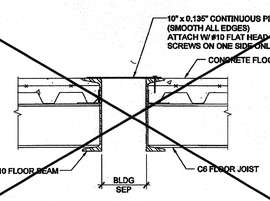

REF: A1.03

FLOOR AT SEPARATION (CONCRETE FLR) SCALE : 1 1/2"=1'-0" | 16

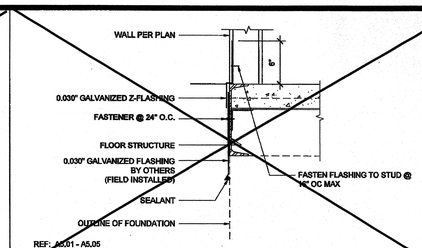

REF: A5.01 - A5.05

SKIRT FLASHING (CONCRETE FLOOR) SCALE : 1 1/2"=1'-0" | 11

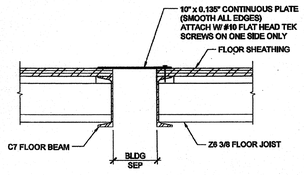

REF: A1.03

FLOOR AT SEPARATION (WOOD FLOOR) SCALE : 1 1/2"=1'-0" | 6

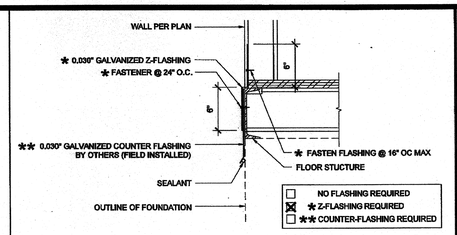

REF: A5.01 - A5.05

SKIRT FLASHING (WOOD FLOOR) SCALE : 1 1/2"=1'-0" | 1

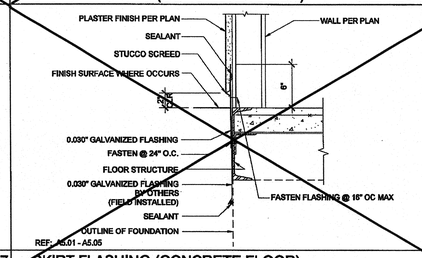

REF: A5.01 - A5.05

SKIRT FLASHING (CONCRETE FLOOR) SCALE : 1 1/2"=1'-0" | 12

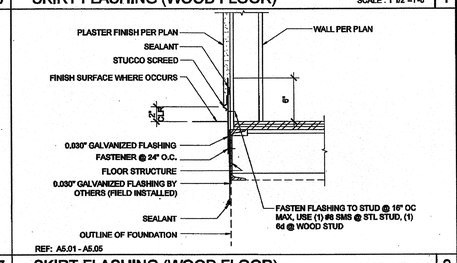

REF: A5.01 - A5.05

SKIRT FLASHING (WOOD FLOOR) SCALE : 1 1/2"=1'-0" | 2

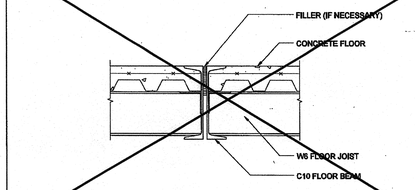

REF: A1.01 - A1.03

FLOOR AT MODLINE (CONCRETE FLOOR) SCALE : 1 1/2"=1'-0" | 13

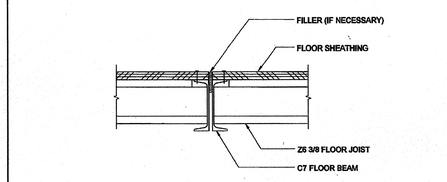

REF: A1.01 - A1.03

FLOOR AT MODLINE (WOOD FLOOR) SCALE : 1 1/2"=1'-0" | 3

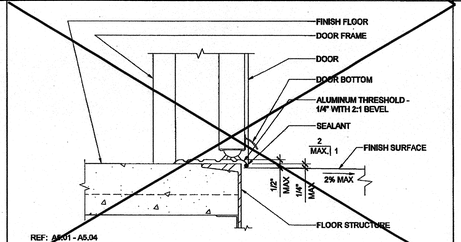

REF: A5.01 - A5.04

THRESHOLD SCALE : 3"=1'-0" | 14

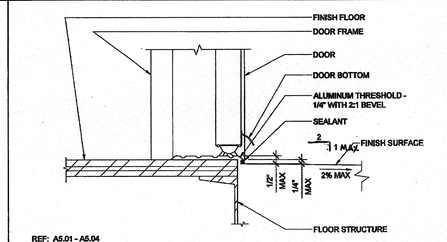

REF: A5.01 - A5.04

THRESHOLD SCALE : 3"=1'-0" | 4

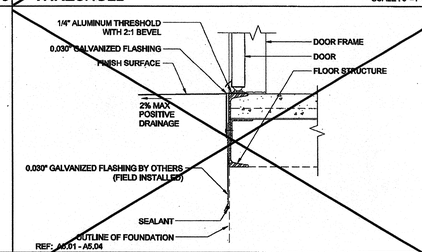

REF: A5.01 - A5.04

TYPICAL SILL AT FLOOR (CONCRETE FLOOR) SCALE : 1 1/2"=1'-0" | 15

IDENTIFICATION STAMP
DIV. OF THE STATE ARCHITECT
APP03 116979
AC FLS SS
Date 4/25/16

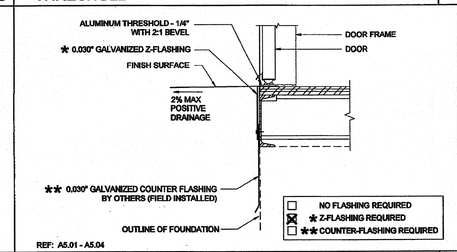

REF: A5.01 - A5.04

TYPICAL SILL AT FLOOR (WOOD FLOOR) SCALE : 1 1/2"=1'-0" | 5

THESE DRAWINGS AND ALL MATERIAL CONTAINED HEREIN ARE THE PROPERTY OF SILVERCREEK INDUSTRIES, INC (SCI Inc) AND SHALL NOT BE REPRODUCED, COPIED OR OTHERWISE DISPOSED OF DIRECTLY OR INDIRECTLY AND SHALL NOT BE USED IN WHOLE OR IN PART TO ASSIST IN THE MAKING OF OR FOR THE PURPOSE OF FURNISHING ANY INFORMATION FOR THE MAKING OF DRAWINGS, PRINTS, APPARATUS OR PARTS THEREOF WITHOUT THE FULL KNOWLEDGE AND WRITTEN CONSENT OF SCI Inc.
ALL PATENTABLE MATERIAL CONTAINED HEREIN AND ORIGINATING WITH SCI Inc SHALL BE THE PROPERTY OF SCI Inc

SILVER CREEK INDUSTRIES, INC.
"BUILDING FOR THE NEXT GENERATION"
SILVER CREEK
195 EAST MORGAN PERRIS, CALIFORNIA 92571
PHONE: 951-943-5393 FAX: 951-943-2211

PROJECT NAME:

CLASS LEASING
CLASSROOMS BLDG'S

SHEET TITLE:

ARCHITECTURAL DETAILS
FLOOR

TAVARES ASSOCIATES
STRUCTURAL ENGINEERING
Rancho Cucamonga, CA 91730
Phone: 909.466.0334
Fax: 909.466.0338
www.tavaresassociates.com

No. S-5555
REN: 10-31-2013
STATE OF CALIFORNIA
12/23/2011

ARCHITECT OF RECORD SUBMISSION STAMP
REGISTERED ARCHITECT
ROBERT A. McNEIL
C-10832
6-24-15
STATE OF CALIFORNIA

PROJECT SPECIFIC STATE AGENCY APPROVAL

IDENTIFICATION STAMP
DIV. OF THE STATE ARCHITECT
OFFICE OF REGULATION SERVICES
04 113850
AC FLS SS
DATE AUG 2 8 2014

ORIGINAL PC STATE AGENCY APPROVAL

PRE-CHECK (PC) DOCUMENT
A SEPARATE PROJECT APPLICATION FOR CONSTRUCTION IS REQUIRED

IDENTIFICATION STAMP
DIV. OF THE STATE ARCHITECT
OFFICE OF REGULATION SERVICES
PC 04-112070
AC FLS SS
DATE DEC 0 9 2011

REVISIONS

1	
2	
3	
4	
5	
6	
7	
8	

SILVER CREEK INDUSTRIES
30' x 32' PC

PROJECT NO:	
DRAWN BY:	
SCALE:	AS NOTED
DATE:	6-17-11

P.C. SHEET NUMBER

A-5.70