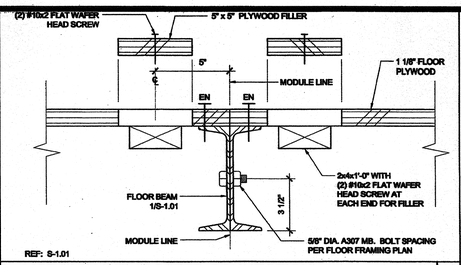

16 MODULE LINE - BOLTED CONNECTION SCALE : 3" = 1'-0"

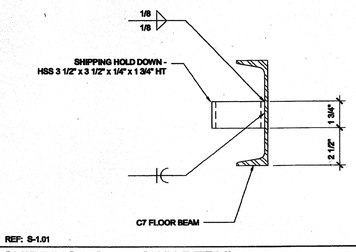

11 SHIPPING HOLD DOWN DETAIL SCALE : 3"=1'-0"

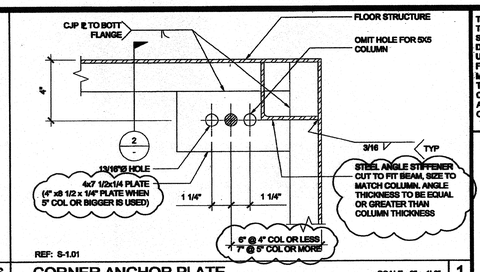

6 CORNER ANCHOR PLATE SCALE : 3" = 1'-0"

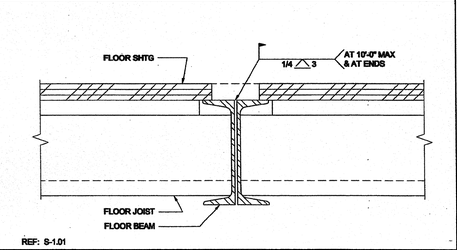

17 MODULE LINE CONNECTION (OPTION 1) SCALE : 3"=1'-0"

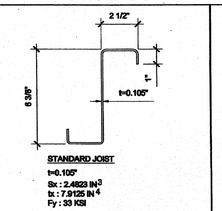

12 FLOOR JOIST SCALE : 3" = 1'-0"

ASTM A-1011, GRADE 33

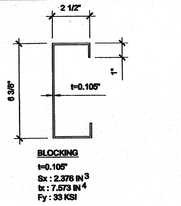

7B BLOCKING SCALE : 3" = 1'-0"

ASTM A-1011, GRADE 33

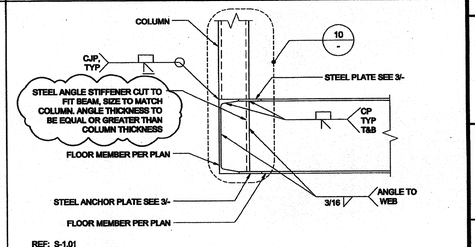

7A FLOOR BEAM TO COLUMN CONNECTION SCALE : 1 1/2" = 1'-0"

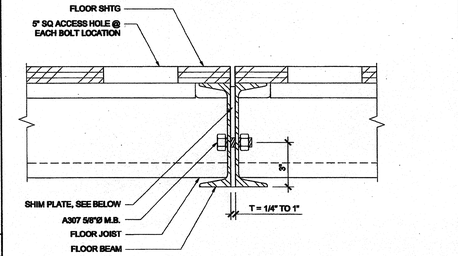

18

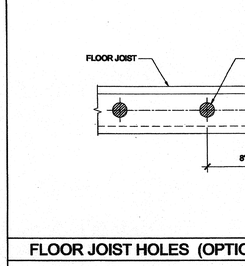

FLOOR JOIST HOLES (OPTIONAL) SCALE : 1/8" = 1'-0" 8

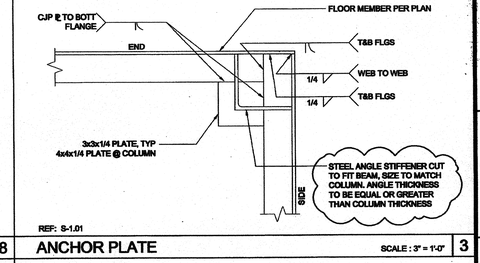

ANCHOR PLATE SCALE : 3" = 1'-0" 3

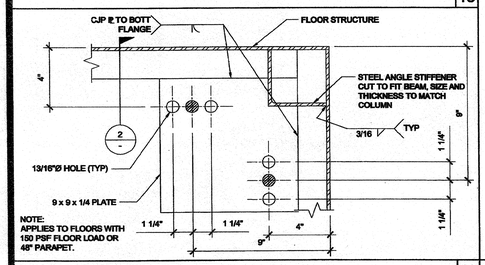

CORNER ANCHOR PLATE SCALE : 3" = 1'-0" 19

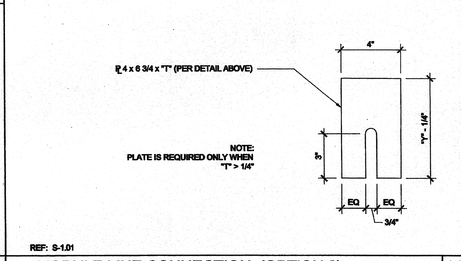

MODULE LINE CONNECTION (OPTION 2) SCALE : 3"=1'-0" 14

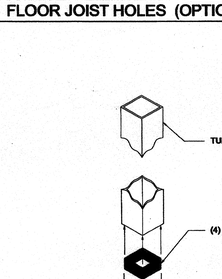

COLUMN CONNECTION AT FLOOR SCALE : NTS 10

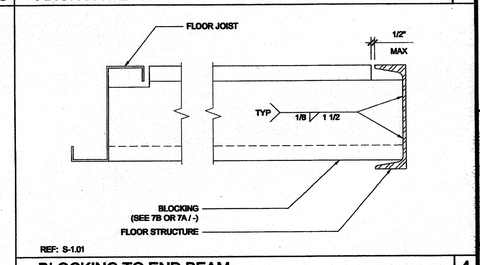

BLOCKING TO END BEAM SCALE : 3" = 1'-0" 4

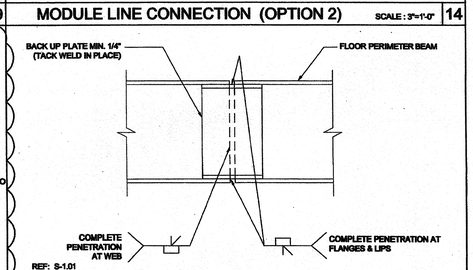

CORNER ANCHOR PLATE SCALE : 3" = 1'-0" 20

FLOOR BEAM SPLICE SCALE : 3" = 1'-0" 15

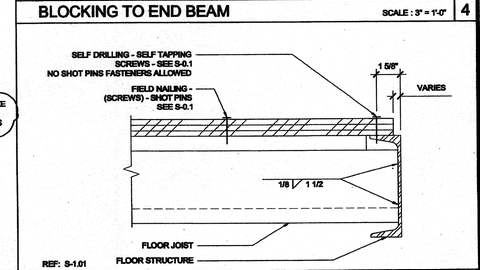

JOIST TO SIDE BEAM SCALE : 3" = 1'-0" 5

THESE DRAWINGS AND ALL MATERIAL CONTAINED HEREIN ARE THE PROPERTY OF SILVERCREEK INDUSTRIES, INC (SCI Inc) AND SHALL NOT BE REPRODUCED, COPIED OR OTHERWISE DISPOSED OF DIRECTLY OR INDIRECTLY AND SHALL NOT BE USED IN WHOLE OR IN PART TO ASSIST IN THE MAKING OF OR FOR THE PURPOSE OF FURNISHING ANY INFORMATION FOR THE MAKING OF DRAWINGS, PRINTS, APPARATUS OR PARTS THEREOF WITHOUT THE FULL KNOWLEDGE AND WRITTEN CONSENT OF SCI Inc.
ALL PATENTABLE MATERIAL CONTAINED HEREIN AND ORIGINATING WITH SCI Inc SHALL BE THE PROPERTY OF SCI Inc

SILVER CREEK INDUSTRIES, INC.
"BUILDING FOR THE NEXT GENERATION"
SILVER CREEK
195 EAST MORGAN PERRIS, CALIFORNIA 92571
PHONE: 951-943-5393 FAX: 951-943-2211

PROJECT NAME:

CLASS LEASING
CLASSROOMS BLDG'S

SHEET TITLE:

FLOOR FRAMING DETAILS
WOOD FLOOR

SEP 19 2012

ARCHITECT OF RECORD SUBMISSION DATE

REGISTERED ARCHITECT ALBERT A. WEBB C10322 11-25-16 STATE OF CALIFORNIA

PROJECT SPECIFIC STATE AGENCY APPROVAL

IDENTIFICATION STAMP DIV. OF THE STATE ARCHITECT OFFICE OF REGULATION SERVICES
04 113850
AC FLS SS
DATE AUG 28 2014

ORIGINAL PC STATE AGENCY APPROVAL

PRE-CHECK (PC) DOCUMENT CONFORMS WITH APPLICATION FOR CONSTRUCTION IS REQUIRED

IDENTIFICATION STAMP DIV. OF THE STATE ARCHITECT OFFICE OF REGULATION SERVICES
PC 04-112070
AC FLS SS
DATE JAN 09 2015

REVISED

REVISIONS

1	PC REVISION 08/16/2012
2	
3	
4	
5	
6	
7	
8	

SILVER CREEK INDUSTRIES
30' x 32' PC

PROJECT NO:	
DRAWN BY:	
SCALE:	AS NOTED
DATE:	12-12-12

P.C. SHEET NUMBER

S-1.50