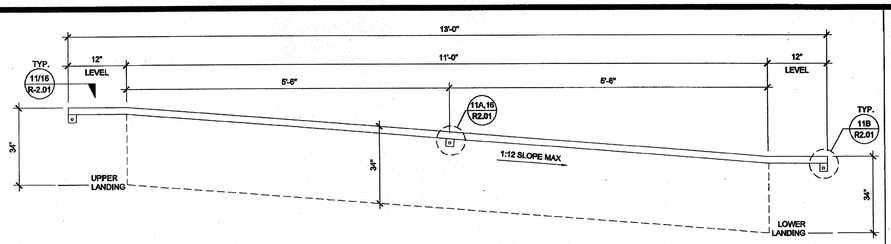


## HANDRAIL ATTACHMENT TO BUILDING

SCALE : 1" = 1'-0" | 6

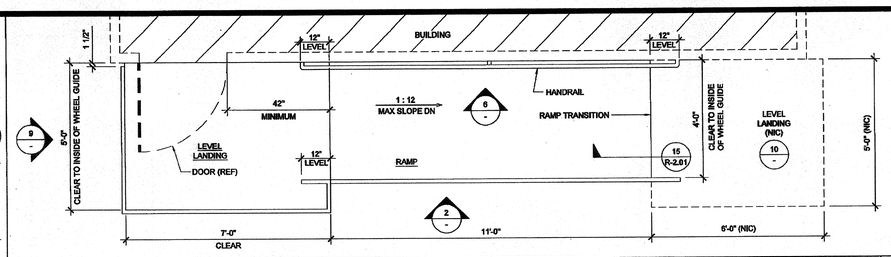


## RAMP AND LANDING AT BUILDING

SCALE : 1/2" = 1'-0" | 1

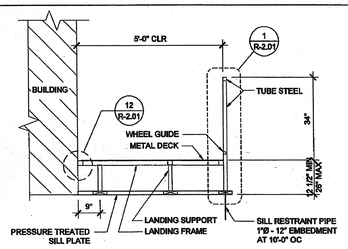


11 SECTION AT LANDING

SCALE : 1/2" = 1'-0" | 7

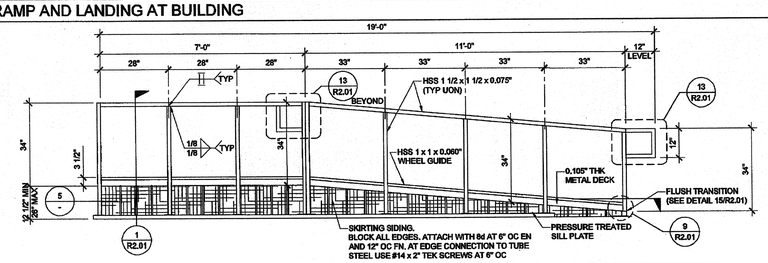


## RAMP AND LANDING ELEVATION

SCALE : 1/2" = 1'-0" | 2

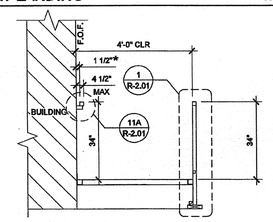


NOTE (a)
1. ALL SURFACES SHALL BE SMOOTH WITH NO SHARP CORNERS, PER CBC 1133.5.5.1
WALL TO BE SMOOTH AND TO EXTEND 8" ABOVE HANDRAIL

12 SECTION AT RAMP

SCALE : 1/2" = 1'-0" | 8

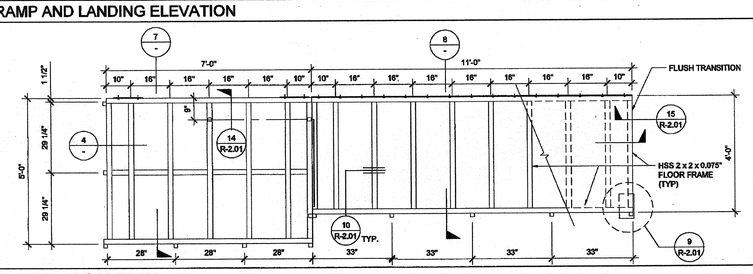


## RAMP FRAMING PLAN

SCALE : 1/2" = 1'-0" | 3

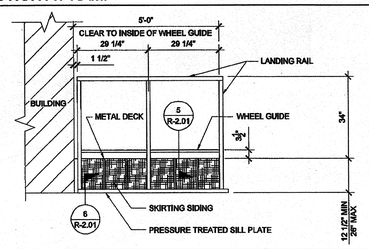


13 LANDING ELEVATION

SCALE : 1/2" = 1'-0" | 9

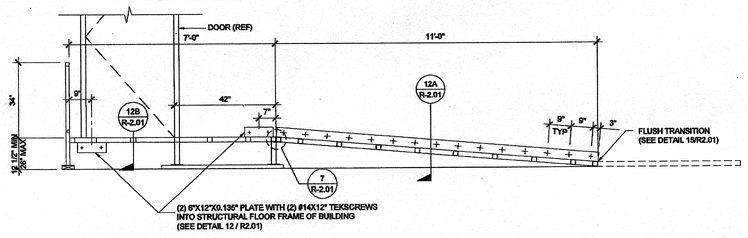


## SECTION AT RAMP AND LANDING

SCALE : 1/2" = 1'-0" | 4

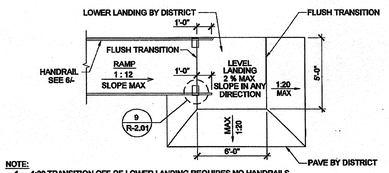


NOTE:
1. 1:20 TRANSITION OFF OF LOWER LANDING REQUIRES NO HANDRAILS.
2. TRANSITIONS EXCEEDING 1:20 BUT NOT TO EXCEED 1:12 REQUIRE REMOVAL OF 12" HANDRAIL EXTENSION AND ADDITIONAL HANDRAILING BY DISTRICT.
THIS CONDITION REQUIRES A SITE SPECIFIC DETAIL PROVIDED BY ARCHITECT TO DEMONSTRATE ACCESSIBLE RAMP.

14 RAMP TRANSITION

SCALE: NTS | 10

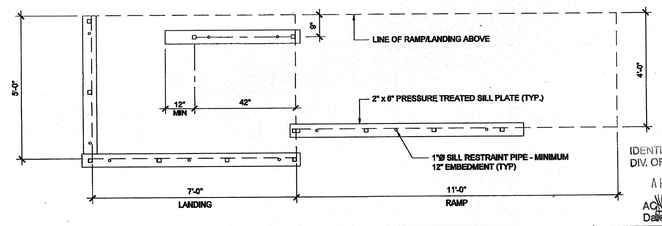


IDENTIFICATION STAMP
DIV. OF THE STATE ARCHITECT
APP03 116979
ACN FLS SS
Date 4-13-16

## SILL PLAN FOR RAMP AND LANDING

SCALE : 1/2" = 1'-0" | 5

THESE DRAWINGS AND ALL MATERIAL CONTAINED HEREIN ARE THE PROPERTY OF SILVERCREEK INDUSTRIES, INC (SCI Inc) AND SHALL NOT BE REPRODUCED, COPIED OR OTHERWISE DISPOSED OF DIRECTLY OR INDIRECTLY AND SHALL NOT BE USED IN WHOLE OR IN PART TO ASSIST IN THE MAKING OF OR FOR THE PURPOSE OF FURNISHING ANY INFORMATION FOR THE MAKING OF DRAWINGS, PRINTS, APPARATUS OR PARTS THEREOF WITHOUT THE FULL KNOWLEDGE AND WRITTEN CONSENT OF SCI Inc.
ALL PATENTABLE MATERIAL CONTAINED HEREIN AND ORIGINATING WITH SCI Inc SHALL BE THE PROPERTY OF SCI Inc

SILVER CREEK INDUSTRIES, INC.
"BUILDING FOR THE NEXT GENERATION"
SILVER CREEK
195 EAST MORGAN PERRIS, CALIFORNIA 92571
PHONE: 951-943-5393 FAX: 951-943-2211

PROJECT NAME:

CLASS LEASING
CLASSROOMS BLDG'S

SHEET TITLE:

RAMP LANDING

TAVARES & ASSOCIATES
STRUCTURAL ENGINEERS
No. C-38354
REN: 12-31-2013
STATE OF CALIFORNIA

12/23/2011

ARCHITECT OF RECORD
SUBMISSION STAMP
REGISTERED ARCHITECT
C10622
2-28-12
STATE OF CALIFORNIA

PROJECT SPECIFIC STATE AGENCY APPROVAL
IDENTIFICATION STAMP
DIV. OF THE STATE ARCHITECT
OFFICE OF REGULATION SERVICES
04 113850
ACN FLS SS DMJ
DATE AUG 28 2014

ORIGINAL PC STATE AGENCY APPROVAL
PRE-CHECK PCS DOCUMENT
SCOPE PCS USE
A SEPARATE PROJECT APPLICATION
FOR CONSTRUCTION IS REQUIRED
IDENTIFICATION STAMP
DIV. OF THE STATE ARCHITECT
OFFICE OF REGULATION SERVICES
PC 04-112070
ACN FLS SS
DATE DEC 9 2011

REVISIONS
1
2
3
4
5
6
7
8

SILVER CREEK INDUSTRIES
30' x 32' PC

| | |
|---|---|
| PROJECT NO: | |
| DRAWN BY: | |
| SCALE: | AS NOTED |
| DATE: | 6-17-11 |
| P.C. SHEET NUMBER | R-1.01 |