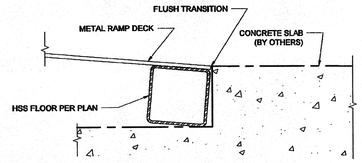

FLUSH TRANSITION AT BOTTOM OF RAMP SCALE : 6" = 1'-0" | 15

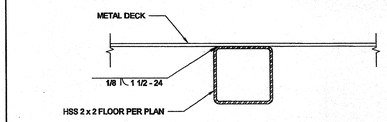

DECK TO FRAME SCALE : 6" = 1'-0" | 10

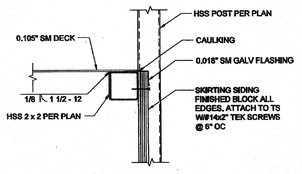

SKIRT FLASHING SCALE : 3" = 1'-0" | 5

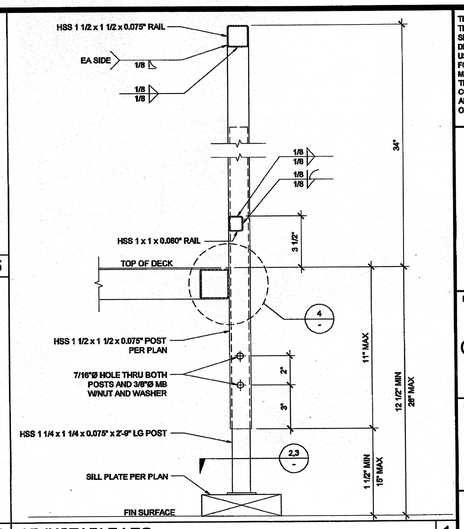

ADJUSTABLE LEG SCALE : 3" = 1'-0" | 1

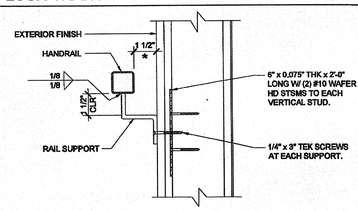

NOTE (a)
1. ALL SURFACES SHALL BE SMOOTH WITH NO SHARP CORNERS, PER CBC 1133B.5.5 WALL TO BE SMOOTH AND TO EXTEND 12" ABOVE HANDRAIL

HANDRAIL CONNECTION AT SHEETMETAL BLKG SCALE : 3" = 1'-0" | 16

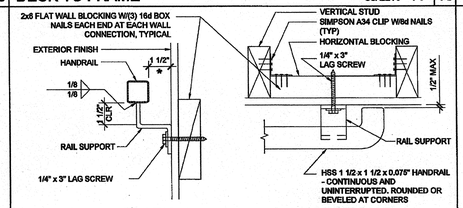

SECTION A SECTION B

NOTE (a)
1. ALL SURFACES SHALL BE SMOOTH WITH NO SHARP CORNERS, PER CBC 1133B.5.5 WALL TO BE SMOOTH AND TO EXTEND 12" ABOVE HANDRAIL

HANDRAIL CONNECTION AT WOOD BLOCKING SCALE : 3" = 1'-0" | 11

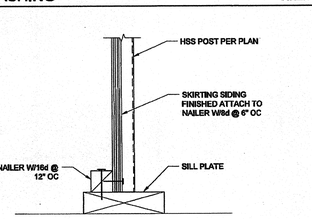

SKIRT FLASHING AT SILL PLATE SCALE : 3" = 1'-0" | 6

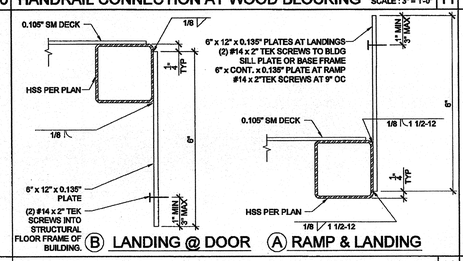

17 (B) LANDING @ DOOR (A) RAMP & LANDING

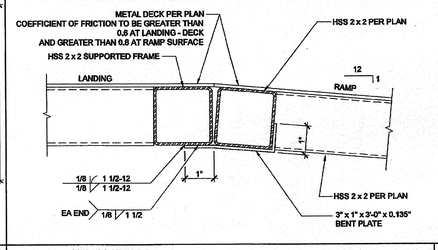

RAMP AT LANDING SCALE : 6" = 1'-0" | 7

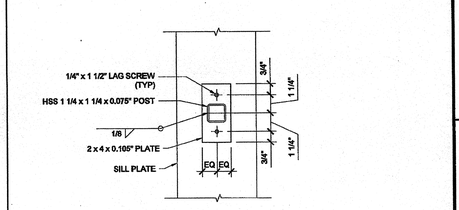

ADJUSTABLE LEG BASE PLATE SCALE : 3" = 1'-0" | 2

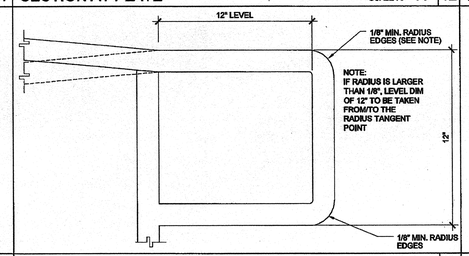

EXTEND HANDRAIL @ TOP OR BOTT. ENDS SCALE : 3" = 1'-0" | 13

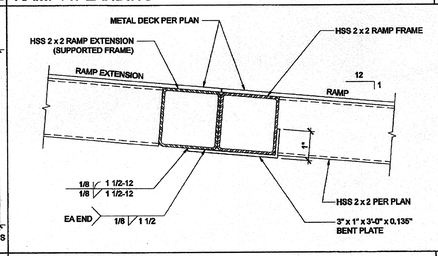

RAMP EXTENSION SCALE : 6" = 1'-0" | 8

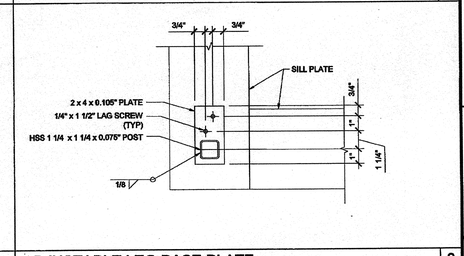

ADJUSTABLE LEG BASE PLATE SCALE : 3" = 1'-0" | 3

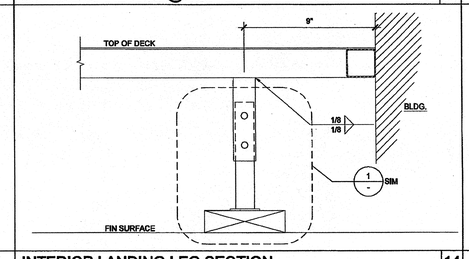

INTERIOR LANDING LEG SECTION SCALE : 3" = 1'-0" | 14

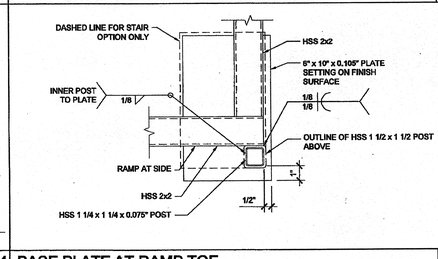

BASE PLATE AT RAMP TOE SCALE : 3" = 1'-0" | 9

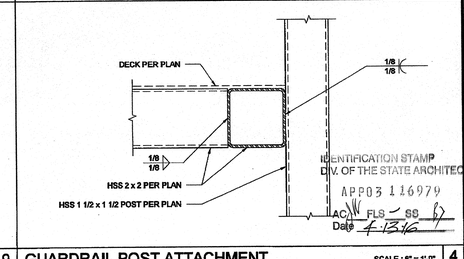

GUARDRAIL POST ATTACHMENT SCALE : 6" = 1'-0" | 4

THESE DRAWINGS AND ALL MATERIAL CONTAINED HEREIN ARE THE PROPERTY OF SILVERCREEK INDUSTRIES, INC (SCI Inc) AND SHALL NOT BE REPRODUCED, COPIED OR OTHERWISE DISPOSED OF DIRECTLY OR INDIRECTLY AND SHALL NOT BE USED IN WHOLE OR IN PART TO ASSIST IN THE MAKING OF OR FOR THE PURPOSE OF FURNISHING ANY INFORMATION FOR THE MAKING OF DRAWINGS, PRINTS, APPARATUS OR PARTS THEREOF WITHOUT THE FULL KNOWLEDGE AND WRITTEN CONSENT OF SCI Inc.
ALL PATENTABLE MATERIAL CONTAINED HEREIN AND ORIGINATING WITH SCI Inc SHALL BE THE PROPERTY OF SCI Inc

SILVER CREEK INDUSTRIES, INC.
"BUILDING FOR THE NEXT GENERATION"
SILVER CREEK
195 EAST MORGAN PERRIS, CALIFORNIA 92571
PHONE: 951-943-5393 FAX: 951-943-2211

PROJECT NAME:
CLASS LEASING
CLASSROOMS BLDG'S

SHEET TITLE:
RAMP DETAILS

TAVARES ASSOCIATES
STRUCTURAL ENGINEERS
No. C-28354
REN: 10-31-2013
12/23/2011

ARCHITECT OF RECORD SUBMISSION NOTED
ROBERT A. WETMORE
No. C10322
12-28-15
STATE OF CALIFORNIA

PROJECT SPECIFIC STATE AGENCY APPROVAL
IDENTIFICATION STAMP
DIV. OF THE STATE ARCHITECT
OFFICE OF REGULATION SERVICES
04 113850
AC FLS SS
DATE AUG 20 2014

ORIGINAL PC STATE AGENCY APPROVAL
PRE-CHECK (PC) DOCUMENT CODE 2013 CBC A REPRESENTATIVE OF THE OWNER MUST BE PRESENT FOR CONSTRUCTION IS REQUIRED
IDENTIFICATION STAMP
DIV. OF THE STATE ARCHITECT
OFFICE OF REGULATION SERVICES
PC 04-112070
AC FLS SS
DATE DEC 0 9 2015

REVISIONS
1
2
3
4
5
6
7
8
9

SILVER CREEK INDUSTRIES
30' x 32' PC

PROJECT NO:
DRAWN BY:
SCALE: AS NOTED
DATE: 6-17-11

P.C. SHEET NUMBER
R-2.01