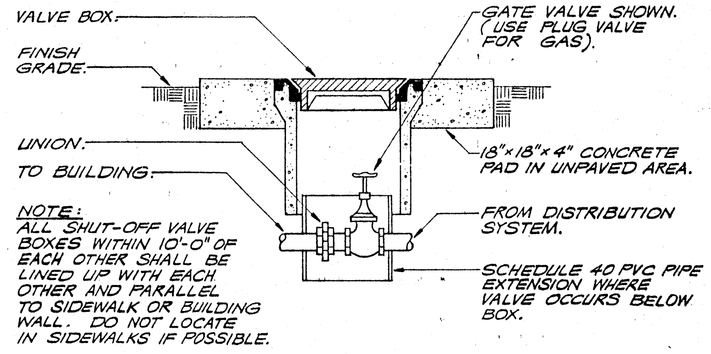

SHUT-OFF VALVE IN BOX DETAIL (H / M-4)

SCALE: NONE

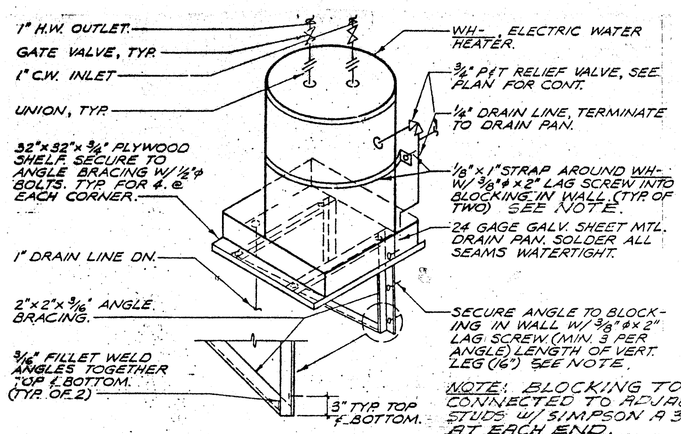

WATER HEATER DETAIL (C / M-4)

SCALE: NONE

NOTE:

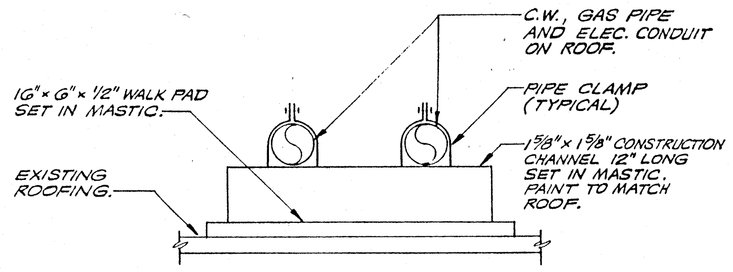

PIPE SUPPORT DETAIL (D / M-4)

SCALE: NONE

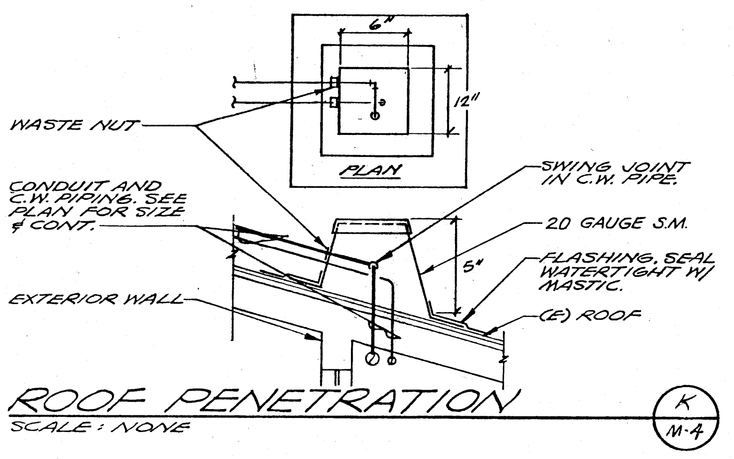

ROOF PENETRATION (K / M-4)

SCALE: NONE

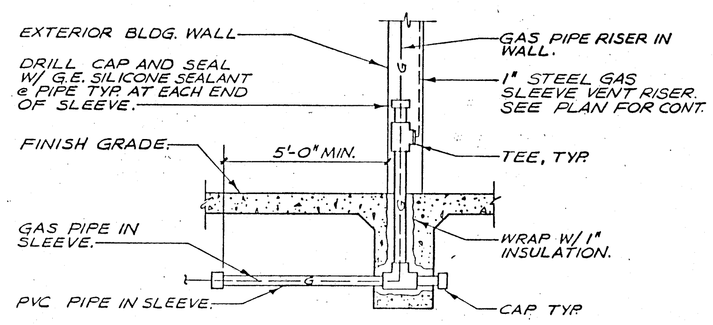

GAS PIPE IN SLEEVE DETAIL (J / M-4)

SCALE: NONE

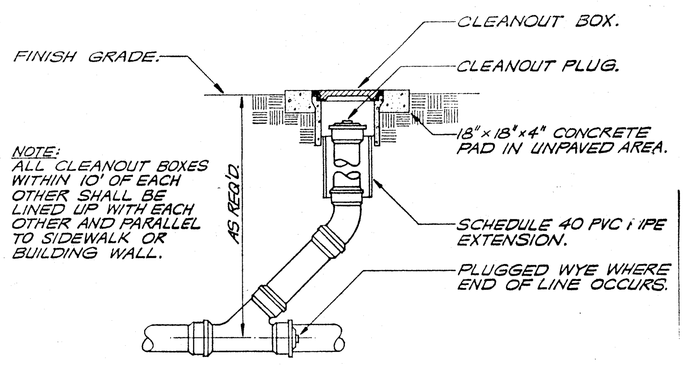

CLEANOUT TO GRADE DETAIL (E / M-4)

SCALE: NONE

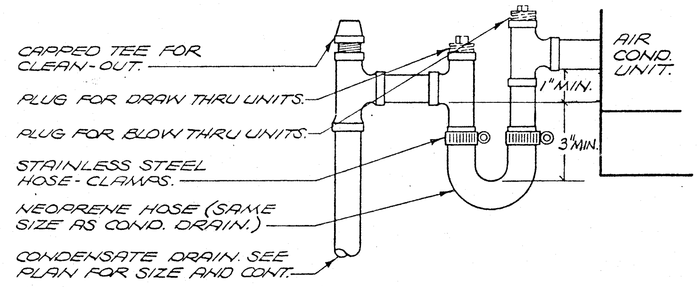

CONDENSATE DRAIN CONNECTION (F / M-4)

SCALE: NONE

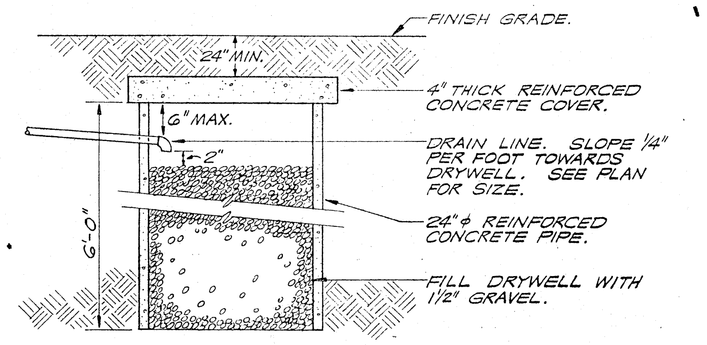

DRYWELL DETAIL (G / M-4)

SCALE: NONE

KEYNOTES

1. EXISTING WATER CLOSET TO BE REMOVED. CAP PIPING BEHIND FINISHED SURFACES.
2. EXISTING WATER CLOSET TO REMAIN. PROVIDE NEW FLUSH VALVE ASSEMBLY FV-1, NEW SEAT WCS-2 AND SUPPLY PIPE.
3. EXISTING WATER CLOSET TO REMAIN. PROVIDE NEW FLUSH VALVE ASSEMBLY FV-1, NEW SEAT WCS-1 AND SUPPLY PIPE.
4. EXISTING LAVATORY TO BE REMOVED, SCRUBBED CLEAN AND RESET IN THE SAME LOCATION AFTER ALL ARCHITECTURAL WORK IS COMPLETED. RECONNECT TO EXISTING PIPING. PROVIDE NEW P-TRAP, TRAP ARM, WATER STOP AND SUPPLY AND RECONNECT TO EXISTING PIPING.
5. EXISTING LAVATORY TO BE REMOVED, SCRUBBED CLEAN AND RESET IN THE SAME LOCATION AFTER ALL ARCHITECTURL WORK IS COMPLETED. MOUNT AT HANDICAP HEIGHT. PROVIDE NEW LT-1, P-TRAP, TRAP ARM, WATER STOPS AND SUPPLY AND RECONNECT TO EXISTING PIPING.
6. EXISTING URINALS TO REMAIN. SCRUB CLEAN AND PROVIDE NEW FLUSH VALVE ASSEMBLY FV-2 AND BEEHIVE STRAINER. RECONNECT TO EXISTING PIPING. (1) FIXTURE WITH
7. EXISTING SERVICE SINK TO BE REMOVED. CAP PIPING BEHIND FINISHED SURFACES.
8. EXISTING FLOOR DRAIN TO BE REMOVED AND REPLACED WITH NEW FD-1 IN THE SAME LOCATION. SET TO NEW FINISHED FLOOR. RECONNECT TO EXISTING PIPING.
9. EXISTING DRINKING FOUNTAIN TO BE REMOVED AND REPLACED WITH NEW DF-1. PROVIDE NEW P-TRAP, TRAP ARM, WATER STOP AND SUPPLY. SEE PLAN FOR PIPING.
10. NEW WALL MOUNT HANDICAP DRINKING FOUNTAIN DF-2. PROVIDE NEW P-TRAP, TRAP ARM, WATER STOP AND SUPPLY. SEE PLAN FOR PIPING.
11. EXISTING WATER CLOSET TO BE *REMOVED & RELOCATED. CAP PIPING BEHIND* FINISHED SURFACES. SEE PLAN FOR NEW LOCATION. PROVIDE NEW FLUSH VALVE ASSEMBLY FV-1, NEW SEAT WCS-1 AND SUPPLY PIPE.
12. EXISTING URINALS TO BE REMOVED. CAP PIPING BEHIND FINISHED SURACES.

NOTE:
ALL KEY NOTE NUMBERS ON THIS SHEET REFER TO THE ITEMS ON THIS SHEET ONLY! AND DO NOT APPLY TO THE NUMBERS SHOWN ELSEWHERE IN THIS SET OF PLANS.

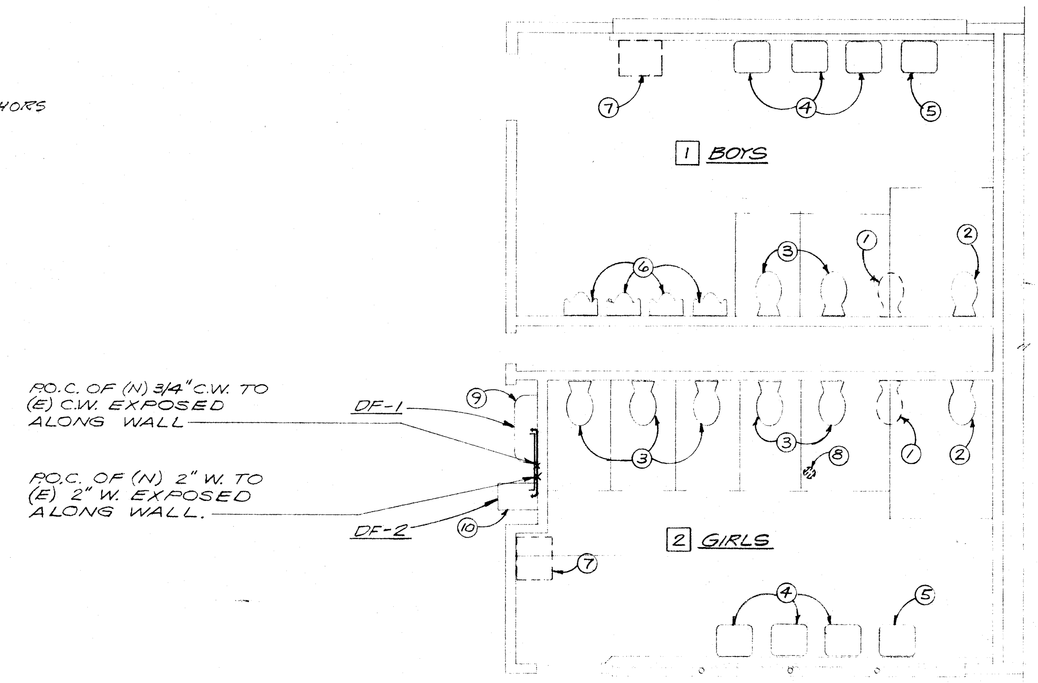

PLUMBING DETAIL (A / M-4)

SCALE: 1/4" = 1'-0"

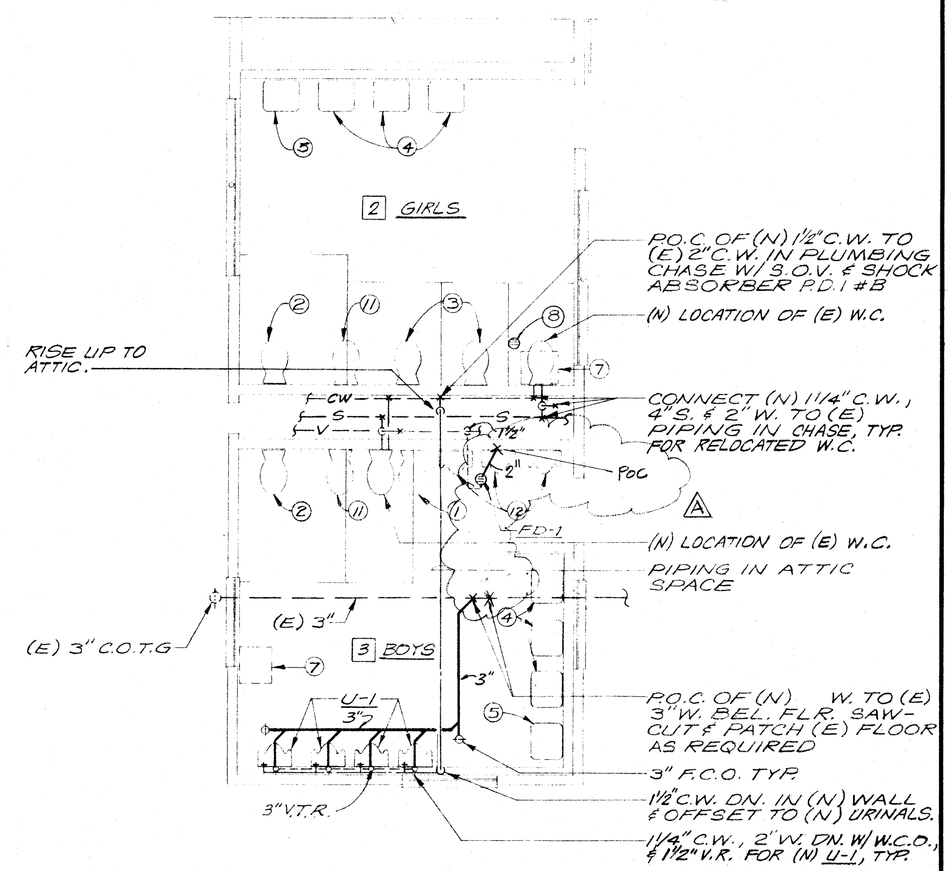

PLUMBING DETAIL (B / M-4)

SCALE: 1/4" = 1'-0"

ROBERT F. STUHR ARCHITECT INC.
3121 CALIFORNIA AVE.
BAKERSFIELD CA.
93304 (805) 327-1632
ROBERT F. STUHR AIA C-1610
WILLIAM J. MELBY AIA C-16835
DANNY E. ORDIZ AIA C-14728

Donald R. Lawrence & Associates
CONSULTING MECHANICAL ENGINEERS, INCORPORATED
1300 W. Shaw Avenue, Suite 2B Fresno, CA 93711
(209) 226-0181 ME11064 FAX 209-226-6327

IDENTIFICATION STAMP
Department of General Services
Office of the State Architect
AUG 11 1989
Structural Safety Section
Appl. # : 51-72A
Backchecked By: M.A.I.Z.A.

5192/83

PLUMBING DETAILS

PIONEER DRIVE SCHOOL MODERNIZATION
BAKERSFIELD CITY SCHOOL DISTRICT
BAKERSFIELD, KERN COUNTY, CALIFORNIA

'As Builts'

CHECK AND VERIFY ALL DIMENSIONS BEFORE PROCEEDING WITH THE WORK. REPORT DISCREPANCIES TO THE ARCHITECT. ALL CONSTRUCTION SHALL CONFORM TO UBC.

MARK	DATE	REVISIONS
△		
△		
△		
△		
A	5-4-92	'AS BUILTS'

JOB NO:
DRAWN: GONZALES
CHECKED: QUISTAD
DATE:

M

4
OF 11 SHEETS

BLUEPRINT SERVICE 110182