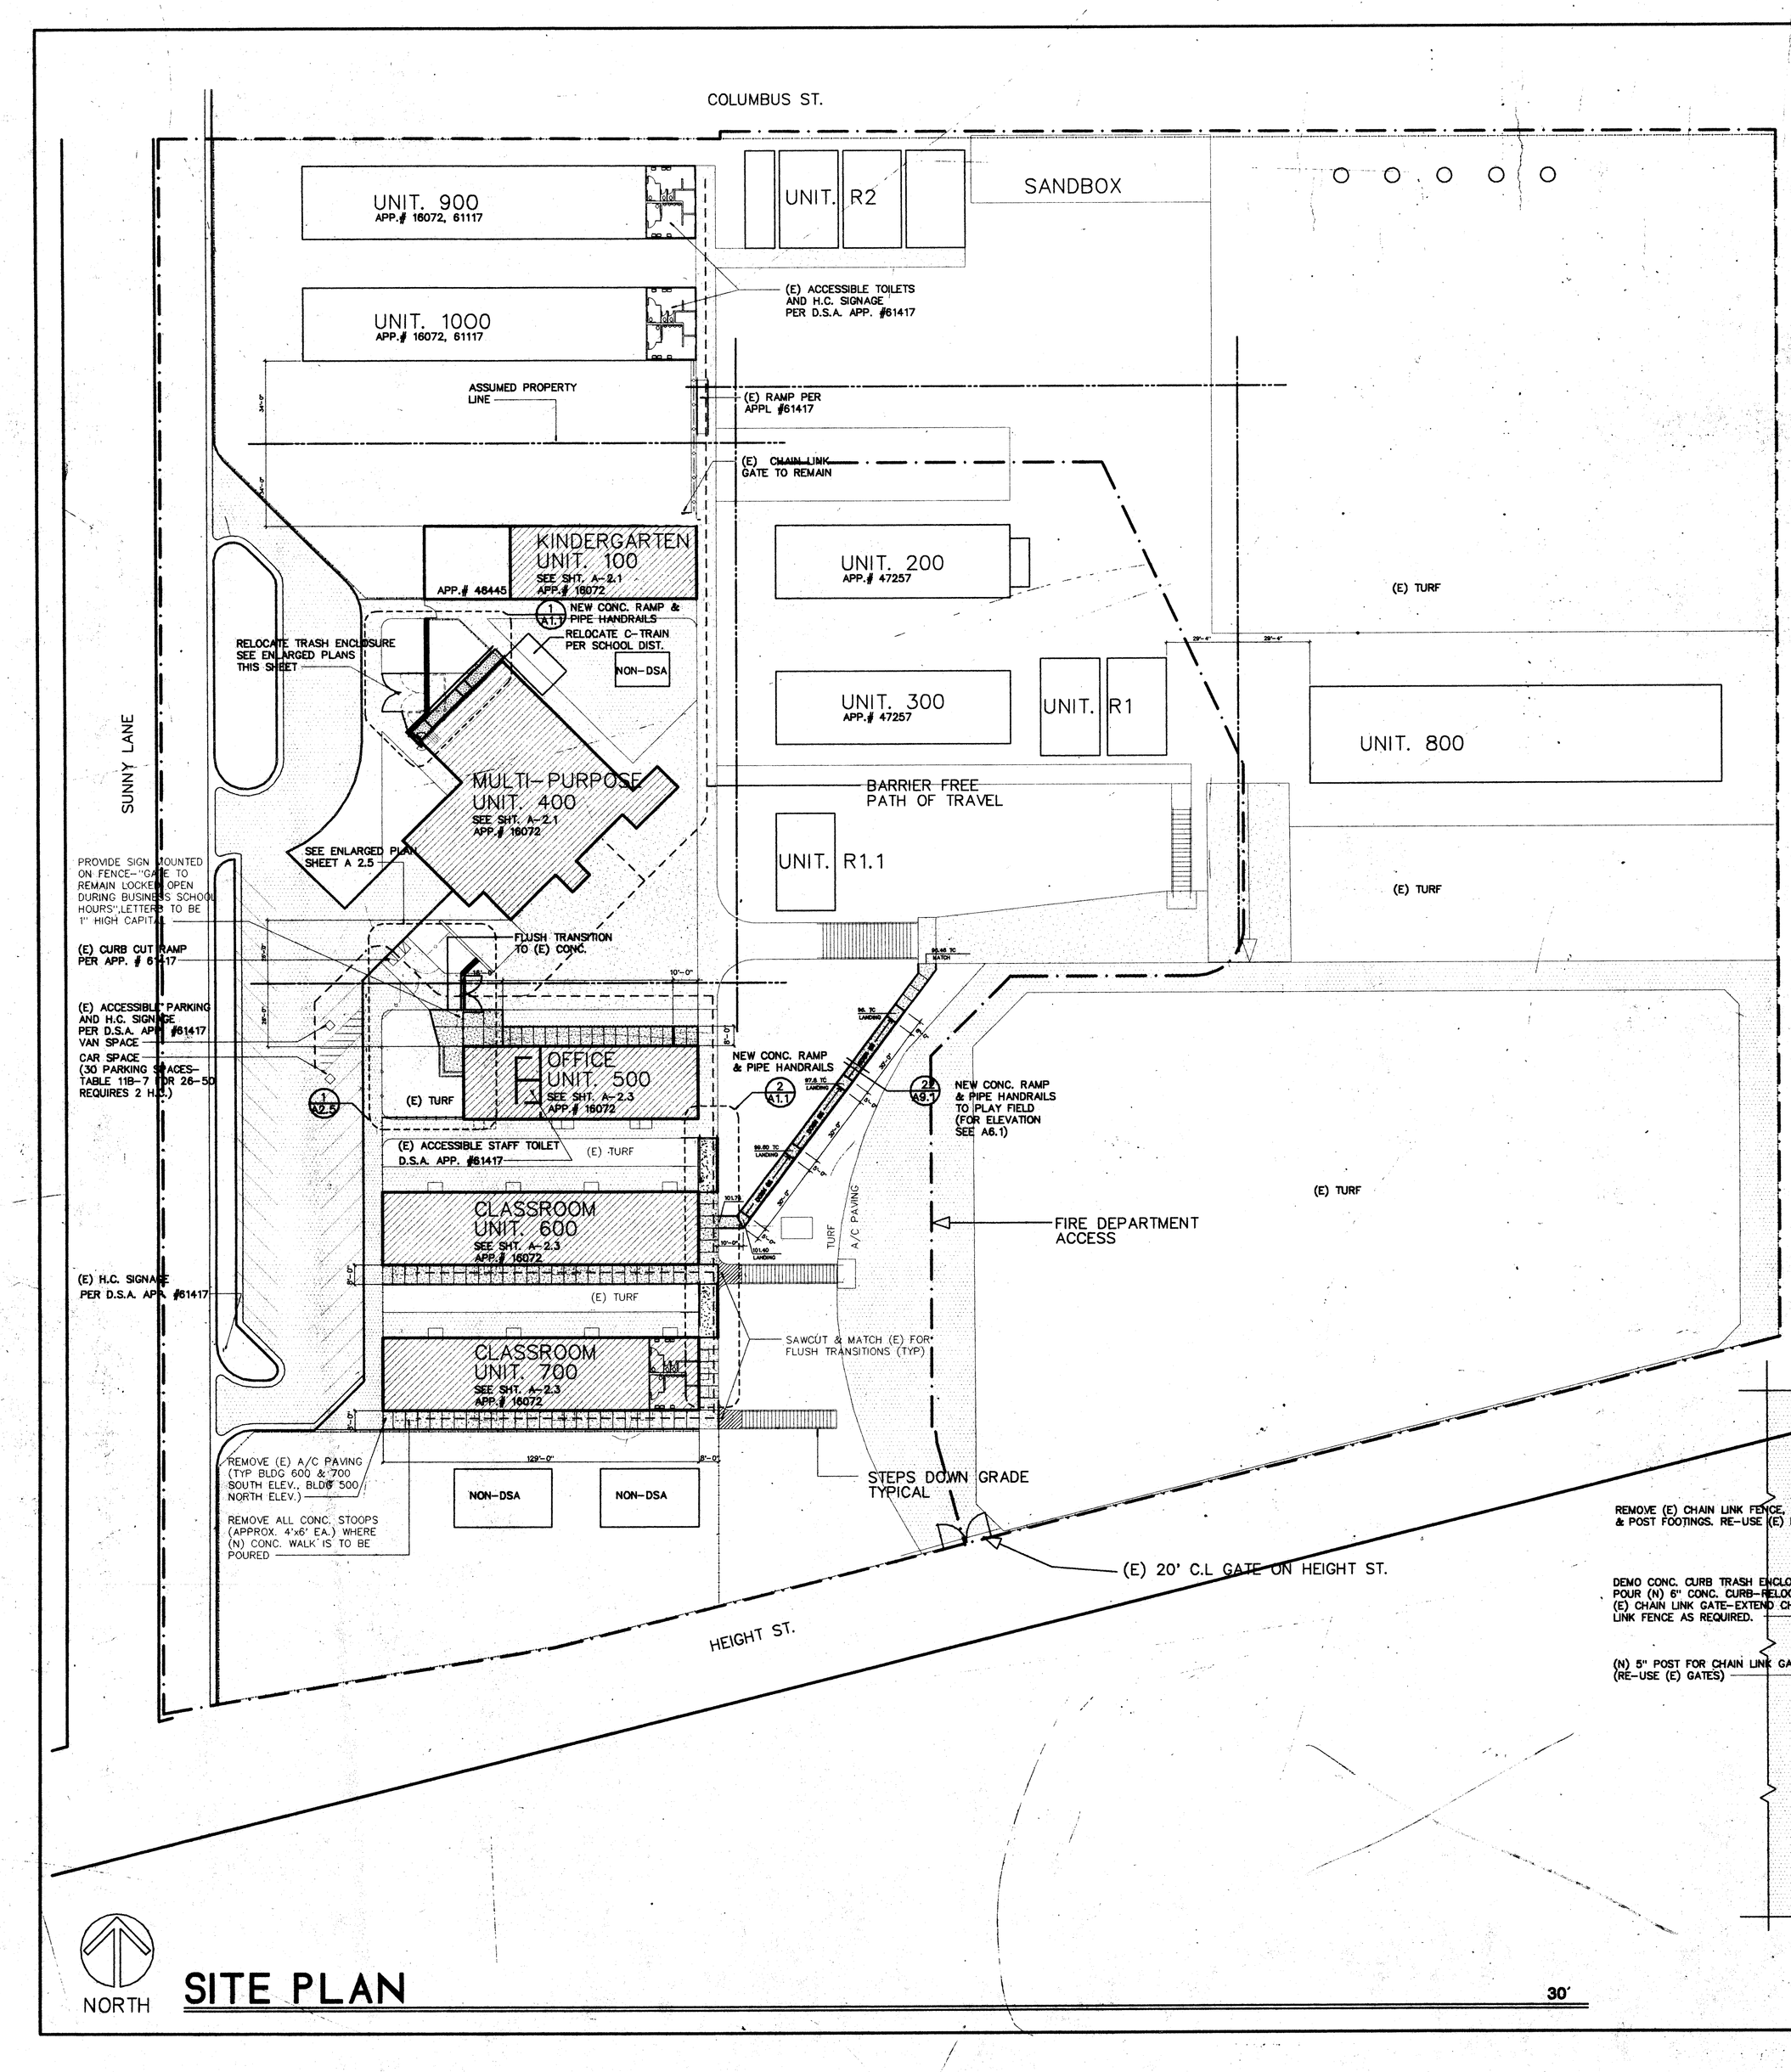

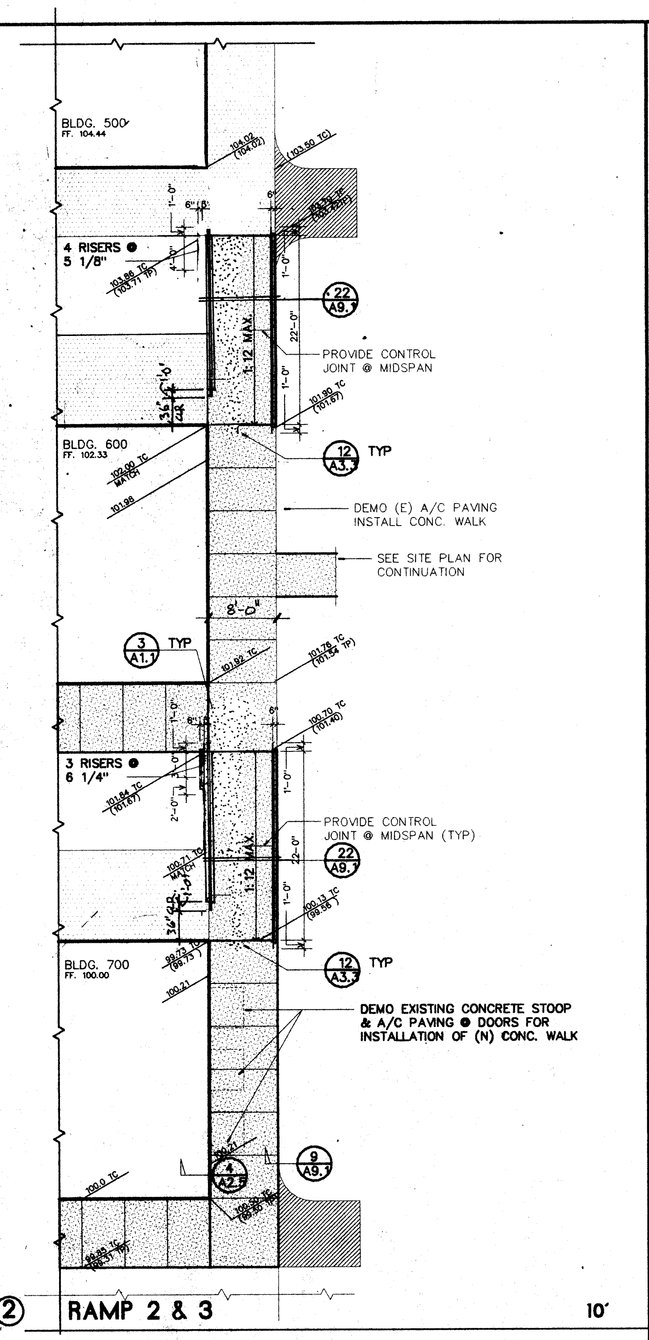

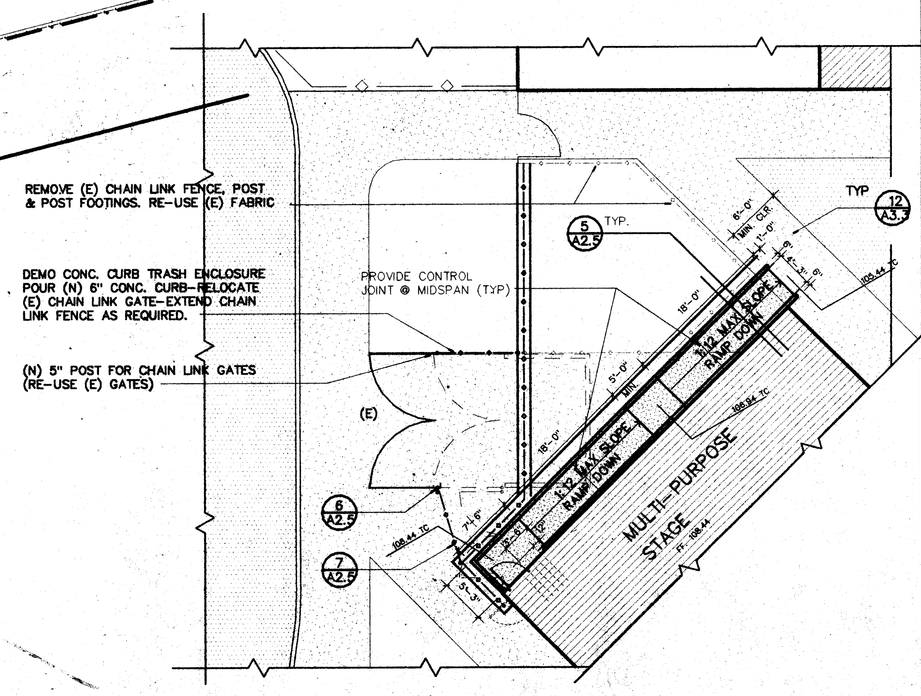

KEY NOTES
THIS SHEET ONLY

LEGEND

- BUILDING TO BE REMODELED
- (E) AC PAVING
- (E) CONCRETE
- (N) CONCRETE – SEE SEE ENLARGED PLAN
- ADDITIVE ALT. TO REMOVE (E) A/C PAVING & INSTALL NEW CONC. WALK

ORDIZ MELBY
ARCHITECTS INC.

5620 DISTRICT BLVD. #105
BAKERSFIELD, CA. 93313
TEL (805)-832-5258
FAX (805)-832-4291

LICENSED ARCHITECT WILLIAM JOHN MELBY No. C-16835 DEC. 31 1999 RENEWAL DATE STATE OF CALIFORNIA

DANNY E. ORDIZ A.I.A.
ARCHITECT C-14,728

WILLIAM J. MELBY A.I.A.
ARCHITECT C-16,835

IDENTIFICATION STAMP
DIV. OF STATE ARCHITECT
OFFICE OF REGULATIONS SERVICES
APPL. 101484
A.C. FLS. SS. MC
DATE 1-13-1999

AS BUILT DRAWINGS

MODERNIZATION OF COLLEGE HEIGHTS ELEM. SCHOOL FOR:

BAKERSFIELD CITY SCHOOL DISTRICT

2551 SUNNY LN.
BAKERSFIELD,
CALIFORNIA
93305

CHECK AND VERIFY ALL DIMENSIONS BEFORE PROCEEDING WITH THE WORK REPORT DISCREPANCIES TO THE ARCHITECT

MARK	DATE	REVISION

SITE PLAN
30 SCALE

JOB NUMBER 97140
DATE 1/6/99
DRAWN BY M.K.B.

A SHEET 1.1 OF 20