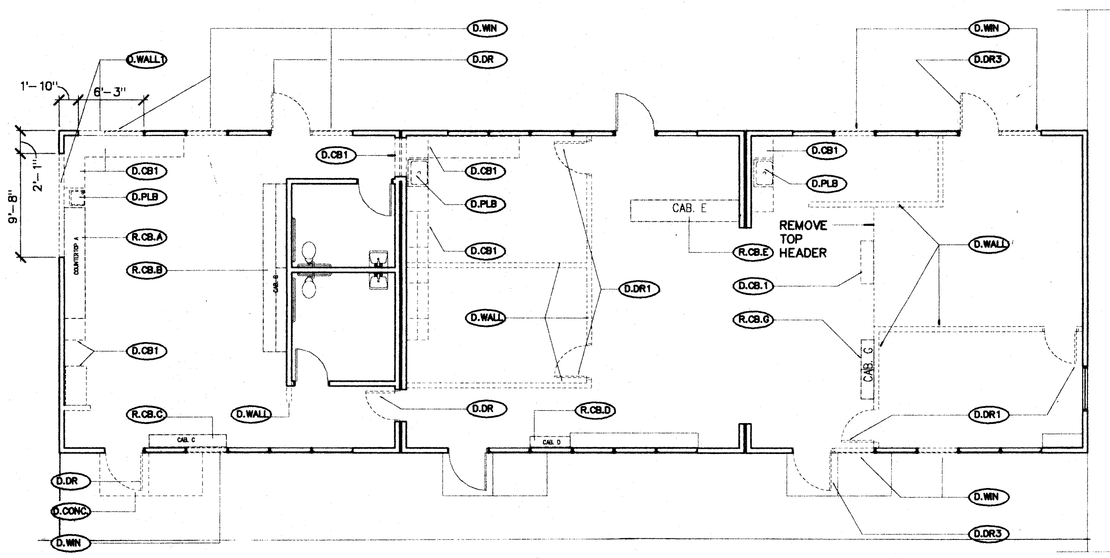

UNIT 500-DEMO PLAN (D.FLR) TYPICAL

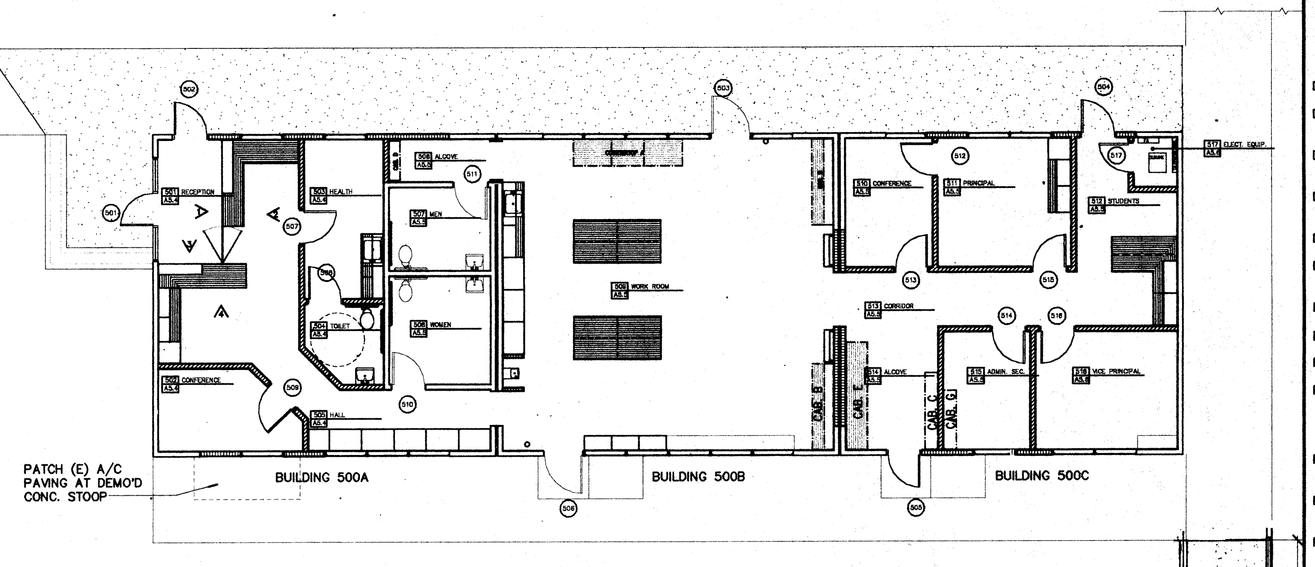
PATCH (E) A/C PAVING AT DEMO'D CONC. STOOP
BUILDING 500A
BUILDING 500B
BUILDING 500C
RECEPTION
HEALTH
MEN
WOMEN
TOILET
CONFERENCE
HALL
WORK ROOM
CONFERENCE
PRINCIPAL
STUDENTS
CORRIDOR
ADMIN. SEC.
VICE PRINCIPAL
