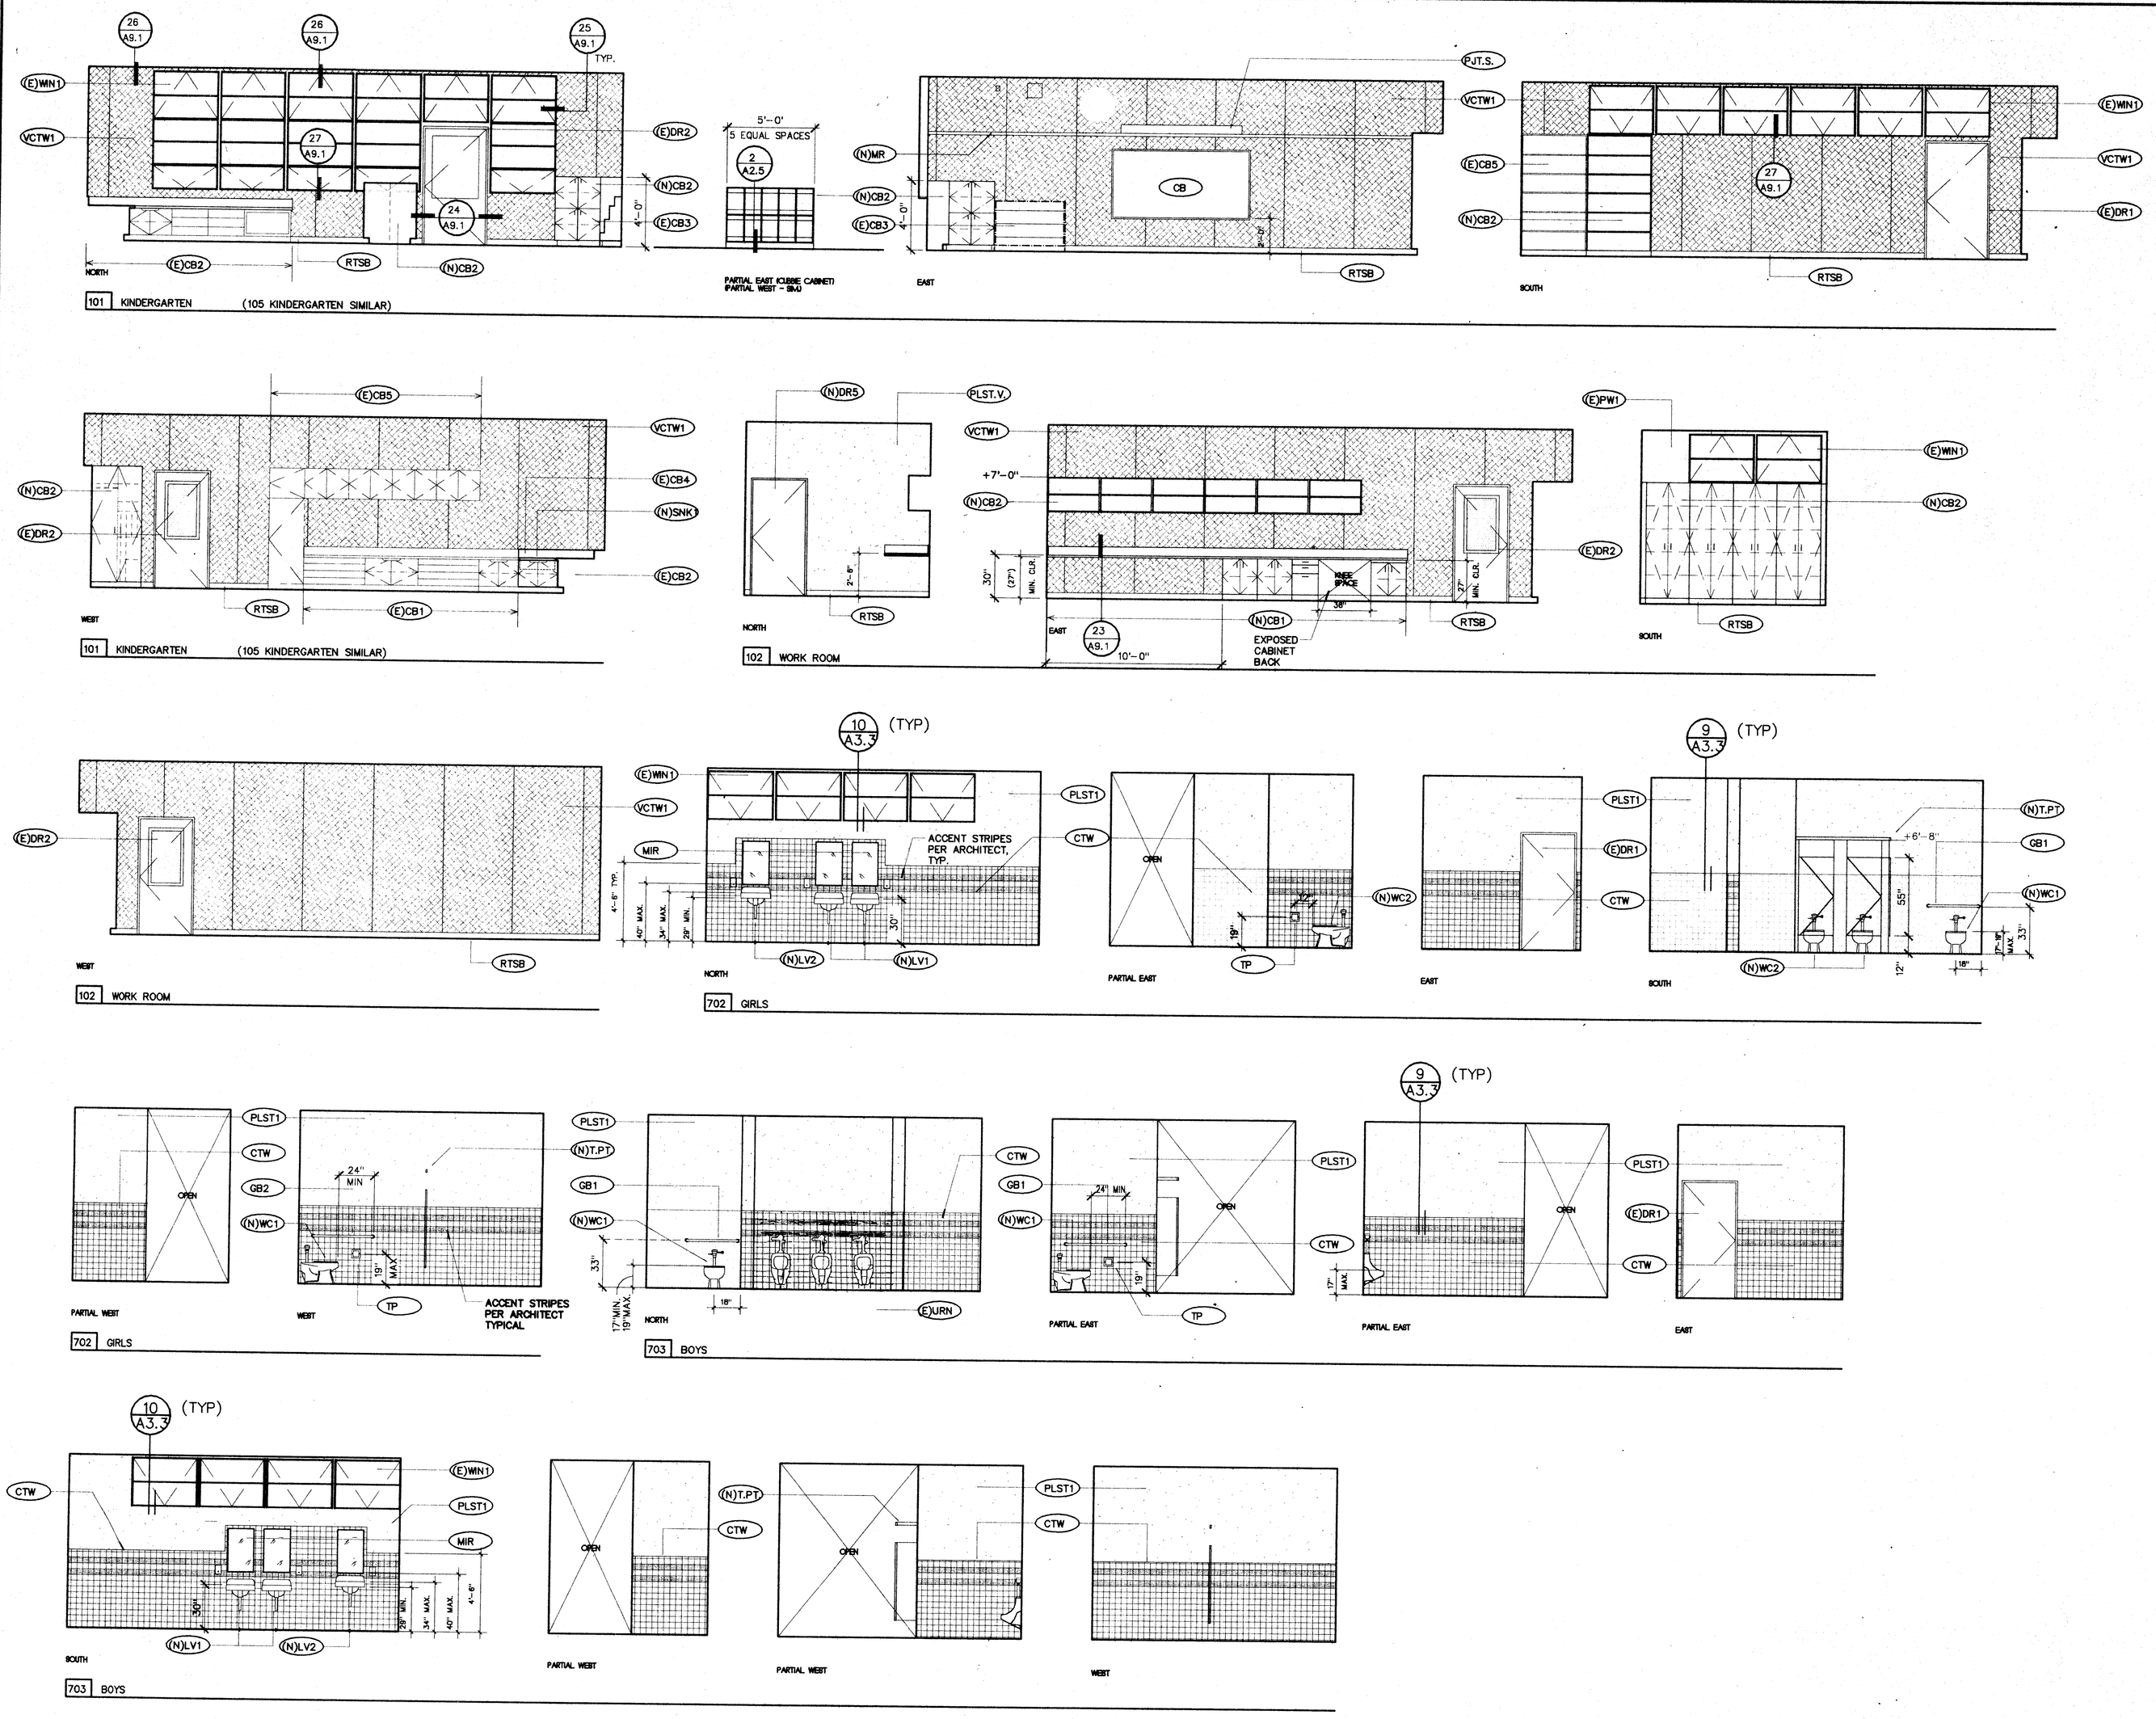

KEY NOTES
THIS SHEET ONLY

(N)W1	NEW 2x WALL SEE FLOOR PLAN & FINISH SCHEDULE.
(N)RA	NEW OPENING FOR RETURN AIR DUCT SEE MECH. PLANS–PATCH WALL MATCH EXISTING FINISHES.
(E)RA	EXISTING RETURN AIR GRILL TO REMAIN–PREP & PAINT.
RTSB	RUBBER TOP SET BASE
CB	NEW 4'x8' CHALK BOARD.
MB	NEW 4'x8' MARKER BOARD.
PJT.S.	NEW WALL MOUNT PROJECTER SCREEN.
(E)CB1	EXISTING CABINETS TO REMAIN–REMOVE HARDWARE, PREP SURFACE, PAINT REINSTALL HARDWARE, EXISTING COUNTERTOPS TO REMAIN.
(E)CB2	EXISTING CABINETS TO REMAIN, REMOVE HARDWARE, PREP SURFACE, PAINT, REINSTALL HARDWARE–PROVIDE/INSTALL NEW PLASTIC LAMINATE COUNTERTOPS WITH 6" SPLASH.
(E)CB3	EXISTING MAGAZINE RACK CABINET RELOCATED TO EAST WALL OF CLASS-ROOM.
(E)CB4	MODIFY EXISTING CABINET TO PROVIDE H.C. ACCESSIBLE KNEE SPACE–PROVIDE REMOVABLE TOE & BASE, RETURN FLOORING TO BACK WALL–PROVIDE/ INSTALL NEW COUNTERTOP & SINK.
(E)CB5	EXISTING CABINET TO REMAIN, REMOVE HARDWARE–PREP SURFACE–PAINT, REINSTALL HARDWARE.(WHERE OCCURS)
(N)CB1	NEW LAMINATE PLASTIC BASE CABINET WITH 6" SPLASH–SEE CABINET SCHEDULE.
(N)CB2	NEW LAMINATE PLASTIC CABINET–SEE CABINET SCHED.
(E)PW1	EXISTING PLYWOOD TO REMAIN–PREP & PAINT.
PLST.V.	1/2" GYP. BOARD WITH 1/8" VENEER PLASTER–PAINT.
VCTW1	1/2" VINYL COVERED TACKABLE WALLBOARD WITH COLOR MATCHING J-MOLD TRIM OVER EXISTING PLYWOOD.
VCTW2	1/2" VINYL COVERED TACKABLE WALLBOARD WITH COLOR MATCHING J-MOLD TRIM OVER NEW 1/2" GYP. BOARD.
PLST1	KEENES CEMENT PLASTER OVER METAL LATH. (DEMO EXISTING PLYWOOD AT WALLS FOR INSTALLATION OF PLASTER SURFACE.)
C.T.W.	MUD SET CERAMIC TILE WAINSCOT WITH INTERGAL COVE BASE (DEMO EXISTING PLYWOOD AT WALLS FOR INSTALLATION OF TILE WAINSCOT.)
(E)WIN1	EXISTING WINDOWS TO REMAIN–PREP & PAINT FRAMES & TRIM.
(E)DR1	EXISTING DOOR & FRAME TO REMAIN–PREP & PAINT.
(E)DR2	EXISTING DOOR & FRAME TO REMAIN RE-PLACE EXISTING HARDWARE WITH H.C. ACCESSIBLE HARDWARE–PREP & PAINT DOOR & FRAME.
(N)DR5	NEW DOOR & FRAME. ENLARGE OPENING, PATCH WALL–MATCH EXISTING FINISHES.
(N)LV1	NEW LAVATORY–SEE PLUMBING PLANS.
(N)LV2	NEW H.C. ACCESSIBLE LAVATORY–SEE PLUMBING PLANS.
(N)SNK1	NEW H.C. ACCESSIBLE SINK IN NEW COUNTERTOP–SEE PLUMBING PLANS.
(N)WC1	PROVIDE/INSTALL H.C. ACCESSIBLE WATER CLOSET–CONNECT TO EXISTING PLUMBING LINES–(WHERE OCCURS) MOUNT FLUSH VALVE LEVER ON OPEN SIDE OF TOILET–SEE PLUMBING PLANS.
(N)WC2	PROVIDE/INSTALL NEW WATER CLOSET CONNECT @ EXISTING PLUMBING LINES–SEE PLUMBINGS PLANS.
(E)URN	EXISTING URINAL TO REMAIN–REPLACE FLUSH VALVE–SEE PLUMBING PLAN.
GB1	36" GRAB BAR–MOUNT @ 2'–9"
GB2	42" GRAB BAR–MOUNT @ 2'–9"
MIR	PROVIDE/INSTALL NEW MIRROR–MOUNT @ +40" @ BOTTOM.
TP	PROVIDE/INSTALL NEW TOILET PAPER DISPENSER.
PT	PROVIDE/INSTALL NEW PAPER TOWEL DISPENSER–MOUNT @ +40" @ BOTTOM.
(N)T.PT.	PROVIDE/INSTALL NEW SOLID PLASTIC TOILET PARTITIONS.
(N)MR	NEW 2" ALUMINUM MAP RAIL–SEE SPECS.
PLST 1	1/2" FIBER REINFORCED GYPSUM PANELS (L.P. FIBERBOND) WITH 1/8" VENEER PLASTER, AND PAINT.

INTERIOR ELEVATIONS – UNITS 100, 700

SEE ELECTRICAL PLANS FOR OUTLET / DEVICE LOCATIONS

1/4"

ORDIZ MELBY ARCHITECTS INC.

5620 DISTRICT BLVD. #105
BAKERSFIELD, CA. 93313
TEL. (805)-832-5258
FAX. (805)-832-4291

LICENSED ARCHITECT WILLIAM JOHN MELBY No. C-16835 DEC. 31 1999 RENEWAL DATE STATE OF CALIFORNIA

DANNY E. ORDIZ A.I.A. ARCHITECT C-14,728

WILLIAM J. MELBY A.I.A. ARCHITECT C-16,835

IDENTIFICATION STAMP
DIV. OF STATE ARCHITECT
OFFICE OF REGULATIONS SERVICES

APPL. 101484

A.C. EK. F.L.S. S.S. MC

DATE 1-18-1999

AS BUILT DRAWINGS

MODERNIZATION OF COLLEGE HEIGHTS ELEM. SCHOOL FOR:

BAKERSFIELD CITY SCHOOL DISTRICT

2551 SUNNY LN.
BAKERSFIELD,
CALIFORNIA
93305

CHECK AND VERIFY ALL DIMENSIONS BEFORE PROCEEDING WITH THE WORK. REPORT DISCREPANCIES TO THE ARCHITECT

MARK	DATE	REVISION

INTERIOR ELEVATIONS
UNITS. 100, 700

JOB NUMBER 97140
DATE 1/6/99
DRAWN BY M.K.B.

A SHEET 5.1 OF 20