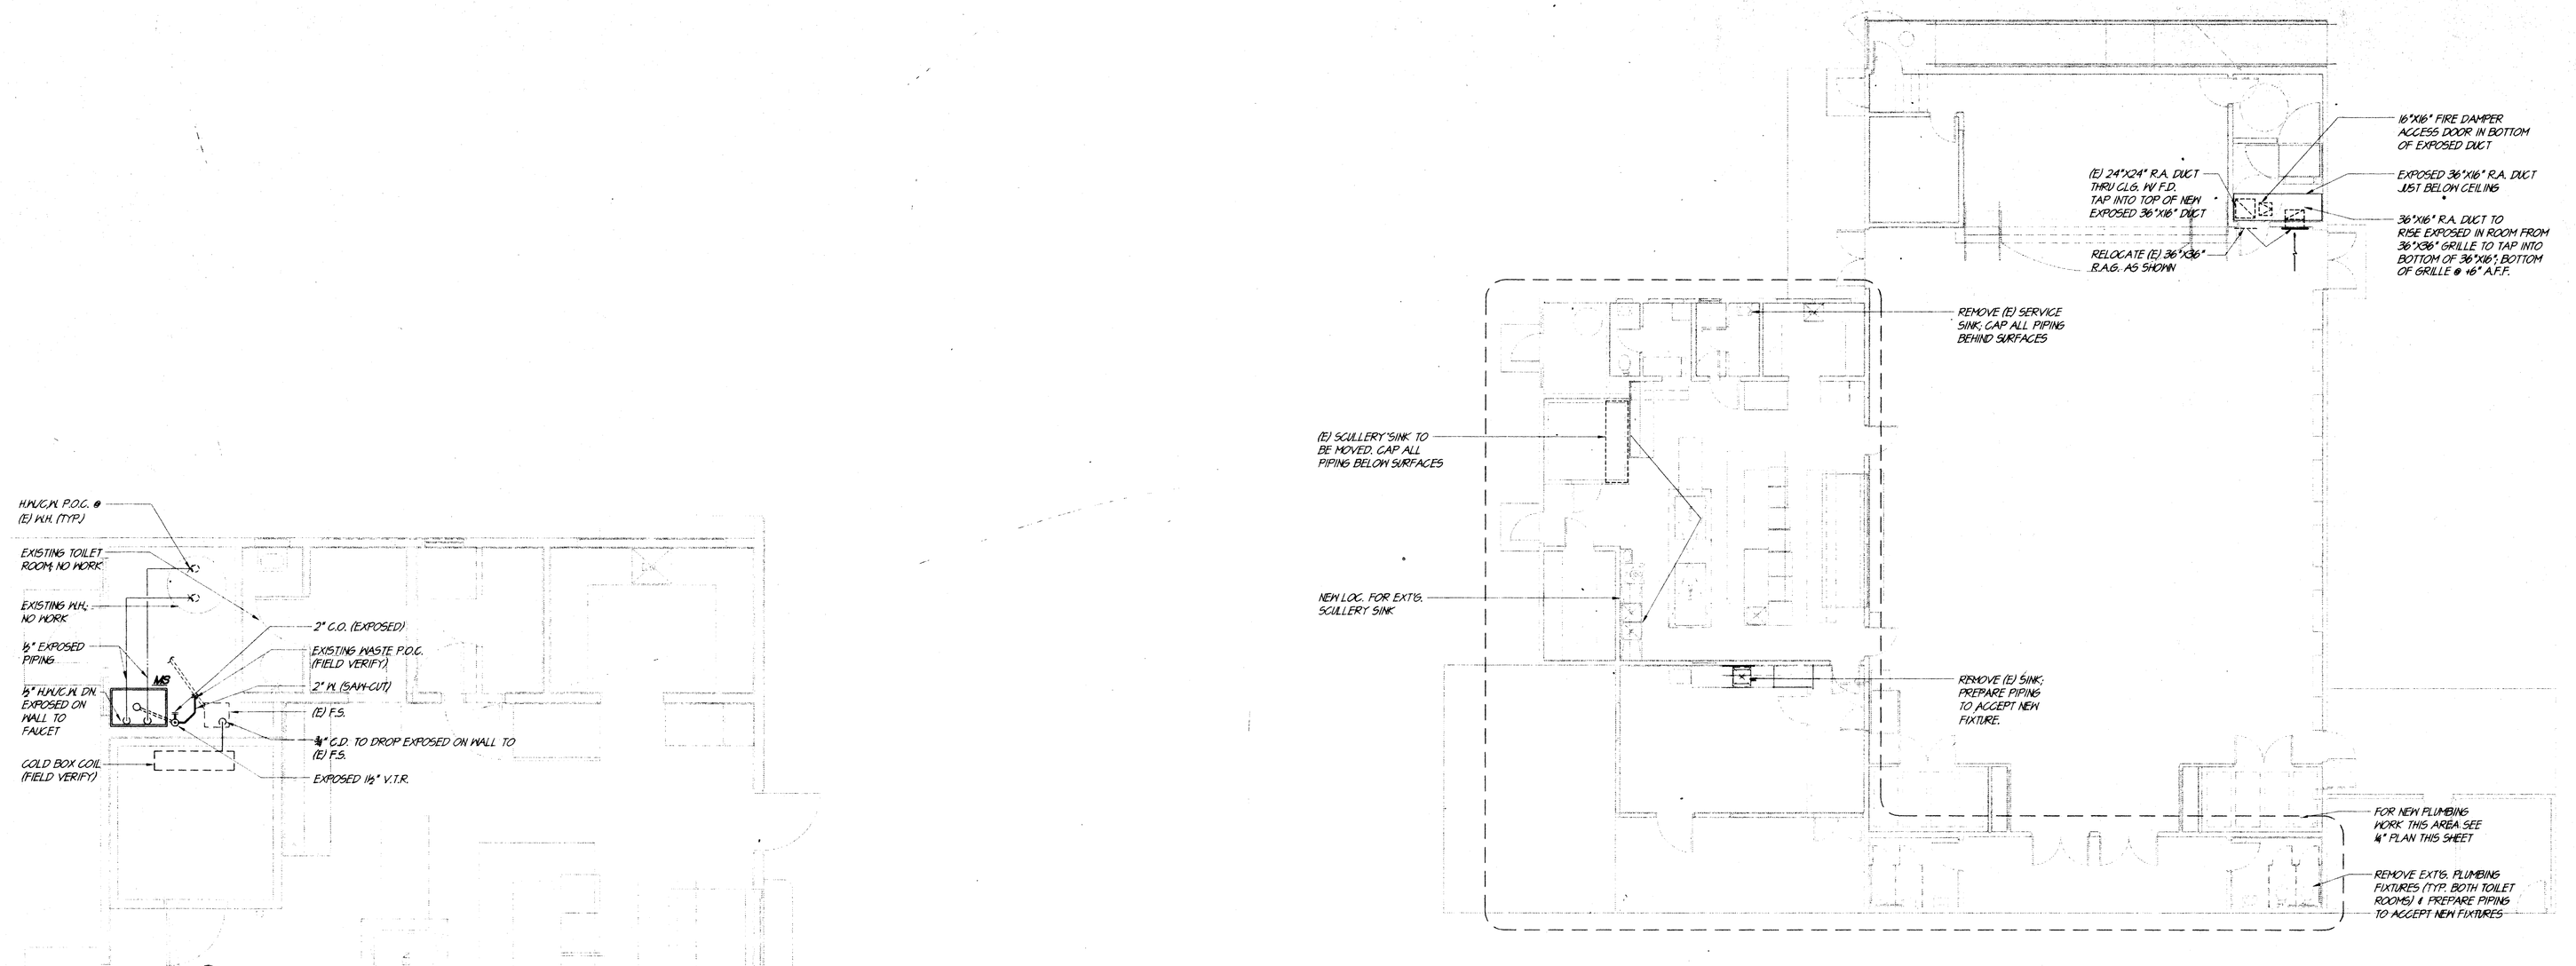

BLDG. 400 DEMO. AND MECHANICAL FLOOR PLAN

SCALE: 1/8"=1'-0"

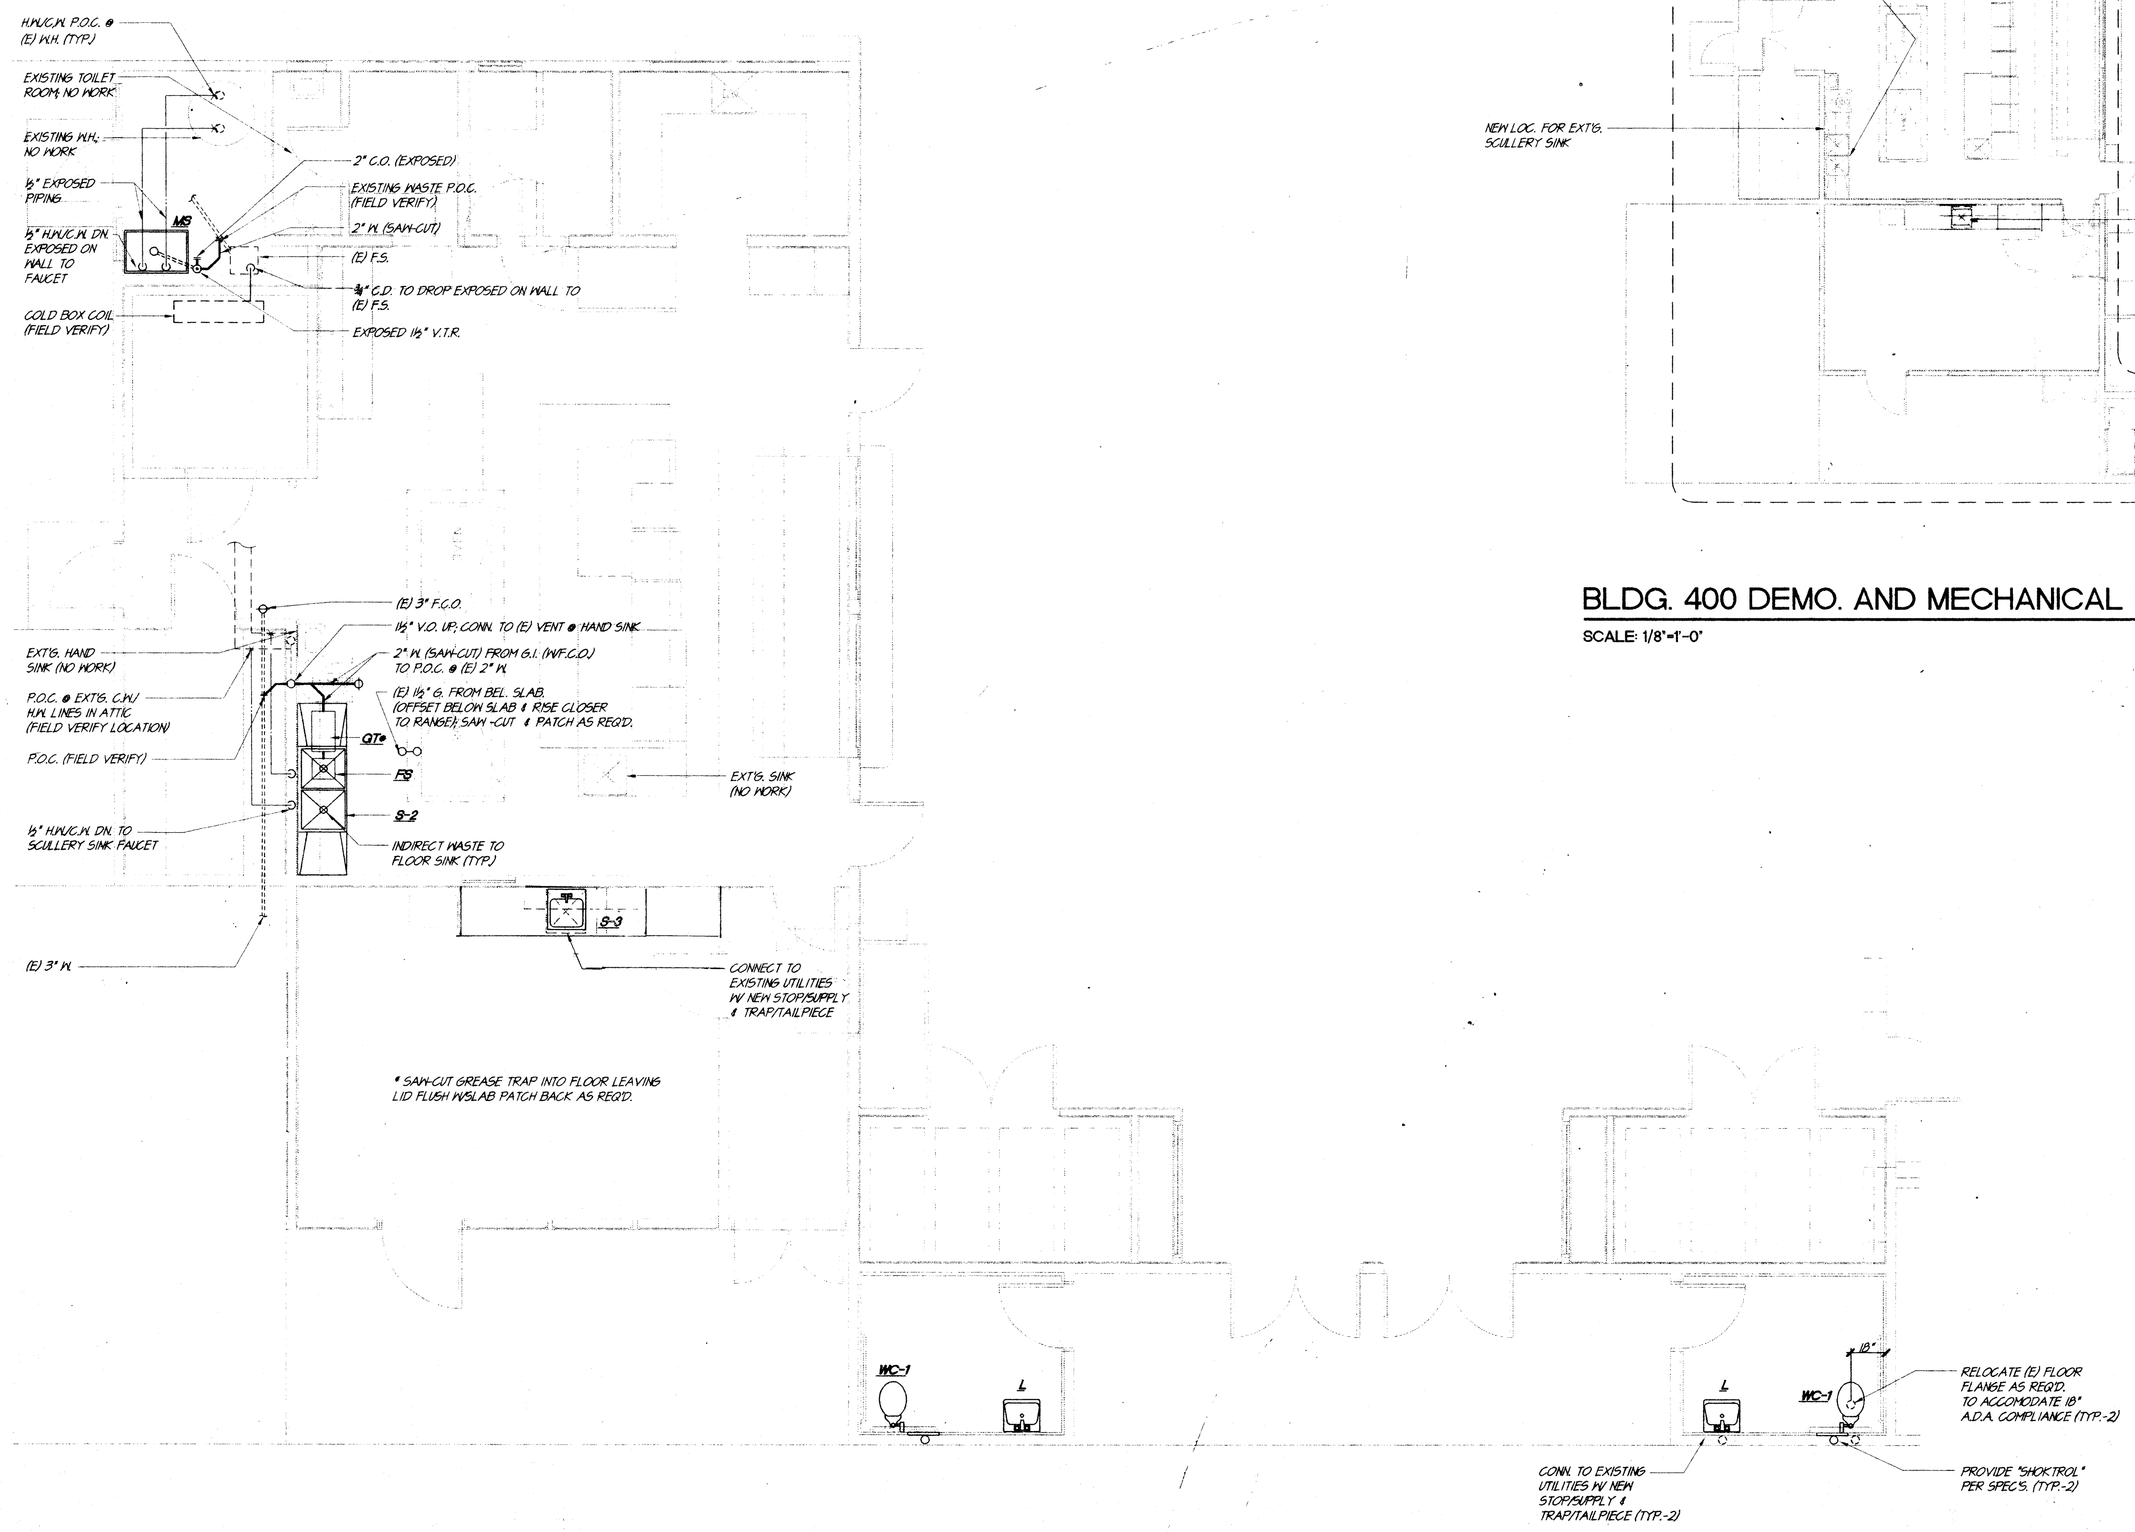

BLDG. 400 PLB'G. FLOOR PLAN

SCALE: 1/8"=1'-0"

ORDIZ MELBY
ARCHITECTS INC.

5620 DISTRICT BLVD. #105
BAKERSFIELD, CA. 93313
TEL. (805)-832-5258
FAX. (805)-832-4291

ICENSED ARCHITECT WILLIAM JOHN MELBY No. C-16835 12-31-99 STATE OF CALIFORNIA

DANNY E. ORDIZ A.I.A.
ARCHITECT C-14,728

WILLIAM J. MELBY A.I.A.
ARCHITECT C-16,835

IDENTIFICATION STAMP
DIV. OF STATE ARCHITECT
OFFICE OF REGULATIONS SERVICES
APPL. 101484
A.C. F.K. F.L.S. S.S. MC
DATE 1-13-1999

AS BUILT DRAWINGS

MODERNIZATION OF COLLEGE HEIGHTS ELEM. SCHOOL FOR:

BAKERSFIELD CITY SCHOOL DISTRICT

2551 SUNNY LN.
BAKERSFIELD, CALIFORNIA
93305

CHECK AND VERIFY ALL DIMENSIONS BEFORE PROCEEDING WITH THE WORK REPORT DISCREPANCIES TO THE ARCHITECT

MARK	DATE	REVISION

REGISTERED PROFESSIONAL ENGINEER MARK JAMES BASH No. M26578 Exp. 9-30-02 MECHANICAL STATE OF CALIFORNIA

PLUMBING FLOOR PLAN (BLDG. 400)

JOB NUMBER 97140
DATE 1/6/99
DRAWN BY N.O./R.B.
MP SHEET 2.1 OF 3

MDC MECHANICAL DESIGN CONCEPTS
#2831 MECHANICAL ENGINEERING SERVICES
428 Truxtun Avenue Bakersfield, Ca. 93301
Tel # (805) 326-1313 Fax # (805) 326-1069
PLOTTED: 6-30-98