DOOR SCHEDULE

DOORS							FRAMES					
DOOR NUMBER	FRAME OPENING SIZE	MATERIAL	TYPE	FIRE RATING	HARDWARE SET NO.	QUANTITY	MATERIAL	HEAD DETAIL	JAMB DETAIL	SILL DETAIL	JAMB THROAT	NOTE NO.
1	3'-0" X 6'-8"	HM	A	NA	1		HM	7/A6.0	8/A6.0	1/A6.0	5-1/8"	
~~2~~	~~3'-0" X 6'-8"~~	~~SCL~~	~~A~~	~~NA~~			~~HM~~	~~7/A6.0~~	~~8/A6.0~~	~~1/A6.0~~	~~5-1/8"~~	

HM – HOLLOW METAL
AL – ALUMINUM
SST – STAINLESS STEEL
STL – STEEL
WWF – WINDOW WALL FRAME
SC – SOLID CORE WOOD
HC – HOLLOW CORE WOOD
SCL – SOLID CORE WOOD W/LAMINATED PLASTIC FACES

DOOR ELEVATIONS

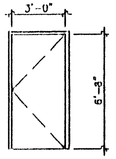

TYPE A

DOOR NOTES

1. DOOR HANDLES FOR LOCKSETS TO BE CENTERED @ 38" AFF & DEADBOLTS @ 44" AFF.
2. HARDWARE TO BE OPENABLE FROM THE INSIDE WITHOUT ANY SPECIAL KNOWLEDGE OR EFFORT. LEVERS TO RETURN TO WITHIN 1/2" OF DOOR.
3. ALL DOORS SHALL BE 1-3/4" THICK UNO
4. DOUBLE LETTERS IN SCHEDULE, INDICATES A PAIR OF DOORS.
5. SAFETY GLASS, CLEAR
6. WIRE GLASS
7. UNDERCUT DOOR
8. FIXED LOUVER
9. FUSIBLE LINK LOUVER
10. VISION PANEL
11. CLOSURE SHALL BE SET FOR MAXIMUM OPENING PRESSURE OF 8.5 LBS @ EXTERIOR DOORS AND 5.0 LBS @ INTERIOR DOORS.

HARDWARE SCHEDULE

HARDWARE SET #1

LOCKSET	– SCHLAGE D70PD, RHODES LEVER, OR EQUAL
BUTTS	– 1-1/2 PAIR HAGER 1279 BB 4-1/2 x 4-1/2 NRP 26D OR EQUAL.
CLOSER	– NORTON 8500 DA / LCN 1460 OR EQUAL.
THRESHOLD	– PEMCO 271A OR EQUAL.
DOOR BOTTOM	– PEMCO 216AV OR EQUAL.
WEATHERSTRIP	– PEMCO 299AV OR EQUAL.
DOOR STOP	– QUALITY #44 OR EQUAL

HARDWARE SET #2 (INTERIOR TOILET ROOM / PRIVACY)

LOCKSET	– SCHLAGE D40S OR EQUAL
BUTTS	– 1-1/2 PAIR HAGER 1279 4-1/2 x 4-1/2 26D

WINDOW SCHEDULE

AMT.	TYPE	WIDTH	HEIGHT	FINISH	WIN. NO.	GLASS TYPE
2	1	8'-0"	4'-0"	ANODIZED	A	7/32" MIN, SOLAR GRAY 46%, SINGLE GLAZE

WINDOW ELEVATIONS

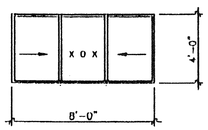

TYPE 1

WINDOW NOTES

1. 8040 XOX ANODIZED ALUMINUM GLAZING: EXTERIOR LITE 3/16" MIN. TEMPERED GLASS OF SOLAR GRAY WITH A LITE TRANSMISSION FACTOR OF 46%. 1/4" ALUMINUM SPACER. INTERIOR LITE – 1/8 MIN. CLEAR TEMPERED. ALL OPERABLE SASH SHALL HAVE ALUMINUM SSCREENS.

ACCESSIBILITY SIGNAGE (BY DISTRICT)

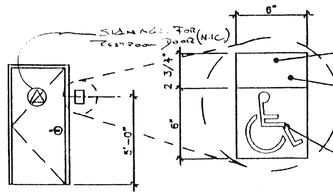

ROOM ID SIGN 1" WHITE LETTERING (HELVITICA)

CONTRACTED GRADE 2 BRAILLE DOTS-1/10" OC, WITHIN CELL, 2/10" BTTN CELLS, SHALL BE RAISED A MIN. OF 1/40"

INTERNATIONAL SYMBOL OF ACCESSIBILITY

ENTRY DOOR FROM EXTERIOR VIEW

ROOM FINISH SCHEDULE

ROOM NUMBER	ROOM NAME	FINISHES								REMARKS
		FLOOR	BASE	WALLS				CEILING	CEILING HEIGHT	
				FRONT	LEFT	REAR	RIGHT			
1	CLASSROOM	A	D	F	F	F	F	L	8'-6"	SEE SIGNAGE
~~102~~	~~CLASSROOM~~	~~A~~	~~D~~	~~F~~	~~F~~	~~F~~	~~F~~	~~L~~	~~8'-6"~~	
~~103~~	~~CLASSROOM~~	~~A~~	~~D~~	~~F~~	~~F~~	~~F~~	~~F~~	~~L~~	~~8'-6"~~	

A – CARPET PER STATE OF CALIF SPEC 7220-51E-04 COMPLYING WITH GROUP 1, TYPE A OR TYPE B, CLASS 2, DENSITY 4600, DIRECT GLUE DOWN WITH 4" TOPSET BASE.
B – RESILLENT – SPECIFY OR EQUAL
C – VCT – ARMSTRONG STANDARD OR EXCELON
D – 4" BURKE
E – 6" BRIGANTINE OR SANDOVAL
F – 1/2" VINYL TACKBOARD CLASS-1 OVER 1/2" GYP. BOARD BACKING
G – 1/2" W.R. GYP. BOARD TAPE TEXTURE WITH PAINTED FINISH
H – 3/8" W.R. GYP. BOARD TAPE TEXTURE WITH PAINTED FINISH
I – 1/2" GYP. BOARD TAPE TEXTURE PAINTED WITH PAINTED FINISH
J – 3/8" GYP. BOARD TAPE TEXTURE PAINTED WITH PAINTED FINISH
K – 1/2" MARLITE OVER 1/2" W.R. GYP. BOARD
L – ACCOUSTICAL LAY IN GRID CEILING PANELS (SEE SPECIFICATIONS)

FINISH NOTES

1. SUB-FLOOR PREP:

PREPARATION FOR SUB FLOOR TO ACCEPT FINISH FLOORING IS BY FLOORING CONTRACTOR. PLYWOOD SUB FLOOR IS 2.4.1 PLYWOOD. OUTER PLY IS PLUGGED AND TOUCH SANDED, ANY DEFORMATIES DUE TO STANDARD CONSTRUCTION PRACTICES SHALL BE FILLED AND SANDED BY FLOORING CONTRACTER. THE JOINT AT THE MODULEJOINING SHALL NOT BE LARGER THAN 1/8" AND SHALL BE FILLED AND SANDED BY FLOORING CONTRACTOR.

ACCESSIBILITY SIGNAGE (AS REQUIRED - BY MODTECH)

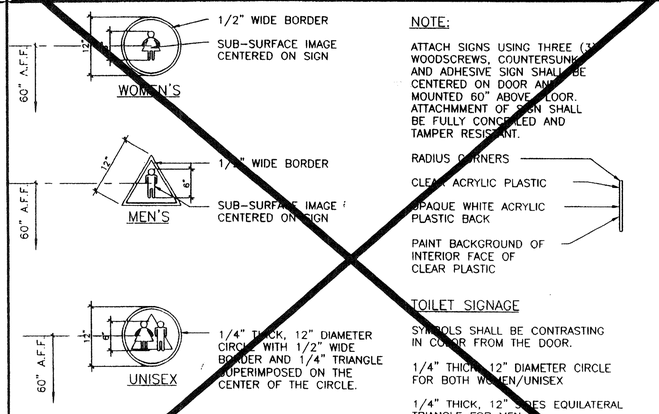

NOTES

1. ALL FINISHES SHALL COMPLY WITH C.B.C. CHAPTERS 3,6,7,8, & 10 & C.F.C. & TITLE 19 C.C.R.
2. FOR DOOR AND DOOR FRAME DATA SEE SPECIFICATIONS ON SHEET A8.0.

REVISED JUL 1 1999
04 101527
MAY 20 1999
IDENTIFICATION STAMP DIV. OF THE STATE ARCHITECT OFFICE OF REGULATION SERVICES
04 101527
DATE SEP 02 1999

FILE PATH:

REVISIONS

1			
2			
3			
4			
5			

Electrical Engineer's Seal

Mechanical Engineer's Seal

Structural Engineer's Seal
REGISTERED PROFESSIONAL ENGINEER
S. V. MISHRA
No. 53913
Exp. 06/30/99
STRUCTURAL
STATE OF CALIFORNIA
02-08-99

Architects Seal

Division of the State Architect
REVISED
IDENTIFICATION STAMP
DIV. OF THE STATE ARCHITECT
OFFICE OF REGULATION SERVICES
PC-270
DATE FEB 17 1999

MODTECH INC.
2830 BARRETT AVENUE
PERRIS, CALIF. 92572
PH (909) 943-4014
FAX (909) 940-0427

PROJECT NUMBER:

© MODTECH, INC. 1998

SCHEDULE SHEET

DRAWN BY: RVF
DATE: 2-2-99
CHECKED BY: SM
DATE:
MODTECH PROJECT NO:

MODTECH Index No.

A5.0

PROJECT NO.

PC-270